LOT 11

LOT 12

HOOVER CT.

60'

Scale:
Plan - 1"= 20'
Profile - Hor. 1"= 20'
Ver. 1"= 5'

(2)

Building
(Under Construction)

Rear Lot

Proposed Parking Lot

Sta. 0+70, Line 2, Install Plug in End of 8" Pipe

Sta. 0+084 - Line 1 :
Sta 0+00 - Line 2
Const. Std. Type "A" or "C" Manhole

Sta. 1+29, Line 1, Install Plug in End of 8" Pipe

Existing Service Line Stub

1.5%

Proposed Sidewalk

10'

20'

5' Sewer Easement

LINE 2

LINE 1

POST

Contractor to verify if Underground Electric Line is in place.

70.6'

Exist. 42" San. Sewer

Dirt Drive

335' R

Property Line

Iron

Iron Pipe

Sta. 0+00 - Connect to Existing Sanitary Sewer Manhole See Attached Detail Sheet For Exist. Manhole Information.

60' R/W

30'

Exist. 30"

20'x 28" MACP

30' Sewer Easement Case C-17850

℄ HOOVER ROAD

Exist. Apron

B.M. - City disc 48'E. & 5'S
℄ Hoover & May
El. 110.57

115
110
105
100
95

Ex. Ground

Lex. Ground

101 L.F. 8" VCP @ 0.6%

71 L.F. 8" VCP @ 1.03%

120 L.F. 8" VCP @ 1.06%

Plug

Plug

Jane 104

LINE 2

LINE 1

0+50 0+00 0+00 0+50 1+00

PLAT 1 - PLAN - PROFILE - F. A. S.
CLEARPRINT PAPER CO. S. F. CAL.
NO. 1000H-1

PLAN
DATE
BY
REV
UNDERGROUND UTILITIES
NOTE BOOK
ATTENTION: CITY, STATE & PRIVATE UTILITIES

PROFILE
DATE
BY
REV
UNDERGROUND UTILITIES
NOTE BOOK
ATTENTION: CITY, STATE & PRIVATE UTILITIES
NO.
BACK FILL COMPACTED
STRUCTURE NOTATING CHECKED

GENERAL NOTES:

Contractor to verify any possible underground utilities or service lines prior to construction.

Contractor shall be responsible for preserving property irons. The Contractor shall be required to re-establish any property irons which are damaged or destroyed by his construction operations. Such irons shall be re-established by a licensed land surveyor or a professional engineer in accordance with state laws.

Contractor to note structural Tee MH. Detail information for connecting to the Existing Manhole.

1-12-82

APPROVED AS NOTED
By CITY ENGINEER OF WICHITA
Sanitary Sewers
Storm Sewers
Driveway Approaches

NOTE TO CONTRACTOR


This project will be constructed under the supervision of the CITY ENGINEER and conforming to the SPECIFICATIONS of the CITY OF WICHITA. The CONTRACTOR will prepay the City of Wichita for all costs of inspection.


PRIVATE SANITARY SEWER
TO SERVE LOT 12, BLOCK 2,
AIRPORT INDUSTRIAL PARK


CITY PROJ. NO. 468-76-245-80000-000-000-008


BAUGHMAN COMPANY, P.A.
SURVEYING & ENGINEERING
316/262-1271 • 320 LAURA • WICHITA, KANSAS 67211

FILMED FROM THE BEST AVAILABLE COPY

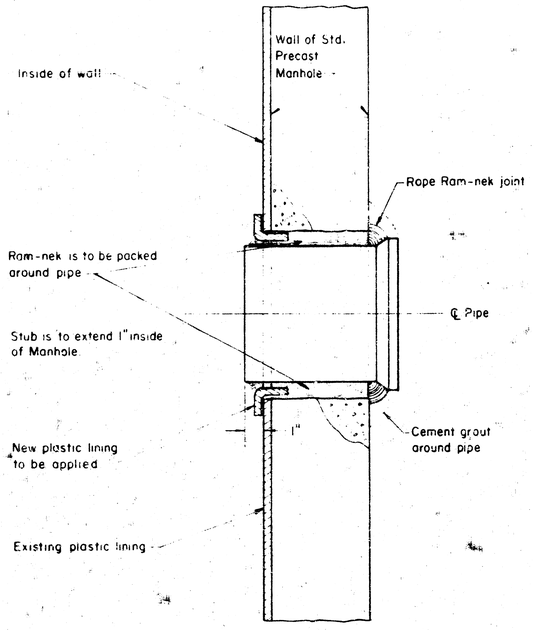

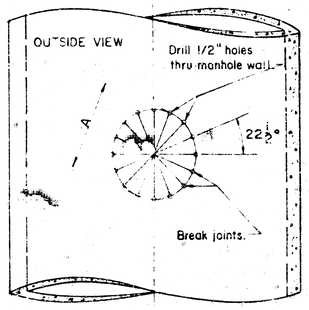

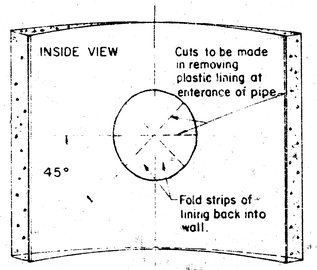

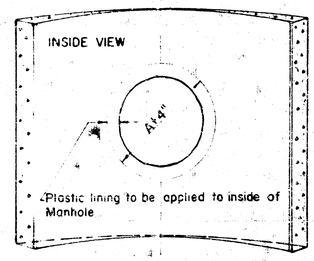

A = OUTSIDE DIAMETER OF PIPE + 2"

DRAWN Oct 1978

DETAIL OF PIPE CONNECTION
TO STRUCTURAL TEE MANHOLE

CITY OF WICHITA, KANSAS

PRIVATE SANITARY SEWER EXTENSION TO SERVE
LOT 12, BLK. 2, AIRPORT INDUSTRIAL PARK

PROJECT NUMBER: 468-76-245-80000-000-000-008

DATE: 10 8 1 10