
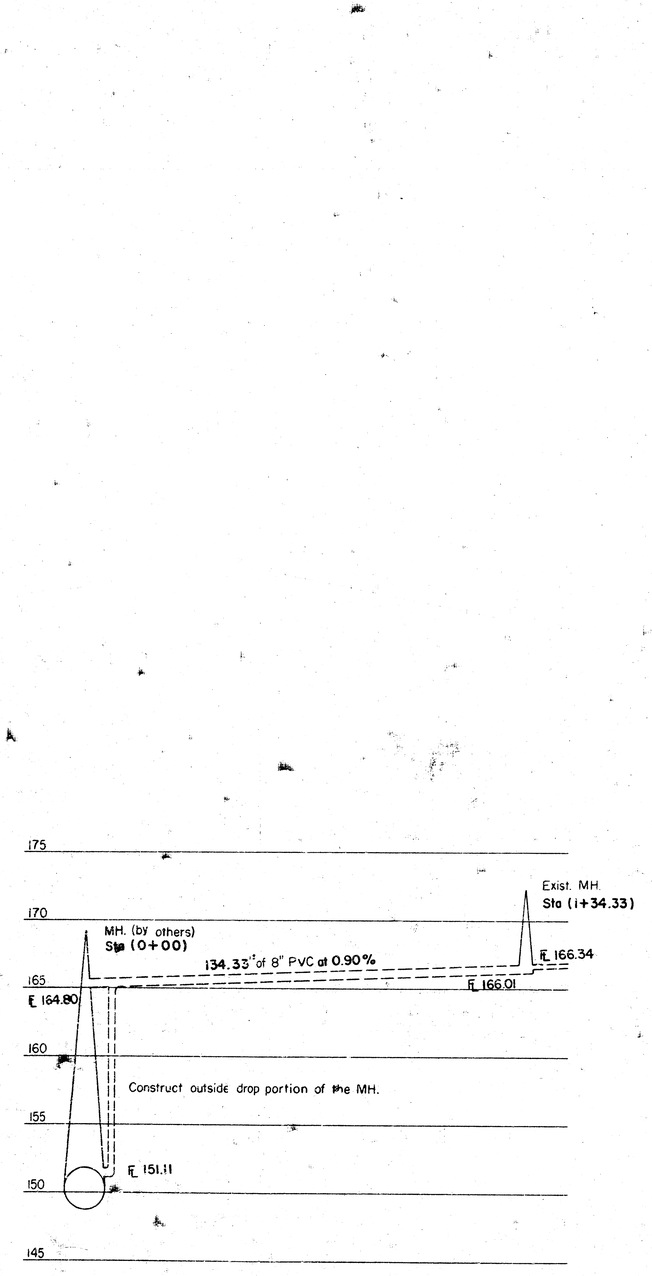


SCALE 1" = 20'

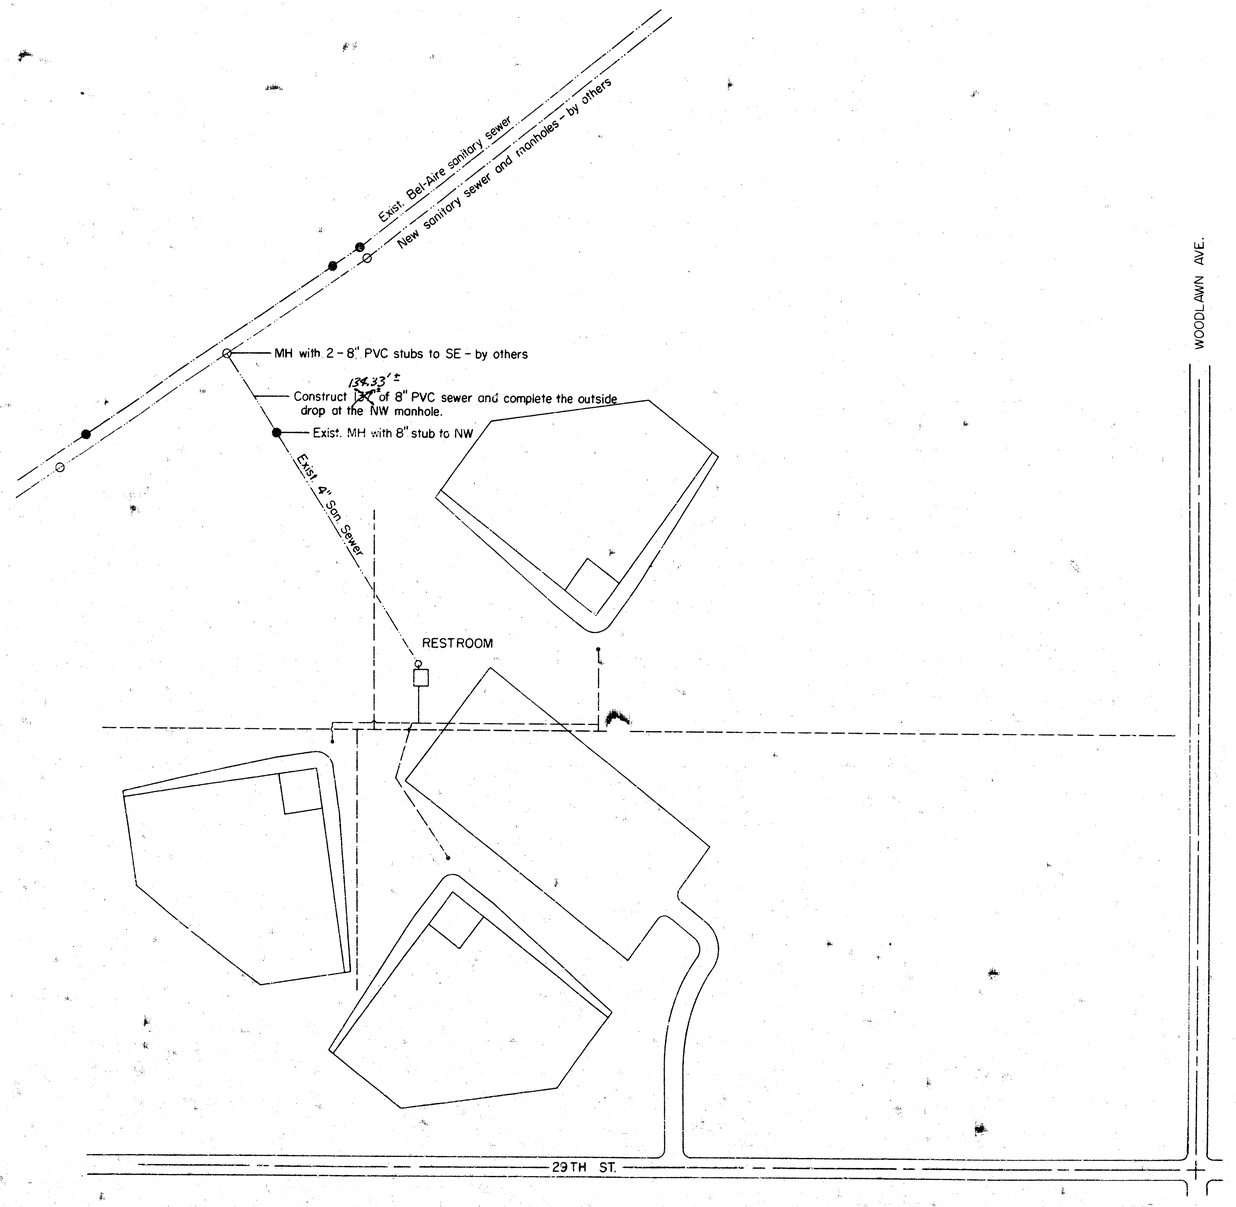

THE CONTRACTOR SHALL BE RESPONSIBLE FOR PRESERVING PROPERTY IRONS. THE CONTRACTOR SHALL BE REQUIRED TO RE-ESTABLISH ANY PROPERTY IRONS WHICH ARE DAMAGED OR DESTROYED BY HIS CONSTRUCTION OPERATIONS. SUCH IRONS SHALL BE RE-ESTABLISHED BY A LICENSED LAND SURVEYOR OR A LICENSED PROFESSIONAL ENGINEER IN ACCORDANCE WITH STATE LAWS.

NOTE TO CONTRACTOR

This project will be constructed under the supervision of the CITY ENGINEER and conforming to the SPECIFICATIONS of the CITY OF WICHITA. The CONTRACTOR will prepay the City of Wichita for all costs of inspection.

APPROVED AS NOTED
By CITY ENGINEER OF WICHITA
Sanitary Sewers 1-9-13
Storm Sewers
Driveway Approaches

NORTH

APPROVED

DIRECTOR

PARK BOARD ENGINEER

SANITARY SEWER EXTENSION

CHISHOLM CREEK PARK

BOARD OF PARK COMMISSIONERS
WICHITA, KANSAS

1/1

DATE	DRAWN BY	SCALE	SHEET OF
	MRT	1"=100'	