



NOTE TO CONTRACTOR
 THE SEWER LINE SHOWN ON THIS PLAN IS TO BE CONSTRUCTED IN ACCORDANCE WITH THE CITY OF WICHITA, KANSAS, STANDARD SPECIFICATIONS FOR SEWERAGE AND SANITATION, LATEST EDITION.

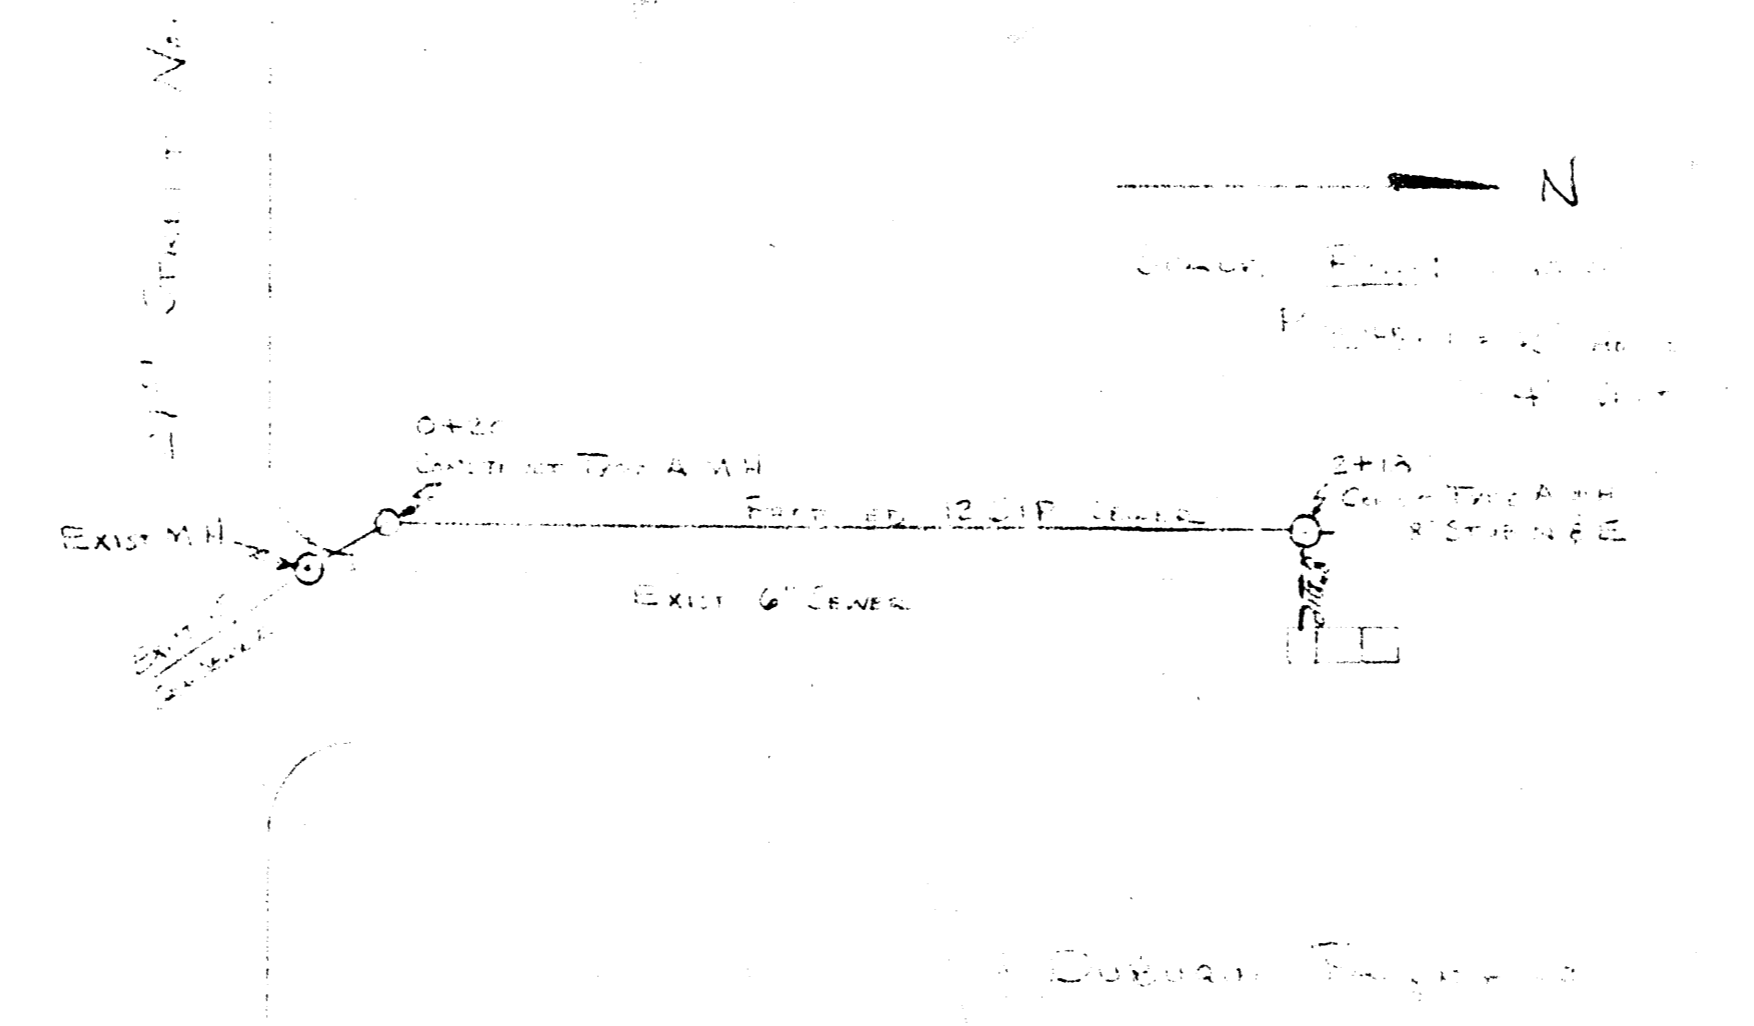

B.M. TRUSS HEAD OF MAIN ST. Elev. 100.11

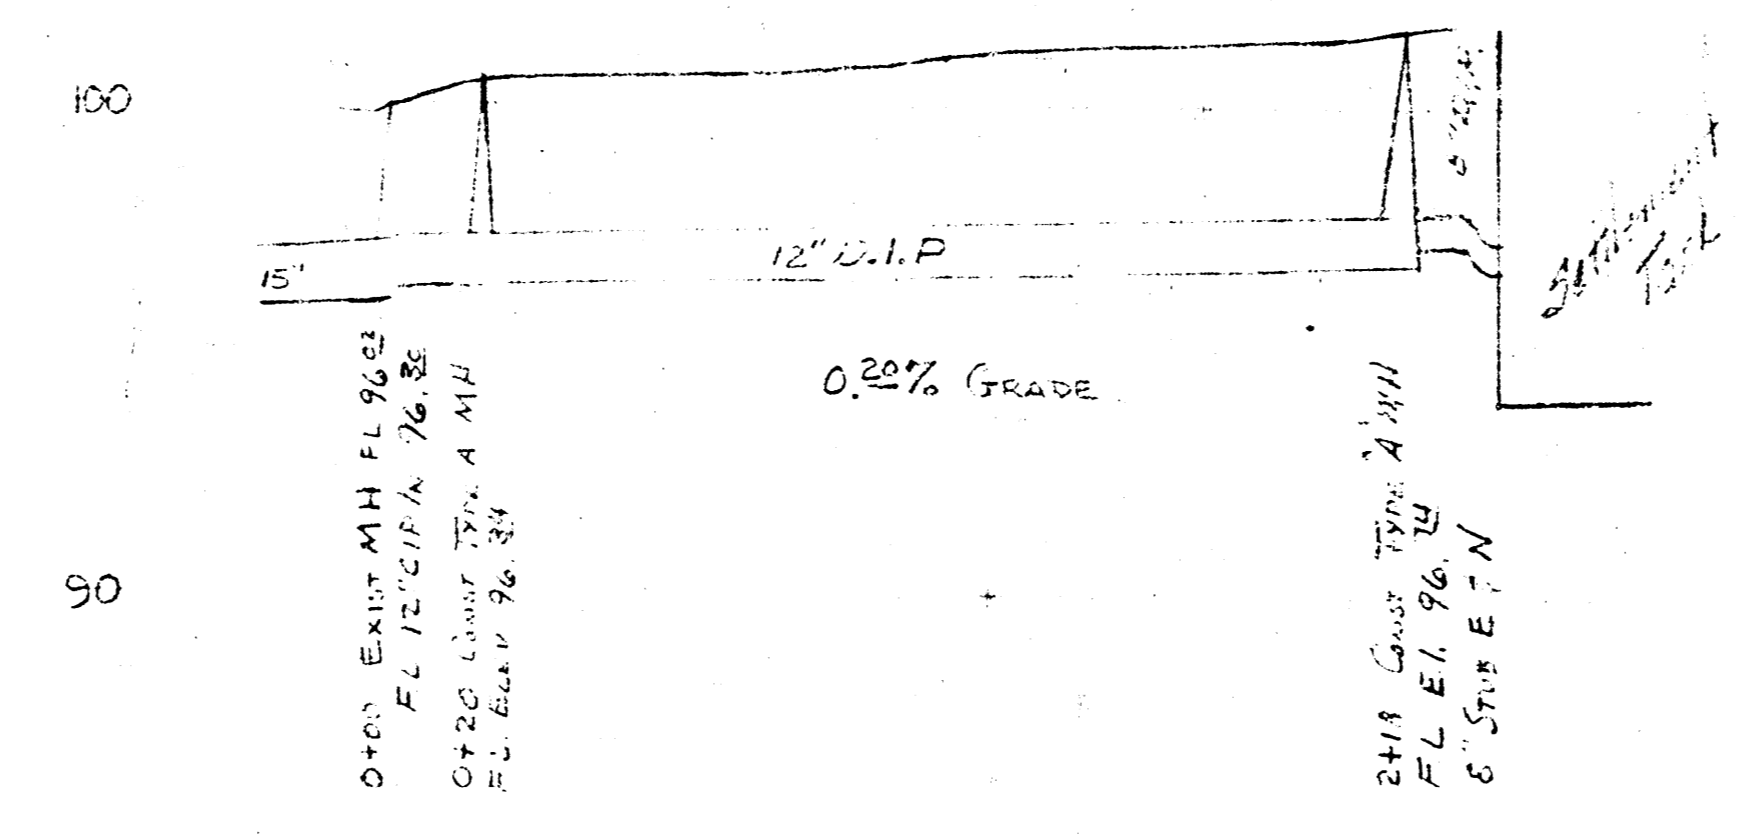

SANITARY SEWER
 FOR
 DUBUQUE PACKING CO.
 1410 E 21ST ST NORTH
 - WICHITA, KANSAS -
 JULY 1971 HCL
 HALL



ok to construct
 per city specs
 7/19/71

1 2 3 4