
BENCH MARK
ELEVATION = 1115.83 CITY DATUM
"D" CUT, AT WEST END ON TOP OF RETAINING WALL, AT THE N.E. CORNER OF LOT 32 ON MAIN IN GRIEFFENSTEINS ADD.

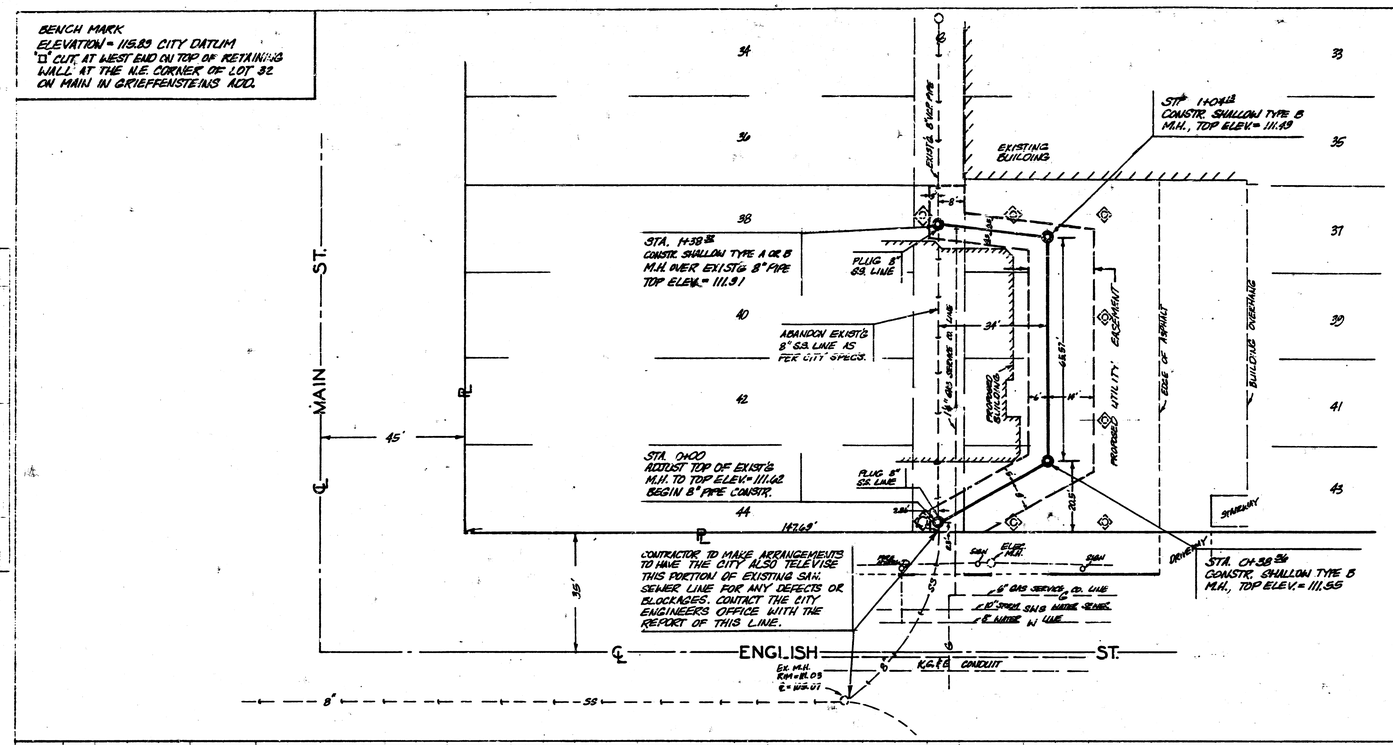

N


1"=20' PLAN
1"=20' HOR.
1"=5' VERT.

NOTES: CONTRACTOR TO VERIFY UTILITY LINES AND LOCATIONS PRIOR TO CONSTRUCTION.
- CONTRACTOR TO PROVIDE ADEQUATE ON SITE STAKING IN ORDER TO PROVIDE GOOD COMPLIANCE WITH THE MINIMAL GRADES INDICATED.
- CONTRACTOR TO MAINTAIN EXISTING SEWER SERVICE THRU OUT CONSTRUCTION.
- CONTRACTOR TO ABANDON & PLUG EXISTING SEWER LINES AS PER CITY SPECS.

APPROVED AS NOTED
By CITY ENGINEER OF WICHITA
Sanitary Sewers 2/6/86
Storm Sewers
Driveway Approaches
Water Mains
Paving

NOTE TO CONTRACTOR

This project will be constructed under the supervision of the CITY ENGINEER and conforming to the SPECIFICATIONS of the CITY OF WICHITA. The CONTRACTOR will pay the City of Wichita for all costs of plan review, inspection and bonding per contract.

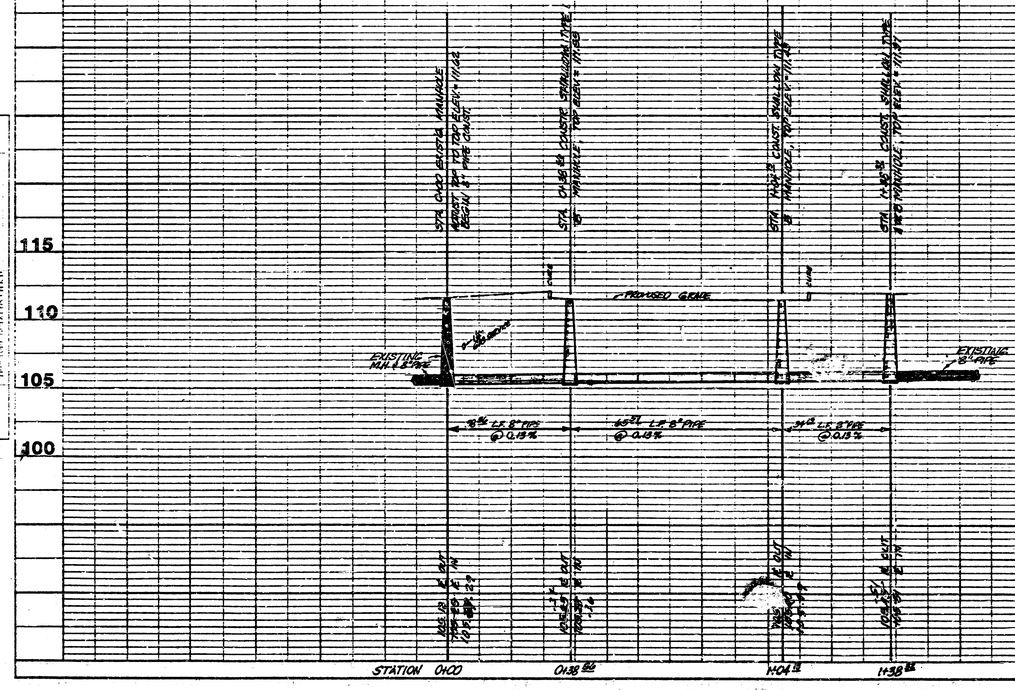

AS BUILT
4-7-86
RDC

JANUARY 1986

SANITARY SEWER EXTENSION TO SERVE FIDELITY SAVINGS AT MAIN AND ENGLISH
PROJECT NO.
468-78-245-80000=000-000-022
CITY OF WICHITA, KANSAS

BAUGHMAN COMPANY, P.A.
SURVEYING & ENGINEERING
316/268-1521 • 330 LAURA • WICHITA, KANSAS 67211

M. BRENT WOOD
9478
REGISTERED PROFESSIONAL ENGINEER

1/1

PLATE 1 - PLAN - PROFILE - F.A.S.
CLEARPRINT PAPER CO., S.F. CAL.
NO. 100CH-1

FILMED FROM THE BEST AVAILABLE COPY