SANITARY SEWER TO SERVE

LOT 1, BLOCK 2, KILLARNEY WEST RESIDENTIAL ADDITION

Project Number

1008 PPS(607861)

CITY OF WICHITA, KANSAS

Michael E. Lindebak, P. E., City Engineer

GENERAL NOTES

1. Contractor will be required to provide notice to utility companies a minimum of twenty-four (24) hours prior to any excavation, as follows:

   Kansas One-Call 687-2470

   The Contractor must notify the following in case of an emergency.

Cablevision	262-4270
or	263-2061
K.P.L. Gas Service Company	383-8650
Kansas Gas & Electric Company	383-8600
Peoples Natural Gas	942-8811
or	1-800-303-0357
Southwestern Bell Telephone Company	1-571-2611
City of Wichita Water Department	268-4908
City of Wichita Sewer Department	268-4071

2. Exist. utilities and their locations, as shown on the plans, represent the best information obtainable for design. Location information has been obtained from the various utility companies and is either from company record drawings or company-provided field locations. The Contractor will be required to work around existing utilities which do not conflict with proposed construction.

3. The Contractor to verify utility locations prior to construction of this project.

4. Utility service and installation shall be coordinated with the respective utility owners. Contacts are:

KG&E Gas	Steve Orth	261-6867
K.G. & E.	Miles Capps	261-6434
Wichita Water	Paul Bryant	268-4555
	Steve Palmer	268-4908
Southwestern Bell	Jim Tobin	268-2759


5. All areas disturbed by construction shall be seeded with rye Rebel II Fescure grass at a rate of 350 lbs./acre immediately


8. Benefits District Consist of Lot 1, Block 2, Killarney West Rasidential Addition & Lot 3, Block 1, Cornejo North Addition.

APPROVED AS NOTED BY CITY ENGINEER OF WICHITA

SANITARY SEWERS VRH 6/26/00

Inspection and testing for this project are to be provided by a Licensed Consulting Engineering Firm under contract with the Owner/Developer. Said inspection is to be in accordance with the City of Wichita standard construction engineering practices and certified by a Licensed Prof Engineer. No work shall be performed in dedicated easements or public right-of-way by the Contractor without such inspection nor shall work be commenced without written authorization by the City Engineer. All construction and materials shall comply with the City of Wichita Specifications and Standards (on file and available in the City Engineer's Office).

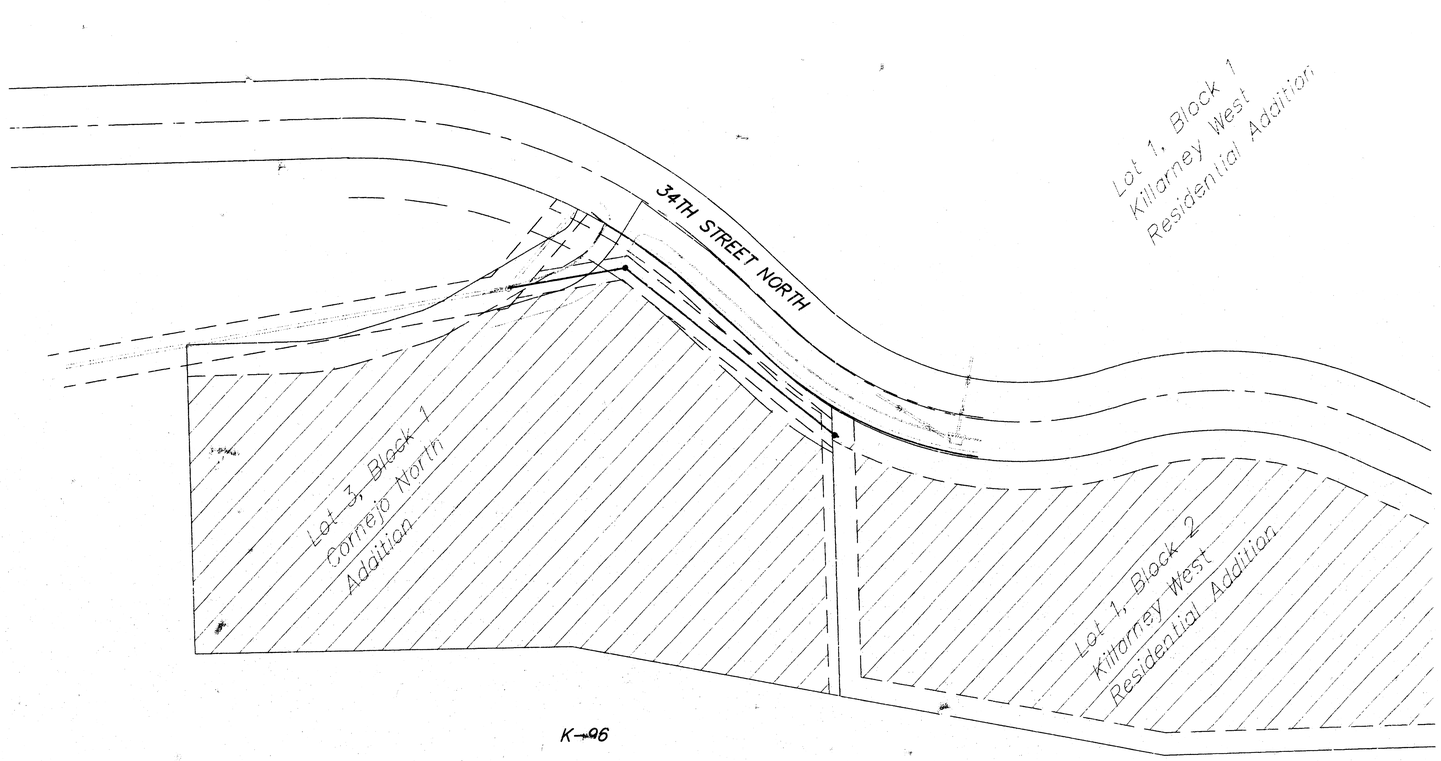

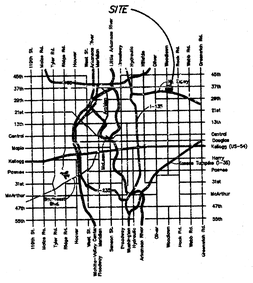

LOCATION MAP

AS-BUILT
Date: 8/29/00
Signed: Michael J. Pepe

Booked
P-146
9-18-00
RDL

SCALE
60' 0 60' 120'

BENCHMARK

Square chisled ot West end of Northwest Return, Intersection of 34th Street N. and Inwood
Elev.=197.92

City disk, on top of NE hubguard brkige, South of 34th Street North and Woodlawn.
Elev.=177.96

INDEX:


1. Title Sheet
2. Plan and Profile of Line 1


MILES CONSTRUCTION

FILENAME: E:\Projects\00117\ss1title

MILLER P.A.
ENGINEERING SERVICES
355 N. Waco, Suite 200 Wichita, KS 67202
316/262-1281 fax: 316/262-6773

© Austin Miller, P. A.

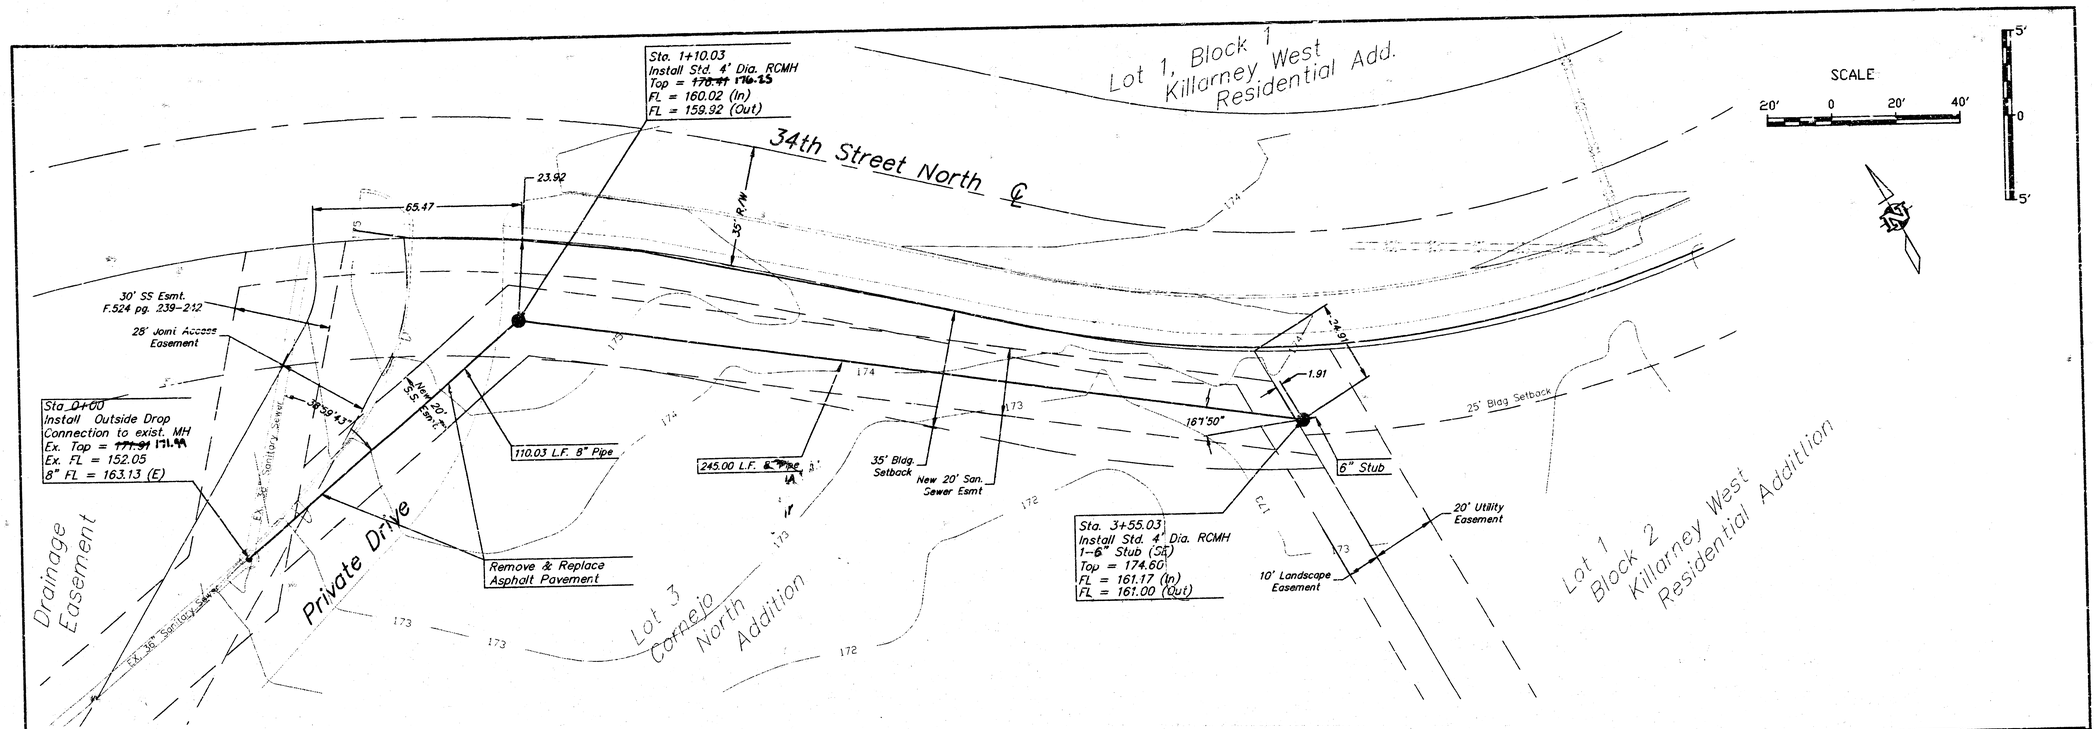

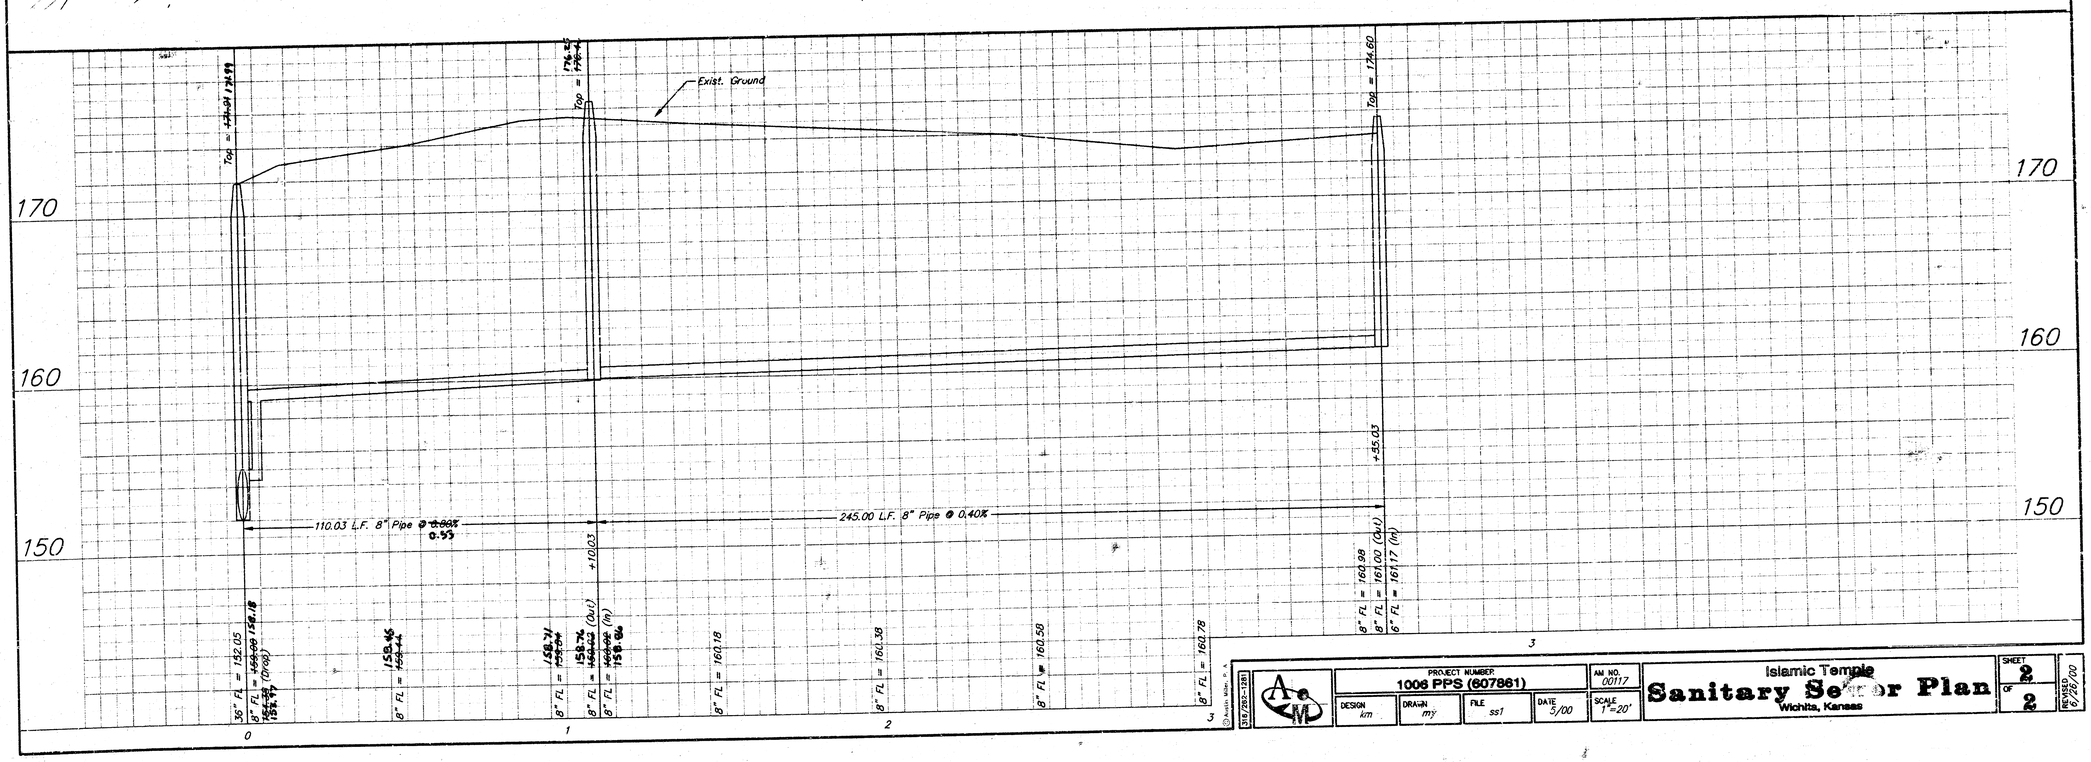

316/265-1281	PROJECT NUMBER: 1006 PPS (607861)				AM NO. 00117	Islamic Temple	SHEET 2 OF 2
	DESIGN km	DRAWN my	FILE ss1	DATE 5/00	SCALE 1"=20'	Sanitary Sewer Plan Wichita, Kansas	REVISED 6/26/00