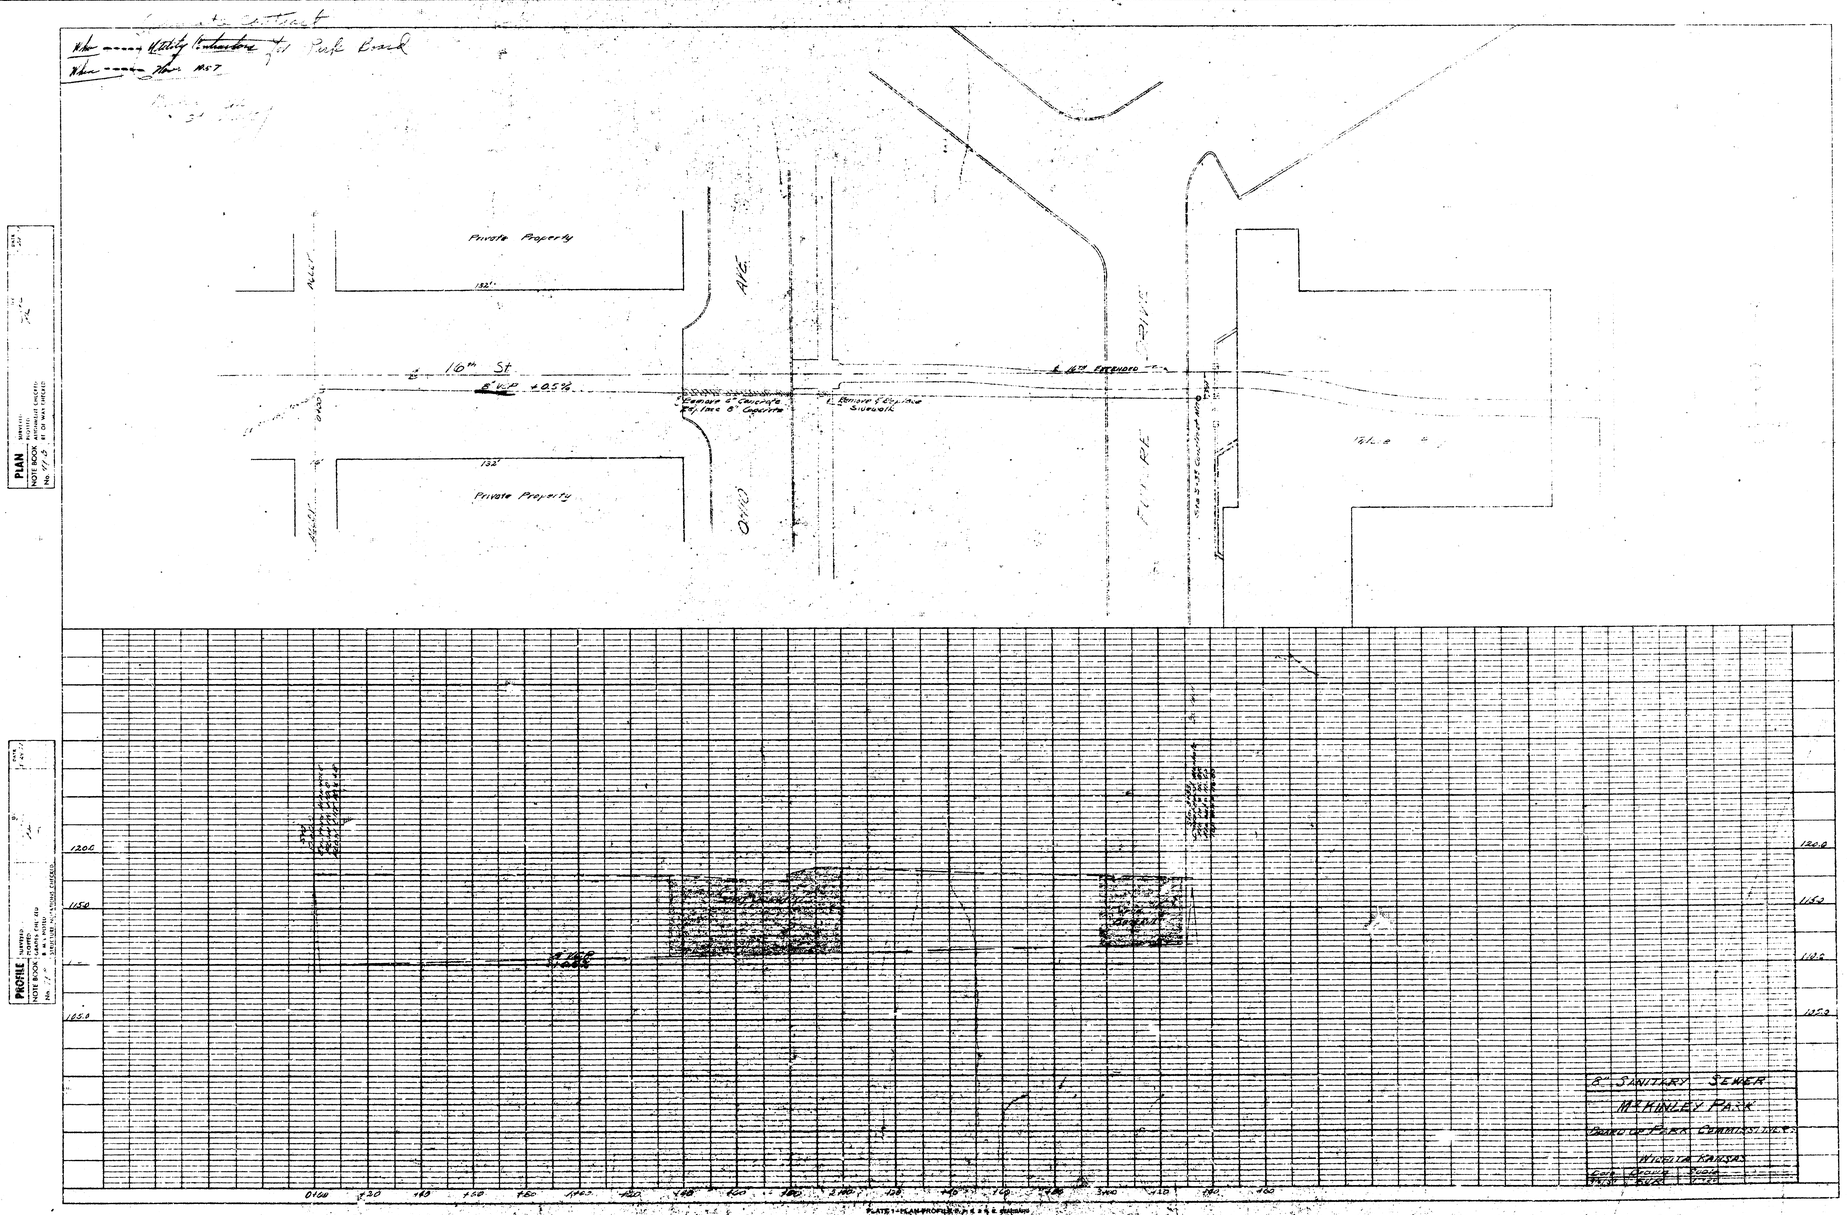

Private Property
132'
16th St
8" VCP +0.5%
Remove 4" Concrete Rep. Inc. 8" Concrete
Remove 5" Cyclone Sidewalk
Private Property
132'
OHIO AVE
FUTURE DRIVE
8" SANITARY SEWER
McKINLEY PARK
BOARD OF PARK COMMISSIONERS
WICHITA KANSAS
PLAN
PROFILE