Separate Contract

Who ---- ~~Utility Contractors~~ for Park Board

When ---- Nov. 1957

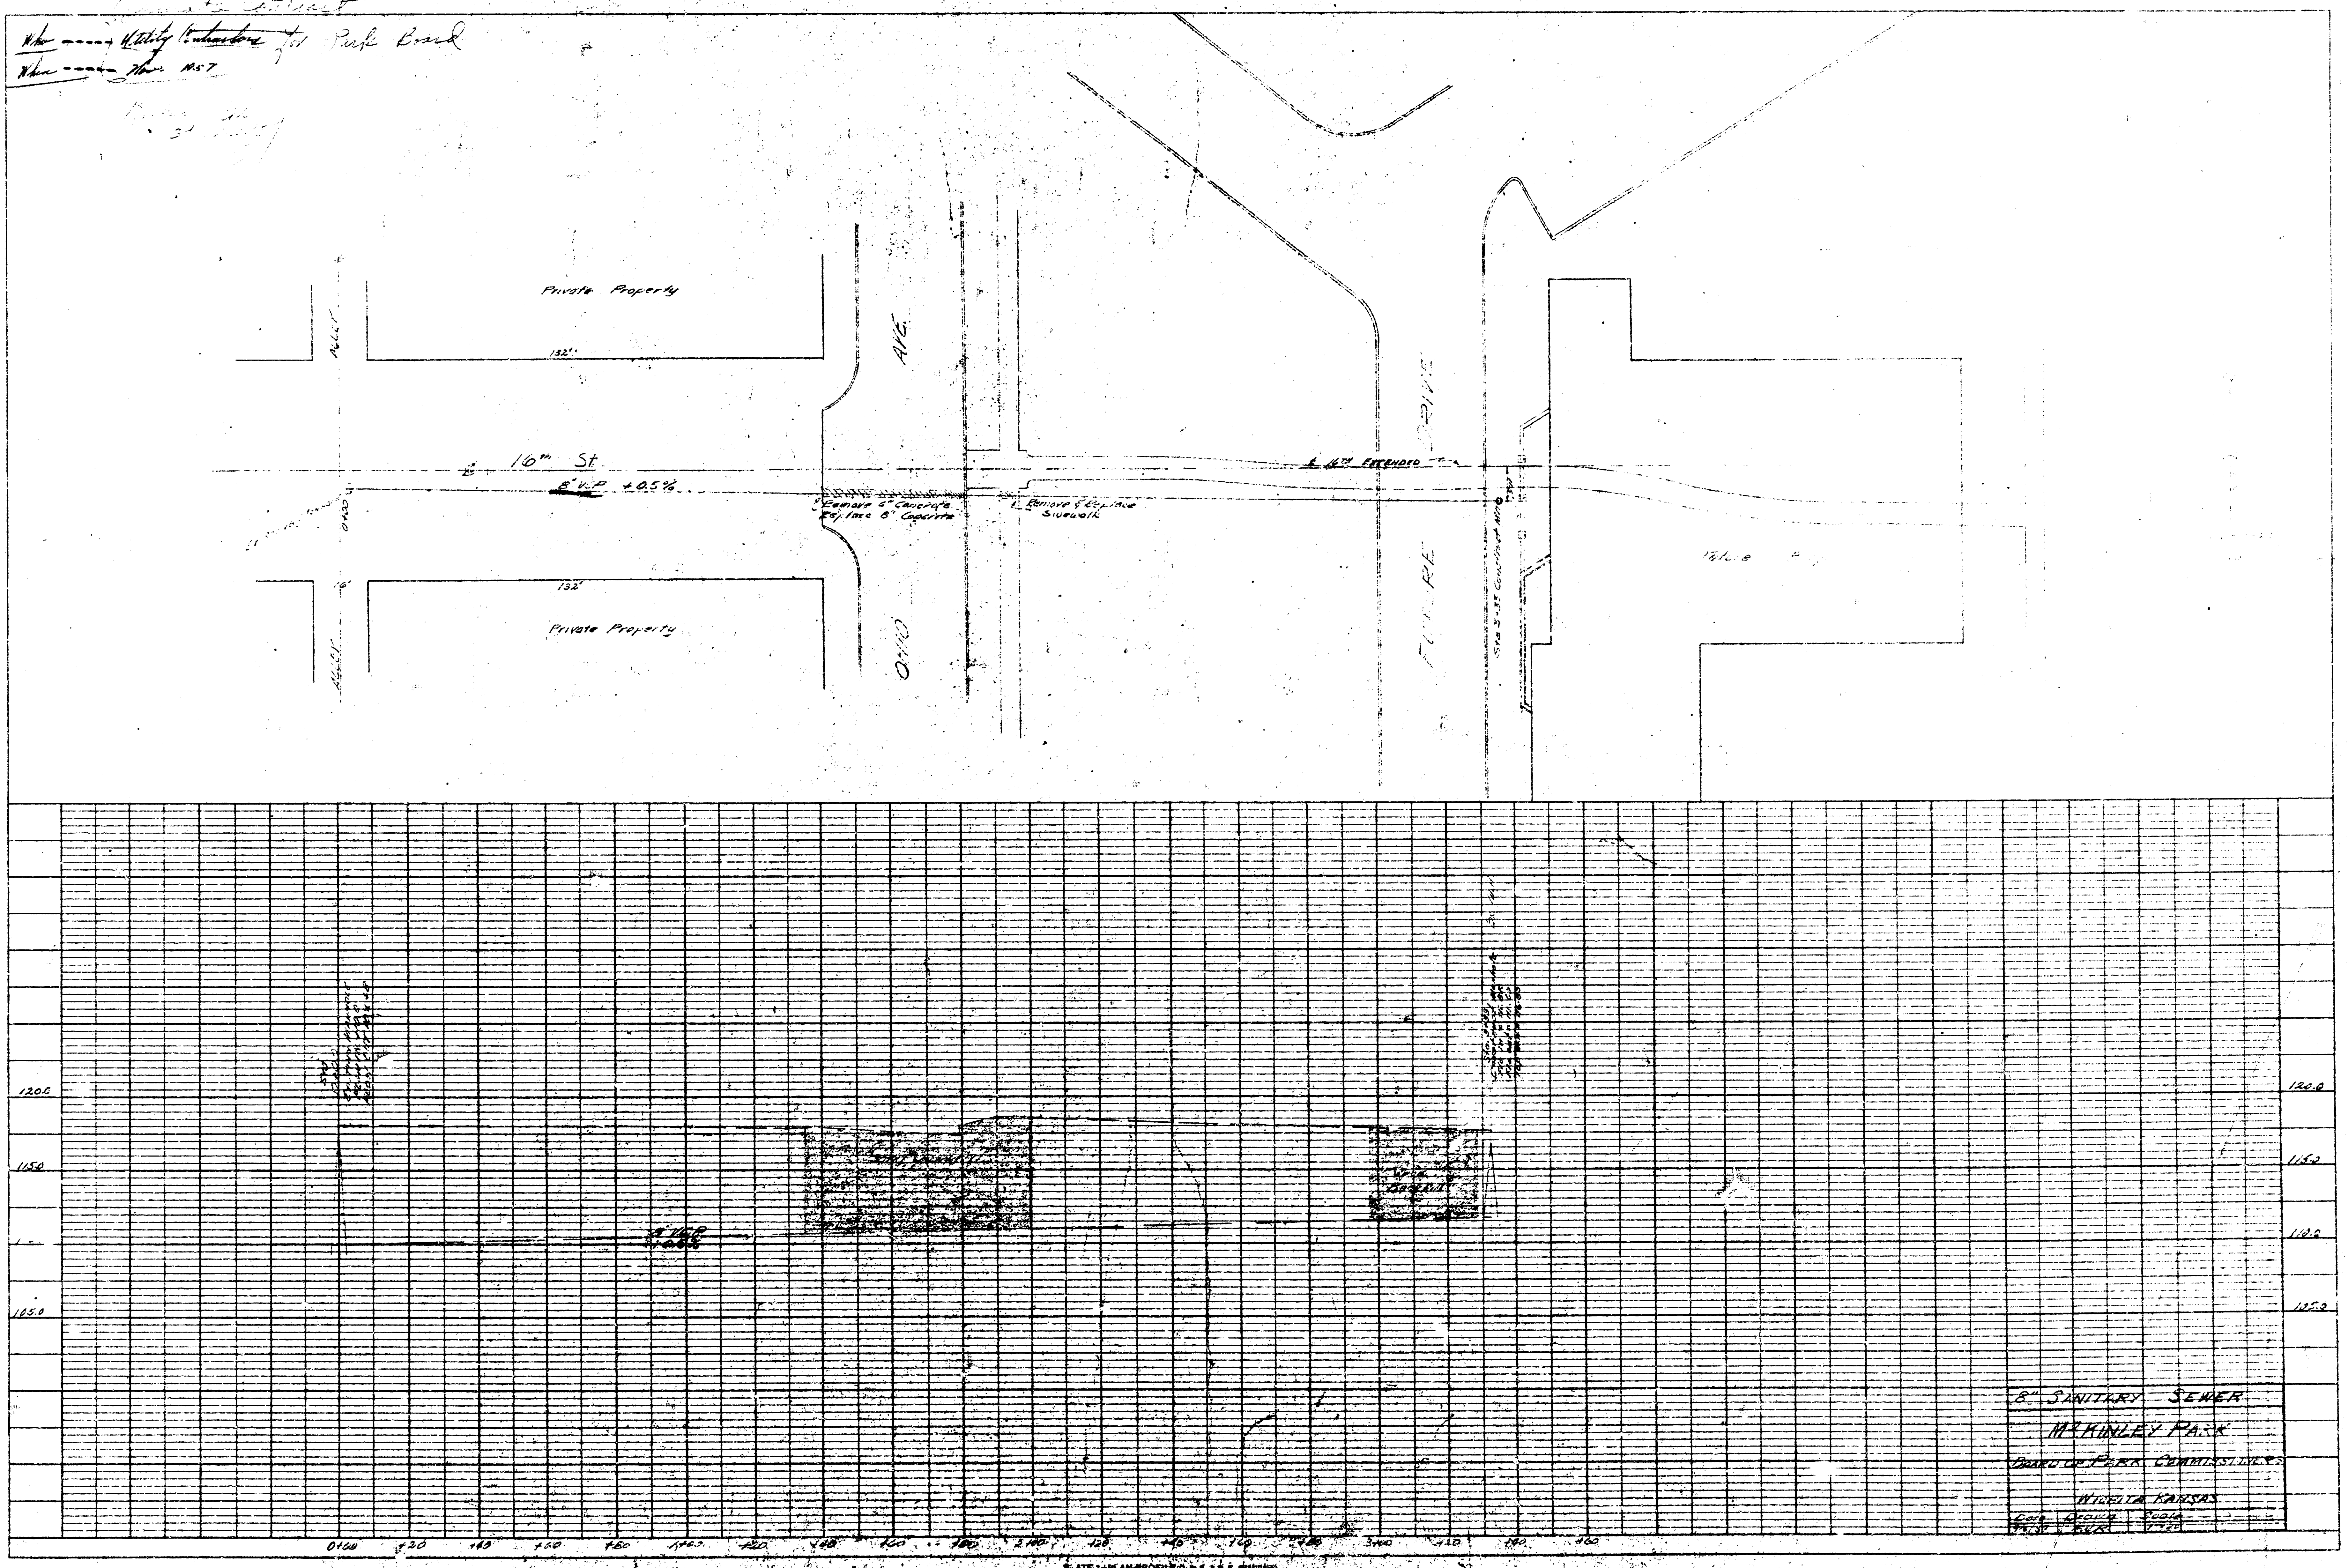
PLAN
Private Property
132'
ALLEY
16th St
8" V.C.P. +0.5%
132'
Private Property
OHIO AVE.
Remove 6" Concrete
Replace 8" Concrete
Remove & Replace Sidewalk
℄ 16th EXTENDED
DRIVE
Sta 3+35 Construct MH
PROFILE
1200
1150
1100
1050
120.0
115.0
110.0
105.0
8" V.C.P.
0+00
+20
+40
+60
+80
1+00
+20
+40
+60
+80
2+00
+20
+40
+60
+80
3+00
+20
+40
+60

8" SANITARY SEWER

McKINLEY PARK

BOARD OF PARK COMMISSIONERS

WICHITA KANSAS

Date	Drawn	Scale
11-57	RVR	1"=20'