


1/2 HP x 120 V 1 PHASE RSX-RS Series MOTOR OPERATOR (5 FL AMPS)

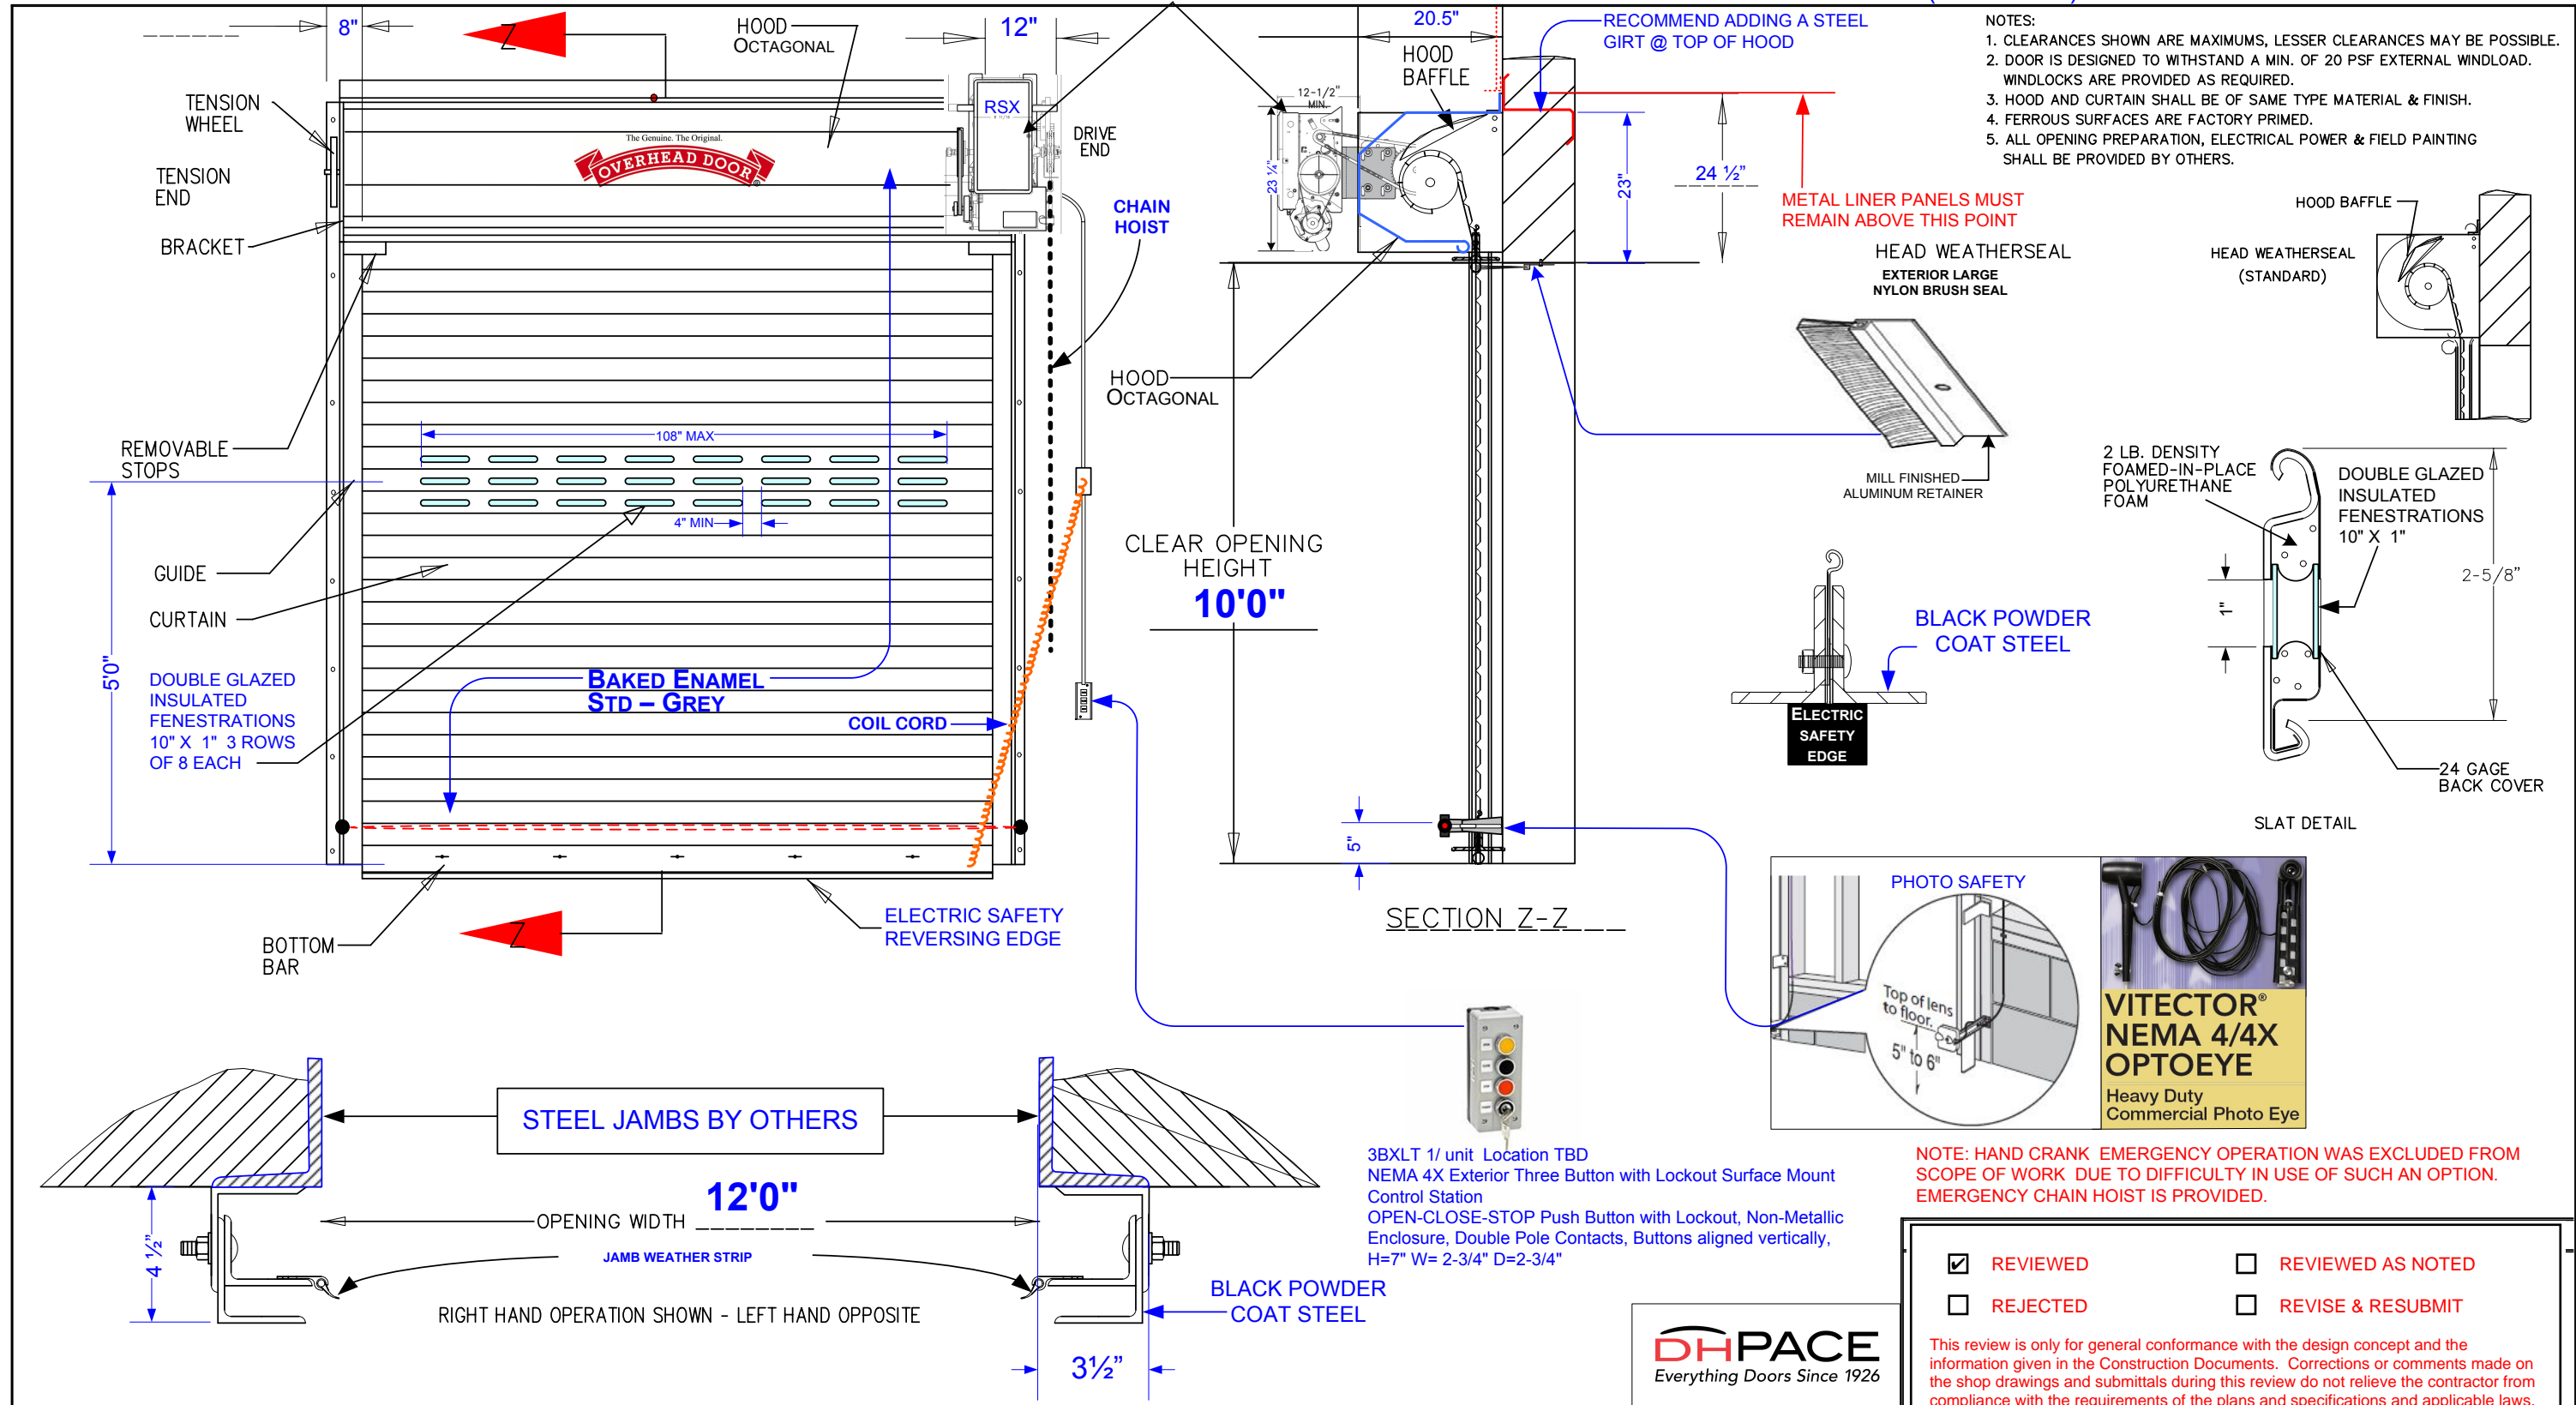

ARCHITECT DOOR NUMBER	QTY	FACTORY ORDER NUMBER	OPENING SIZE		HAND		MOUNT		JAMB				WEATHERSTRIP			SLAT GAGE	ADDED OPTIONS
			WIDTH	HEIGHT	R	L	INT	EXT	MAS	CONC	STL	WOOD	JAMB	HOOD	BOTTOM BAR		
101A	1	625	12'0"	10'0"	X		X					X	X	X	24	50,000 CYCLE SPRINGS & HD SEALED BEARINGS	

REVIEWED       REVIEWED AS NOTED  
 REJECTED       REVISE & RESUBMIT

This review is only for general conformance with the design concept and the information given in the Construction Documents. Corrections or comments made on the shop drawings and submittals during this review do not relieve the contractor from compliance with the requirements of the plans and specifications and applicable laws, codes and regulations. Review of a specific item shall not include review of an assembly of which the item is a component. The contractor is responsible for: dimensions to be confirmed and correlated at the jobsite; information that pertains solely to the fabrication processes or to the means, methods, techniques, sequences and procedures of construction; coordination of the Work with that of all other trades and performing all Work in a safe and satisfactory manner.

BY: dga  
 DATE: 06-20-16

TEAM ARCHITECTURE

P.O. Box 43 | Andover, Kansas 67002 | (316) 347-7755 | TEAMArchitecture-LLC.com  
 together everyone achieves more

