



Submittal - 024 Pump Station

Ashcroft Gauges (Submittal on the following page(s), this sheet is the response page)

Response:


MKEC ENGINEERING, INC.
411 North Webb Road - Wichita, KS 67206

Reviewed Reviewed As Noted
 Revise and Resubmit Rejected
 Not Required by the Contract Documents

Reviewed for conformance with the design concept of the project and compliance with the information given in the contract documents. Contractor is responsible for: dimensions to be confirmed and correlated at the job site; information that pertains solely to the fabrication process or to techniques of construction; and coordination of work of all other trades. If "Resubmit" or "Rejected" are not checked resubmission is neither desired or required.

By: Bryce Shuck Date: 6-29-16

Type 1008A/AL Stainless Steel Metric Case Commercial Gauge

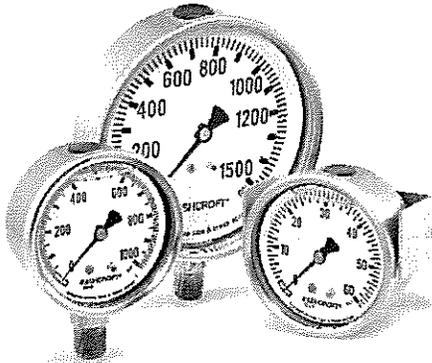

0-200PSI

FEATURES

- 63mm (2½") and 100mm (4") case sizes
- Corrosion-resistant stainless steel case/ring
- Dry, field-fillable or liquid-filled versions
- Patented PowerFlex™ movement
- True Zero™ indication, a unique safety feature
- Two-year warranty on liquid-filled gauges

Ashcroft® Type 1008A gauges are synonymous with durability, flexibility and exceptional quality.

The Type 1008A case and ring assembly is constructed of durable, corrosion-resistant stainless steel. The gauge enclosure is sealed to provide maximum protection in adverse environmental conditions. The core of the Type 1008A is the patented PowerFlex™ movement. This movement provides a higher level of resistance to shock, vibration and pulsation than conventional gauge movements.

Both 63mm and 100mm Type 1008A gauges are available dry, field fillable, glycerin filled or silicone filled. Weld nuts are standard on all back connection gauges, therefore, any back-connection gauge with the addition of a U-clamp accessory kit, can be panel mounted. For limited space constraints, the front-flange mounting kit is offered. Where it is necessary to convert a larger panel opening to a smaller size, the retrofit flange kit is available. Custom dials and metric sockets are also available.

True Zero™ indication, a unique safety feature standard on these gauges, is the accurate indication of zero pressure being applied to the gauge. In addition to the increased safety benefits, this means reduced inspection and manufacturing costs for you and your customer.

PRODUCT SPECIFICATIONS:

- Ashcroft® Model No.: 1008A/AL
- Size:** 63mm (2½"), 100mm (4")
- Case:** 304 stainless steel, dry (1008A) or liquid filled (1008AL)
- Fill Fluid:** Glycerin (20° to 150°F ambient; -7°C to 65°C)
- Ring:** 304 stainless steel, crimped
- Window:** Polycarbonate
- Dial:** Black figures on white background, aluminum
- Pointer:** Black, aluminum
- Bourdon Tube:** - C-shaped Bronze (vac.-600 psi and compound)
- Helical Bronze (1000 psi-6000 psi)
- Helical stainless steel (10,000 psi-15,000 psi)
- Movement:** Patented PowerFlex™ movement
- Socket:** Brass, with O-ring case seal
- Restrictor:** Brass throttle plug, 0.013" orifice (except for vacuum 15 psi ranges)
- Connection:** ¼ NPT lower and back
- Ranges:** Vac. thru 15,000 psi and compound. Equivalent metric ranges available
- Accuracy:** ASME B40.100, Grade B, ±3-2-3%
- Operating Temp.:** -40°F to 150°F, -40°C to 65°C (dry gauge)

OPTIONAL FEATURES:

- Case:** Sealed case, field fillable (LJ)
Silicone filled (GV)
(-40°F to 150°F; -40°C to 65°C)
- Mounting Hardware:** U-clamp (UC), Front flange (FF), Retrofit flange (RF)
- Socket:** Throttle Plugs, 0.007", 0.020", 0.063" JIS, DIN and other connections on application
- Others:** Customized dials, Nonstandard ranges, Special calibration on application FlutterGuard™ (eliminates rapid pointer flutter on most vibration/ pulsation applications - dry gauges only)

COMMONLY USED ON

Hydraulic systems, machine tools, pressure washers/sprayers, compressors, irrigation equipment, a variety of other applications

HOW TO ORDER (Typical example)

Dial Size: 63mm _____ 63

Case Type Number: 1008A _____ 1008A

(SS case / bronze tube / brass socket / PowerFlex movement)


Liquid Filled Case _____ L

Connection Size/Location: ¼ NPT Lower _____ 02L

Range: 1000 psi _____ 1000#


Type 1008A/AL Stainless Steel Metric Case Commercial Gauge

DIMENSIONS

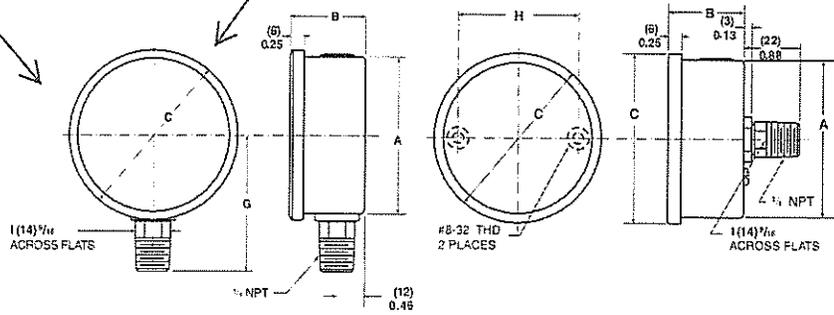


63/100mm 1008A/AL Lower Connection

63/100mm 1008A/AL Back Connection

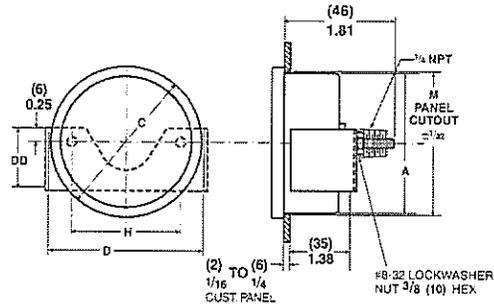

63/100mm 1008A/AL Back Connection
(XUC) U-Clamp

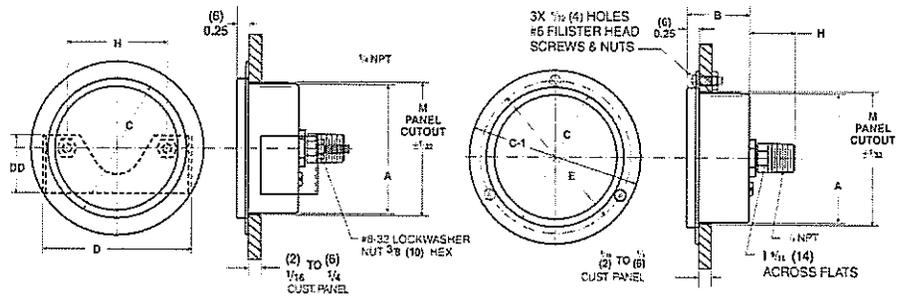

63/100mm 1008A/AL Back Connection
(XRF) Front Flange Retrofit

63/100mm 1008A/AL Back Connection
(XFF) Front Flange

SIZE/TYPE	A	B	C	CC	D	DD	E	G	H	M	Weight	
											Dry	Wet
63mm, 1008A/AL	(63) 2.48	(31) 1.21	(69) 2.71	(86) 3.36	(75) 2.95	(28) 1.12	(75) 2.95	(56) 2.20	(49) 1.94	(65) 2.54	.11kg .25lb	.21kg .47lb
100mm, 1008A/AL	(100) 3.94	(31) 1.24	(106) 4.16	(133) 5.22	(107) 4.20	(28) 1.12	(116) 4.57	(74) 2.92	(76) 3.00	(101) 3.97	.18kg .40lb	.42kg .94lb

Dimensions in (mm) inches.