


Re-Use Water Pump Station

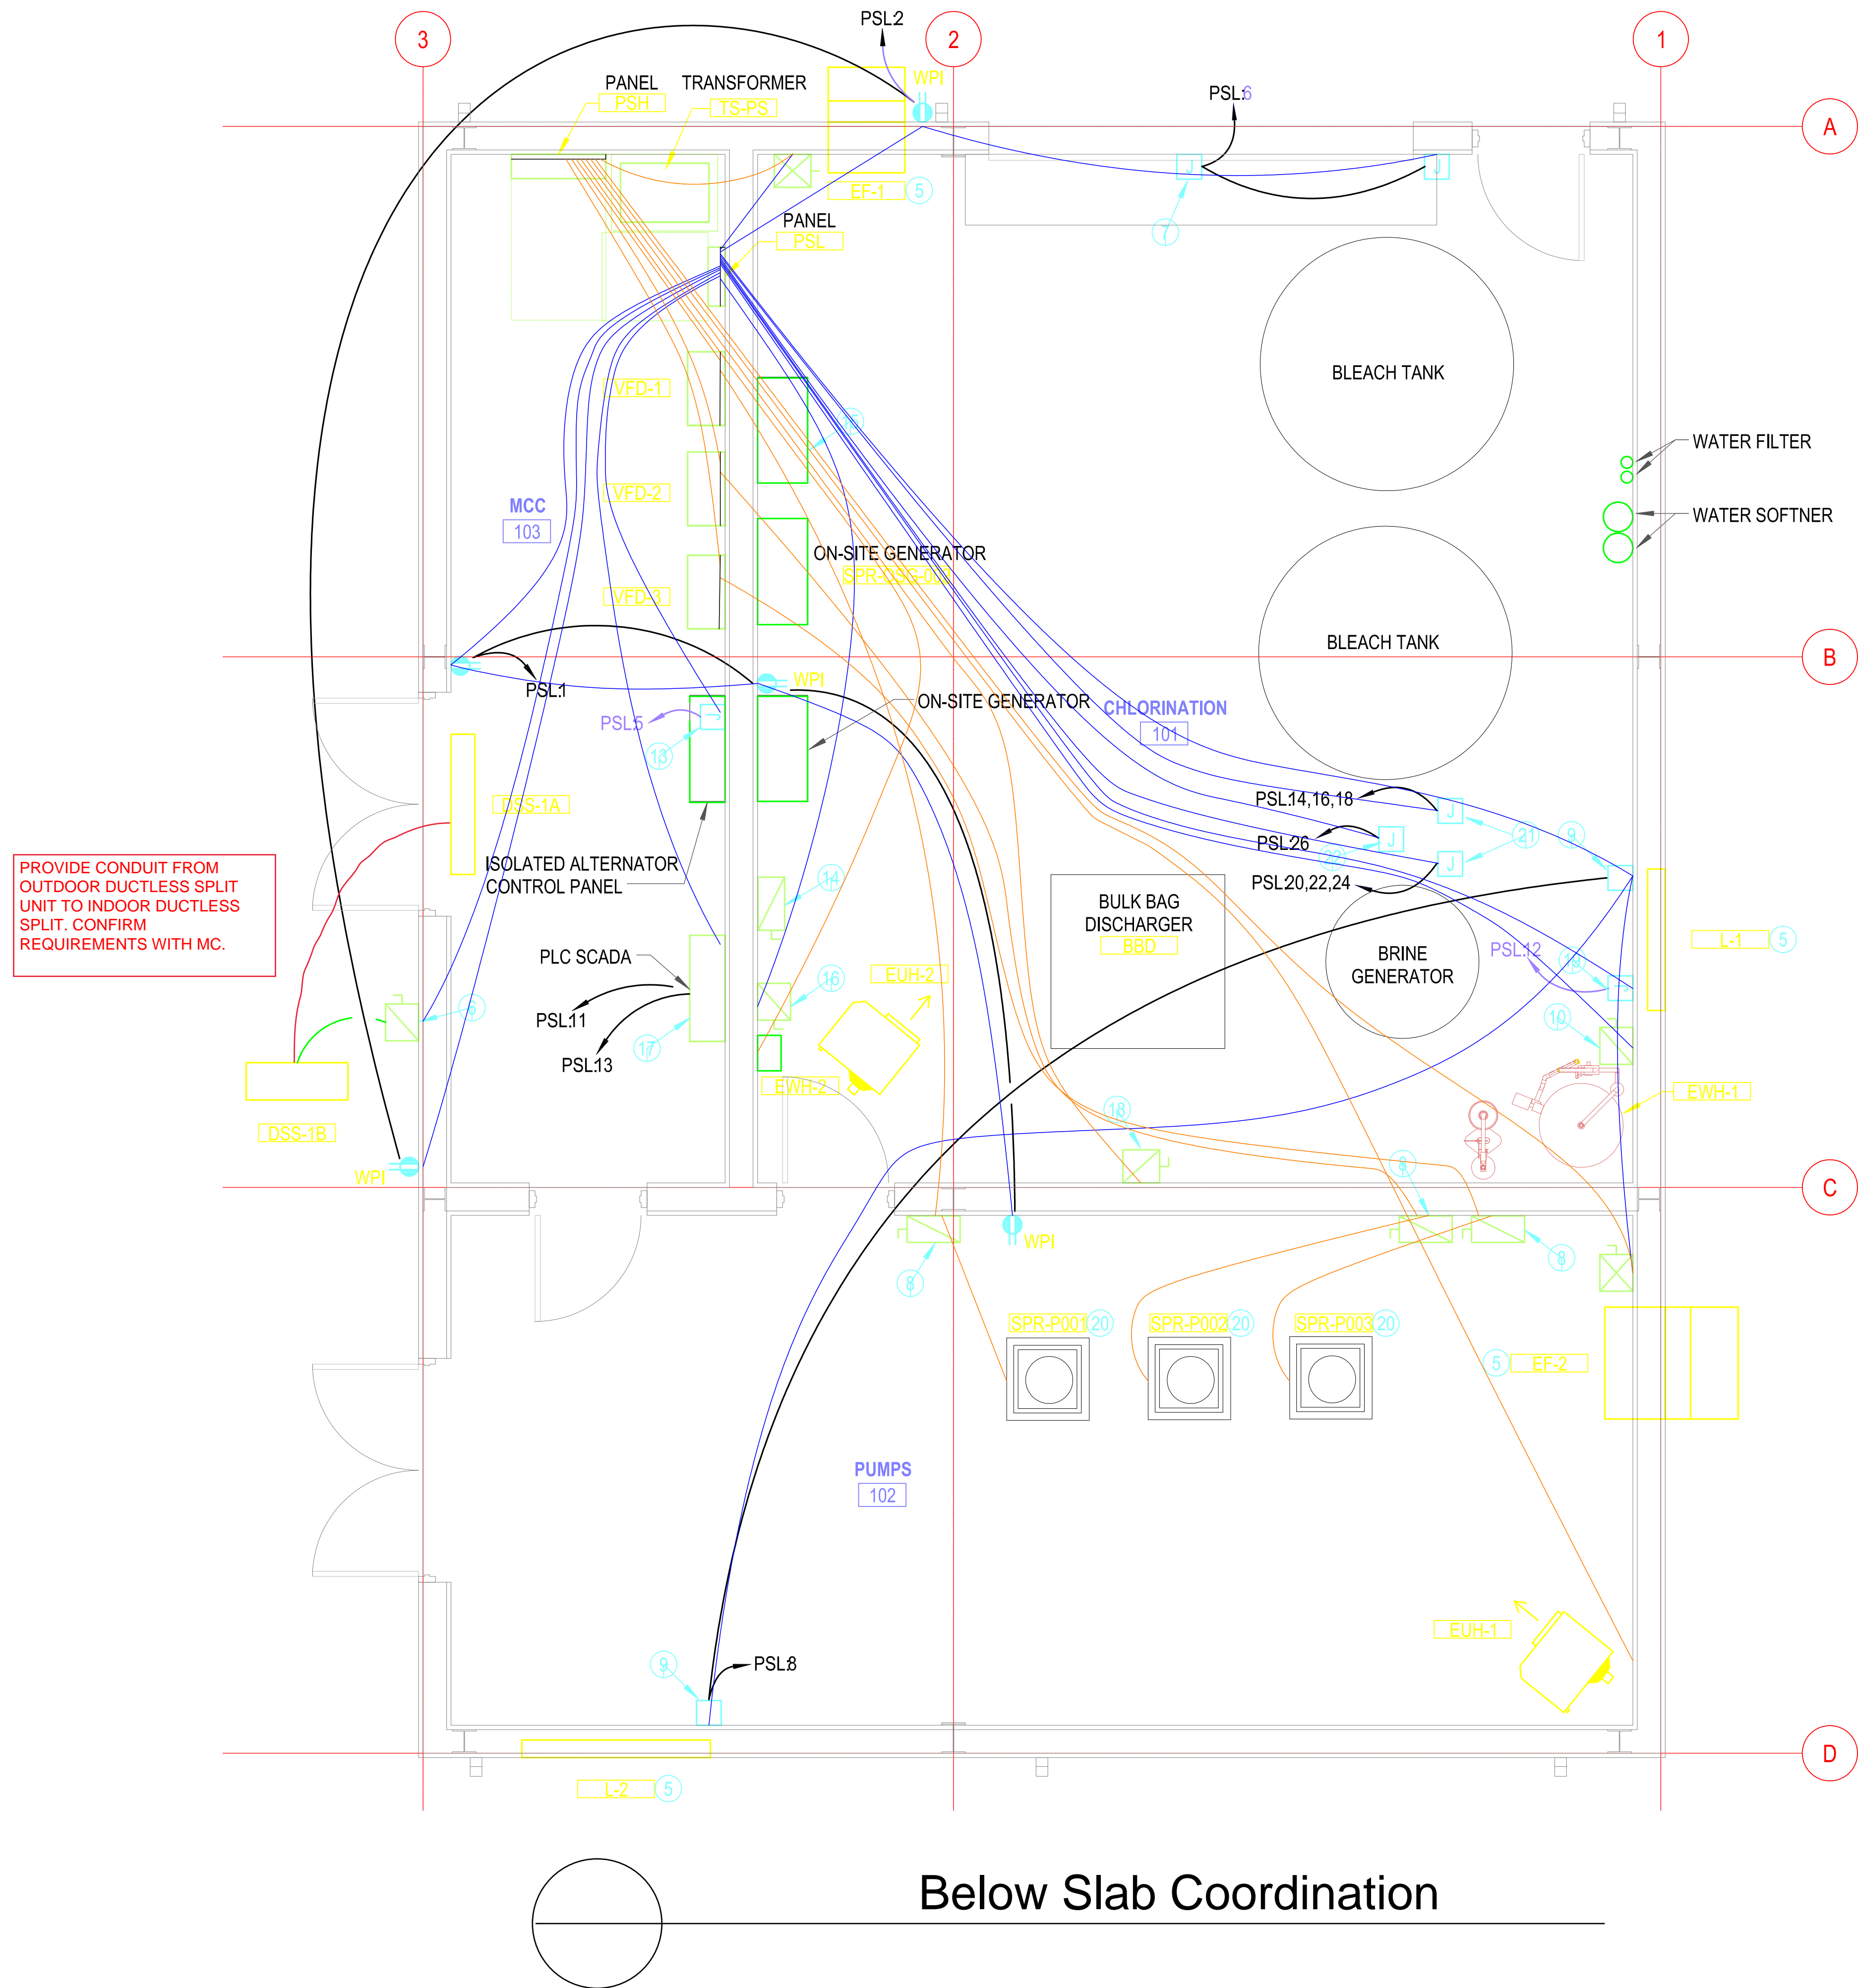

MKEC ENGINEERING, INC.
411 North Webb Road – Wichita, KS 67206

Reviewed Reviewed As Noted
 Revise and Resubmit Rejected
 Not Required by the Contract Documents

Reviewed for conformance with the design concept of the project and compliance with the information given in the contract documents. Contractor is responsible for: dimensions to be confirmed and correlated at the job site; information that pertains solely to the fabrication process or to techniques of construction; and coordination of work of all other trades. If "Resubmit" or "Rejected" are not checked resubmission is neither desired or required.

By: Joel Wheeler Date: 08/31/2016

Revision Received
Date:


Revised On:

**E2.0
PWR**

Scale:

Below Slab Coordination

Re-Use Water Pump Station

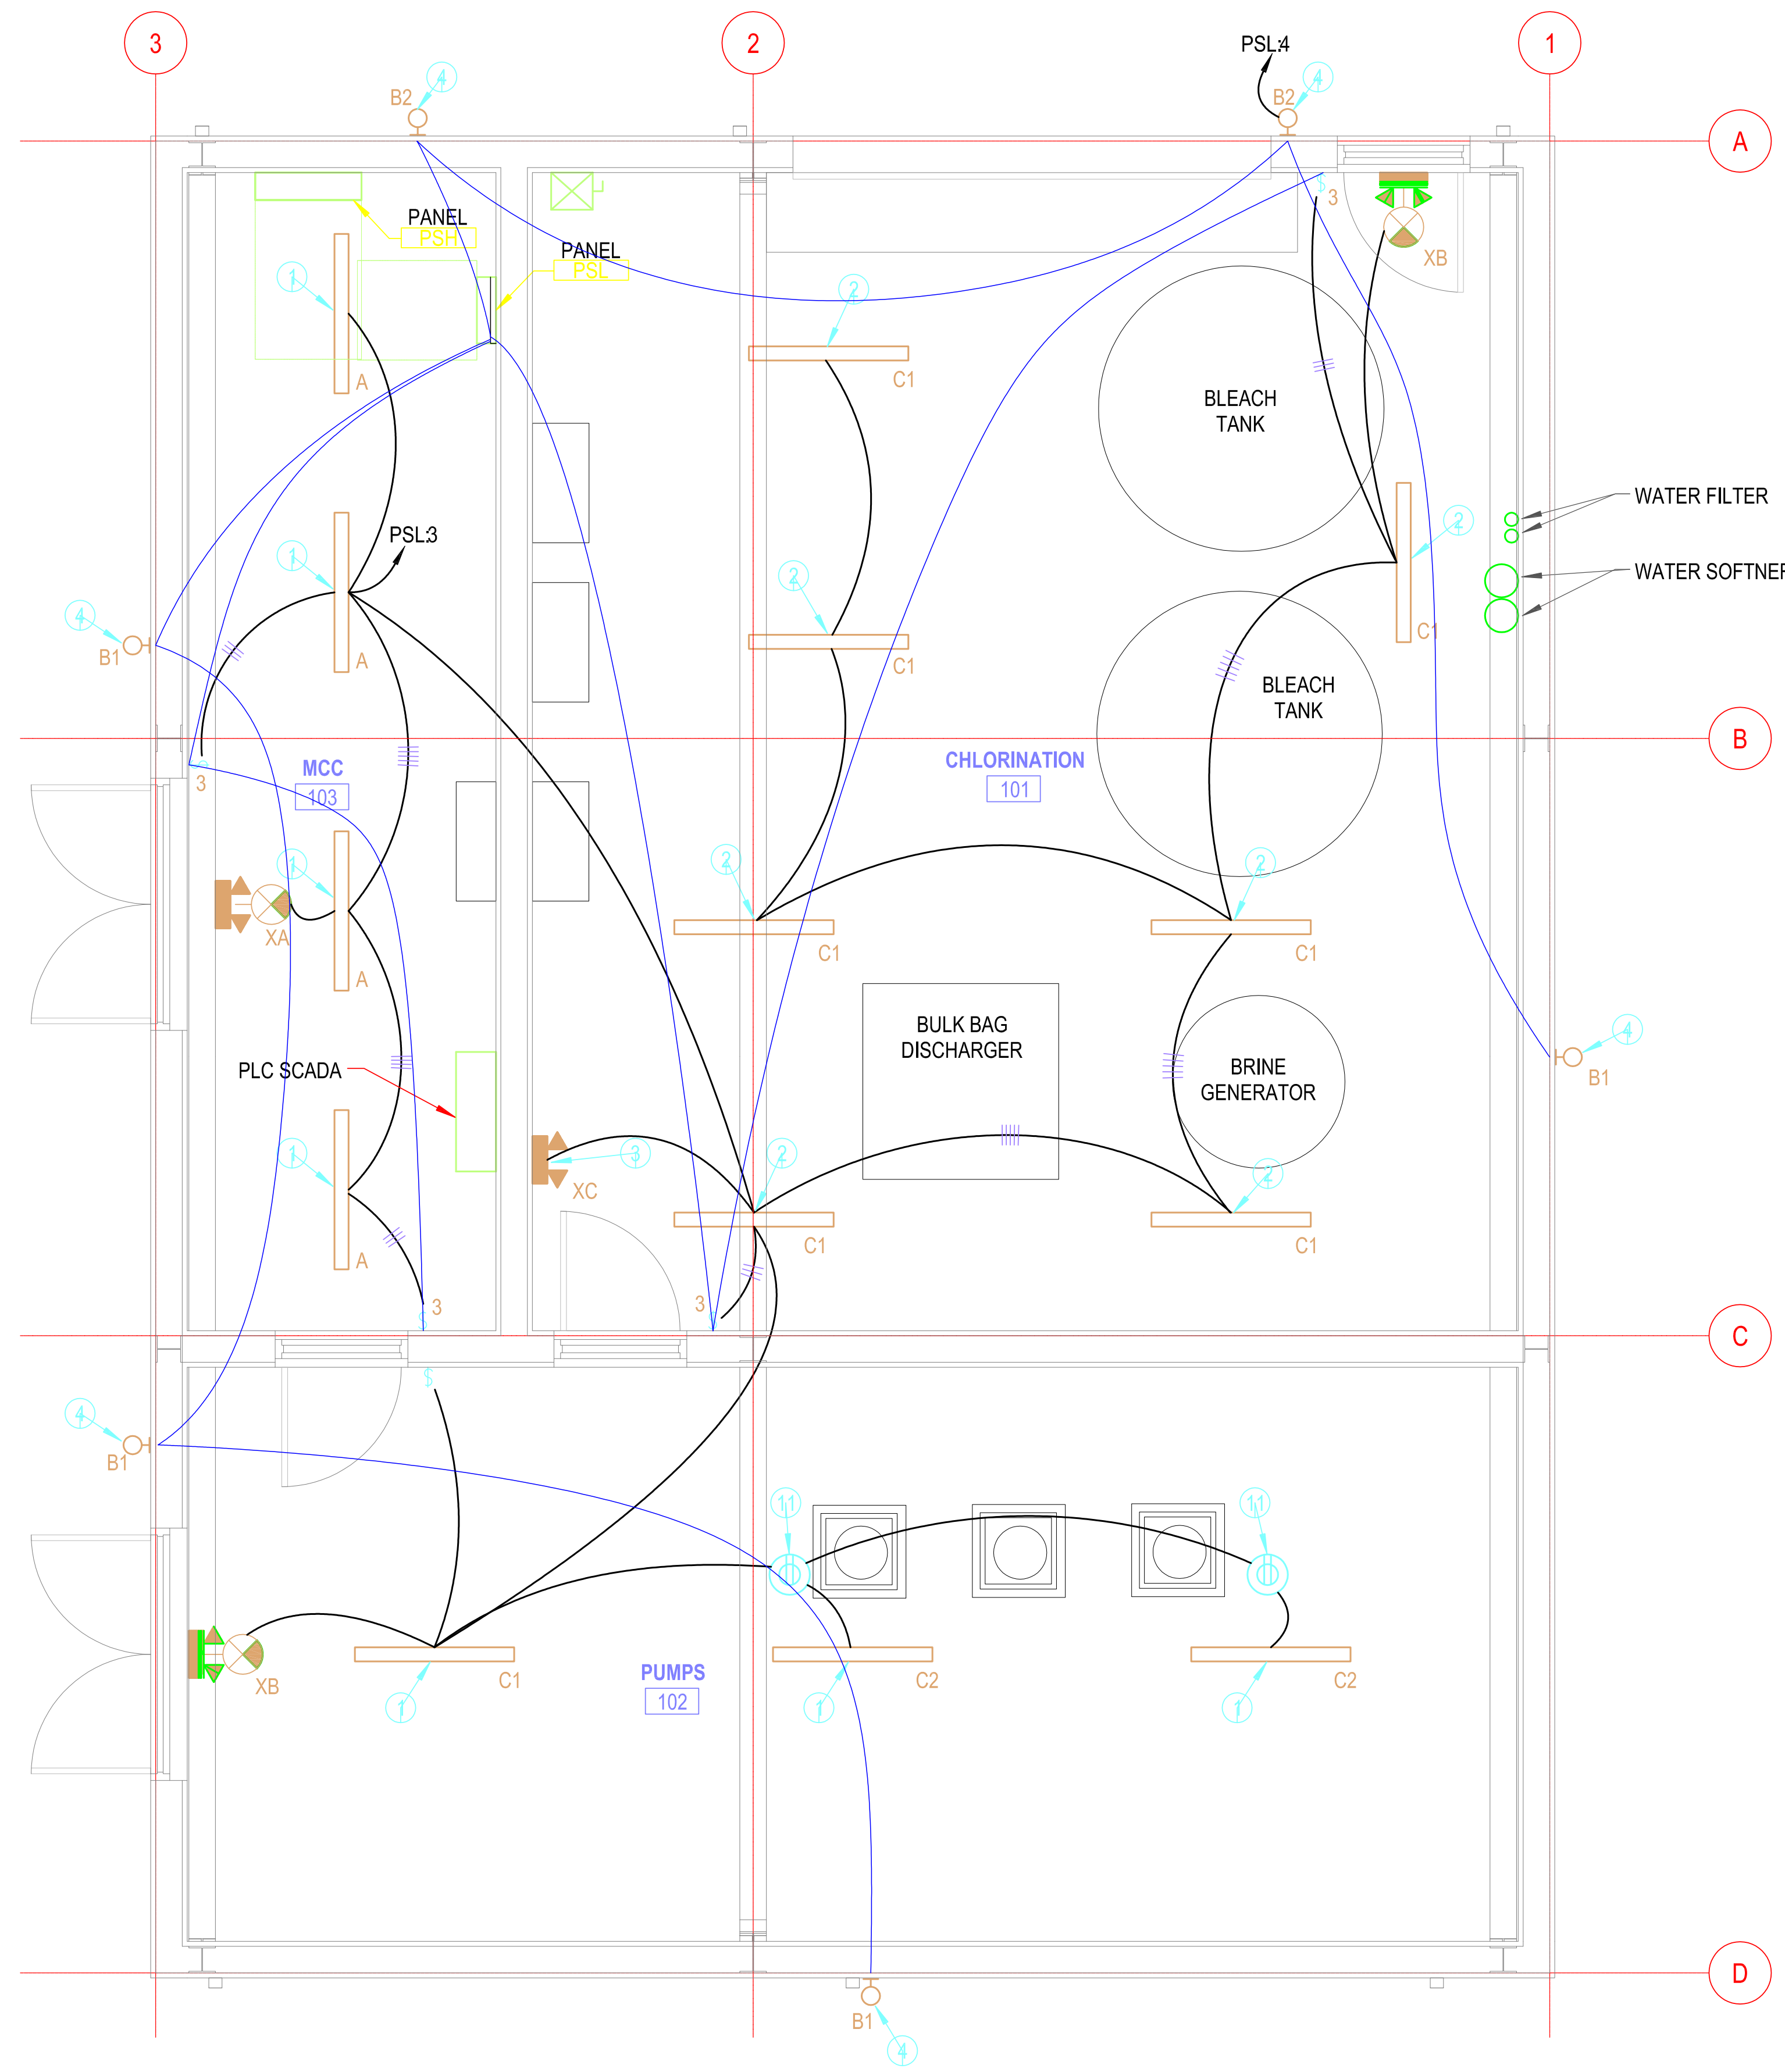

Below Slab Coordination

MKEC ENGINEERING, INC.
411 North Webb Road – Wichita, KS 67206

Reviewed Reviewed As Noted
 Revise and Resubmit Rejected
 Not Required by the Contract Documents

Reviewed for conformance with the design concept of the project and compliance with the information given in the contract documents. Contractor is responsible for: dimensions to be confirmed and correlated at the job site; information that pertains solely to the fabrication process or to techniques of construction; and coordination of work of all other trades. If "Resubmit" or "Rejected" are not checked resubmission is neither desired or required.

By: Joel Wheeler Date: 08/31/2016


Revision Received
Date:

Revised On:

**E2.0
Lighting**

Scale:

Re-Use Water Pump Station

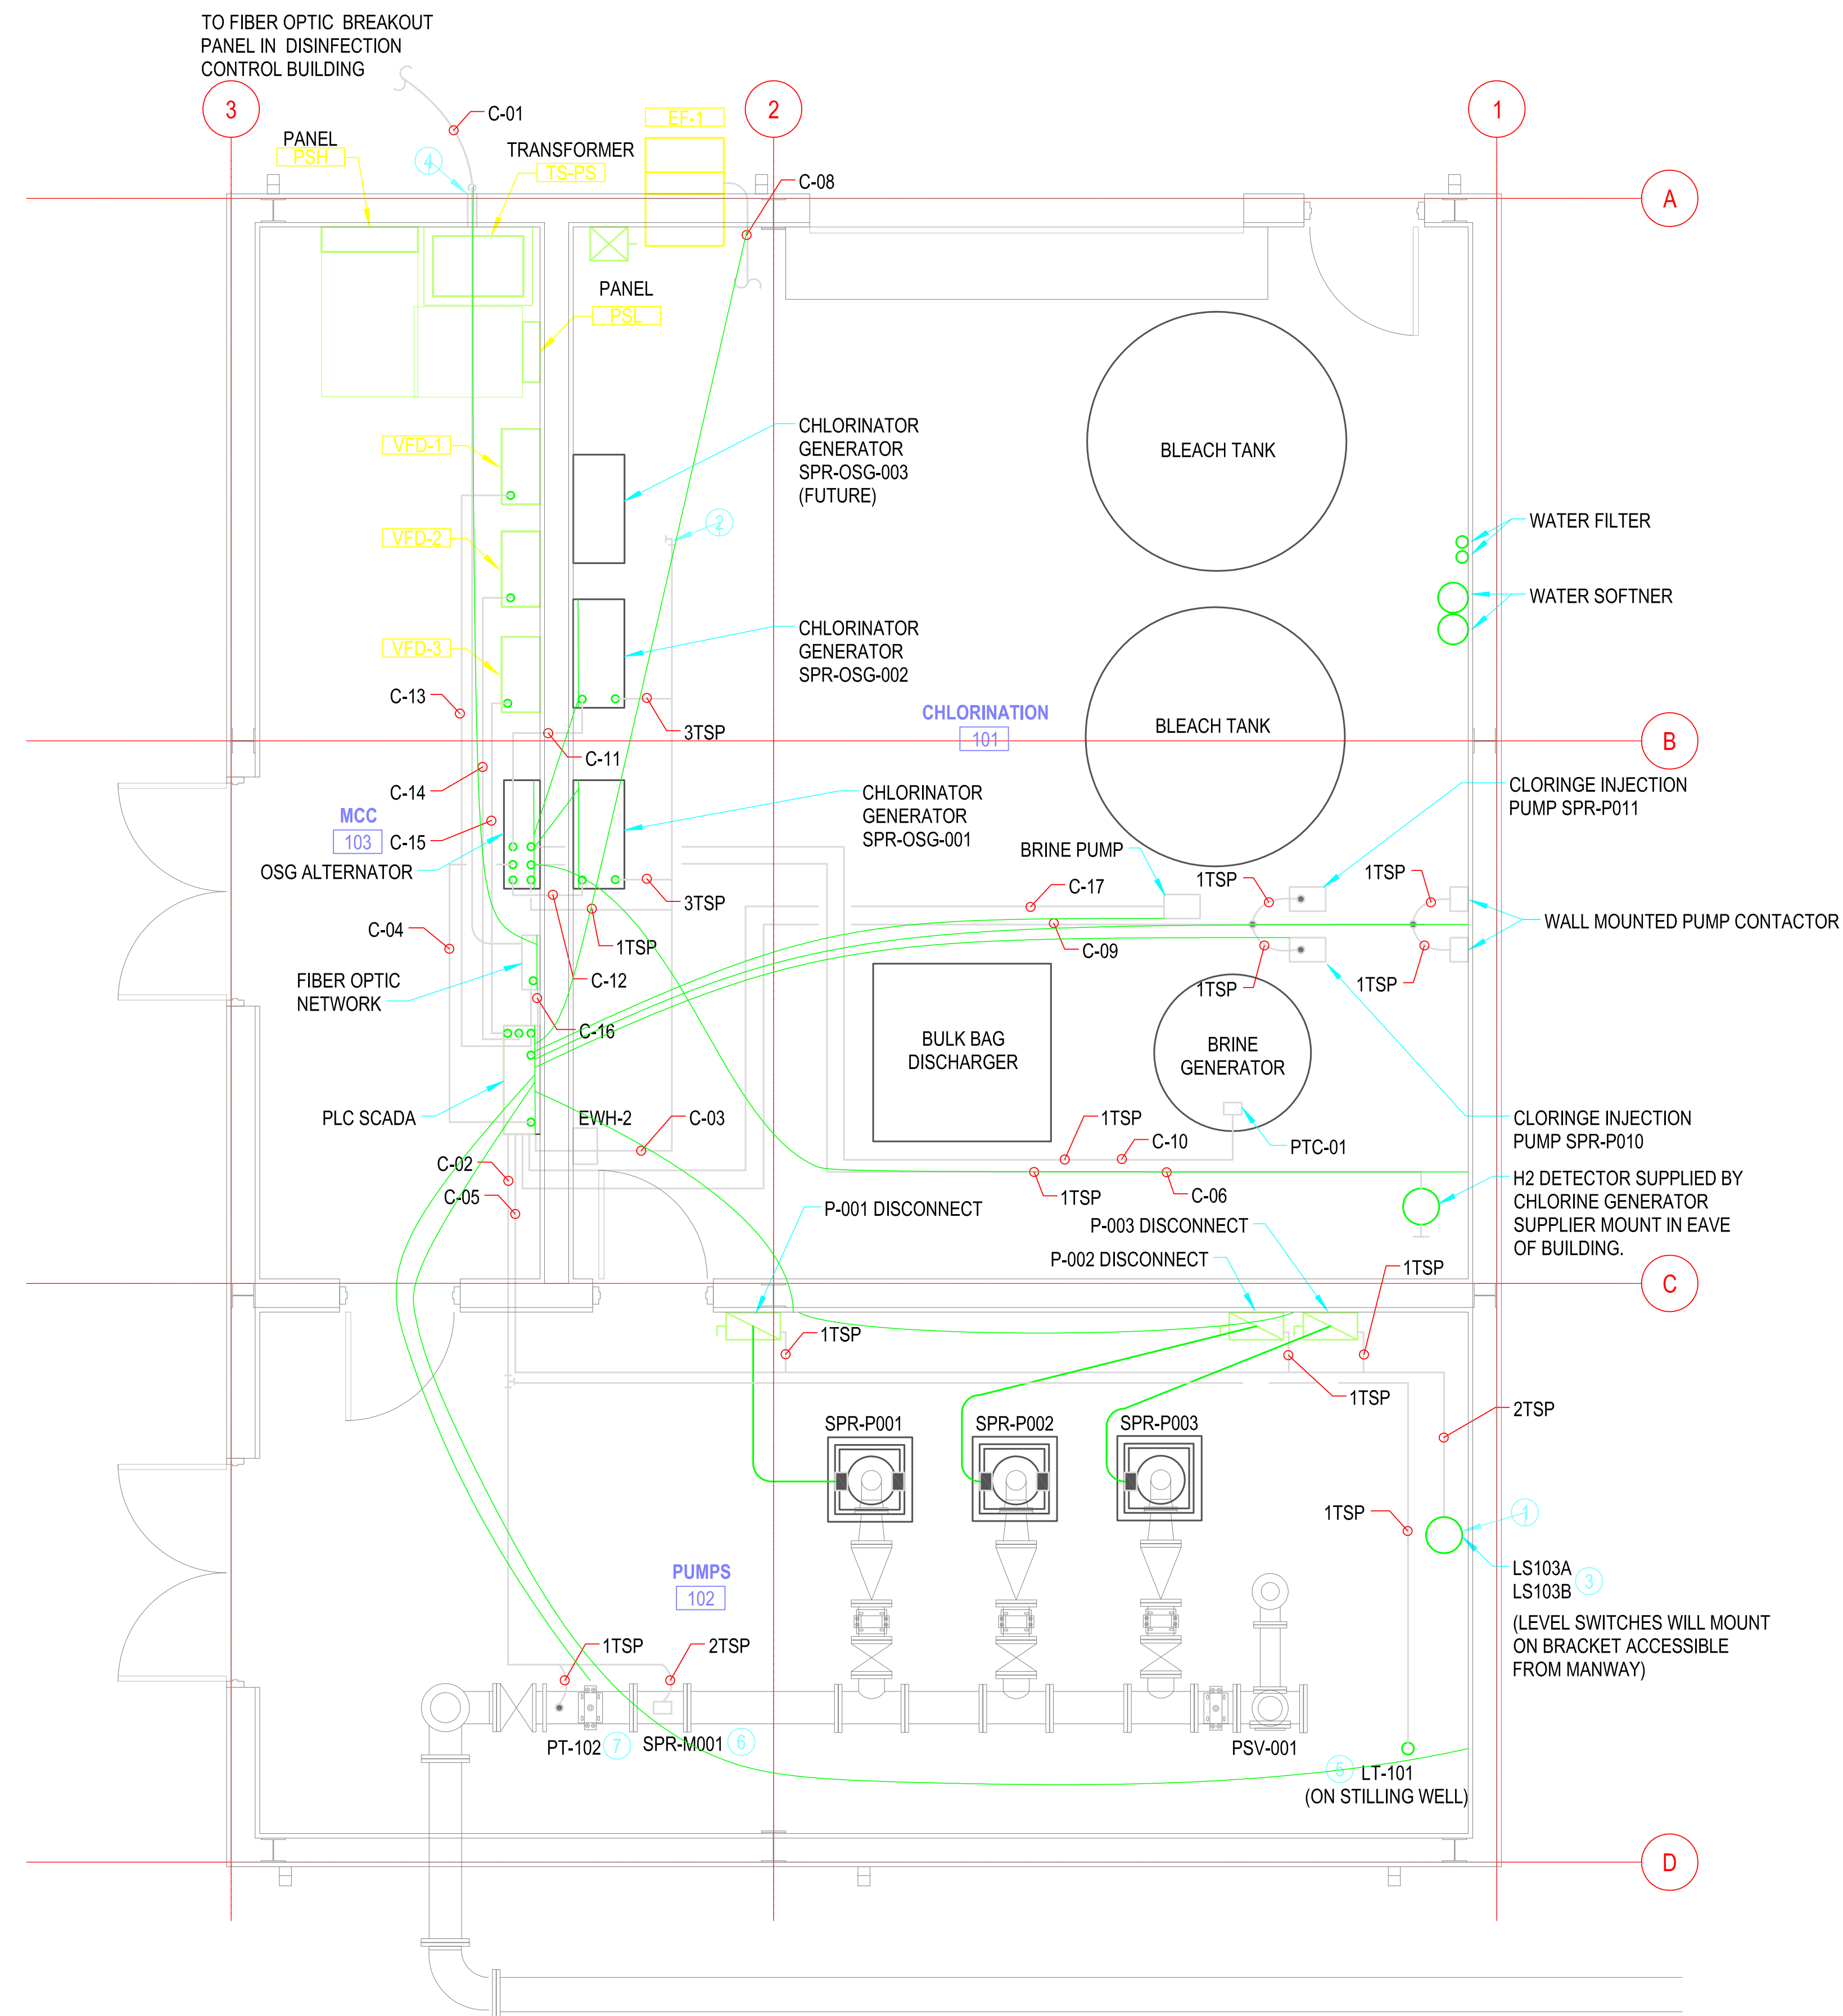

MKEC ENGINEERING, INC.
411 North Webb Road – Wichita, KS 67206

Reviewed Reviewed As Noted
 Revise and Resubmit Rejected
 Not Required by the Contract Documents

Reviewed for conformance with the design concept of the project and compliance with the information given in the contract documents. Contractor is responsible for: dimensions to be confirmed and correlated at the job site; information that pertains solely to the fabrication process or to techniques of construction; and coordination of work of all other trades. If "Resubmit" or "Rejected" are not checked resubmission is neither desired or required.

By: Joel Wheeler Date: 08/31/2016

Revision Received
Date:

Revised On:

**E2.1
Controls**

Scale: