TRAP AREA

Plat 9-52

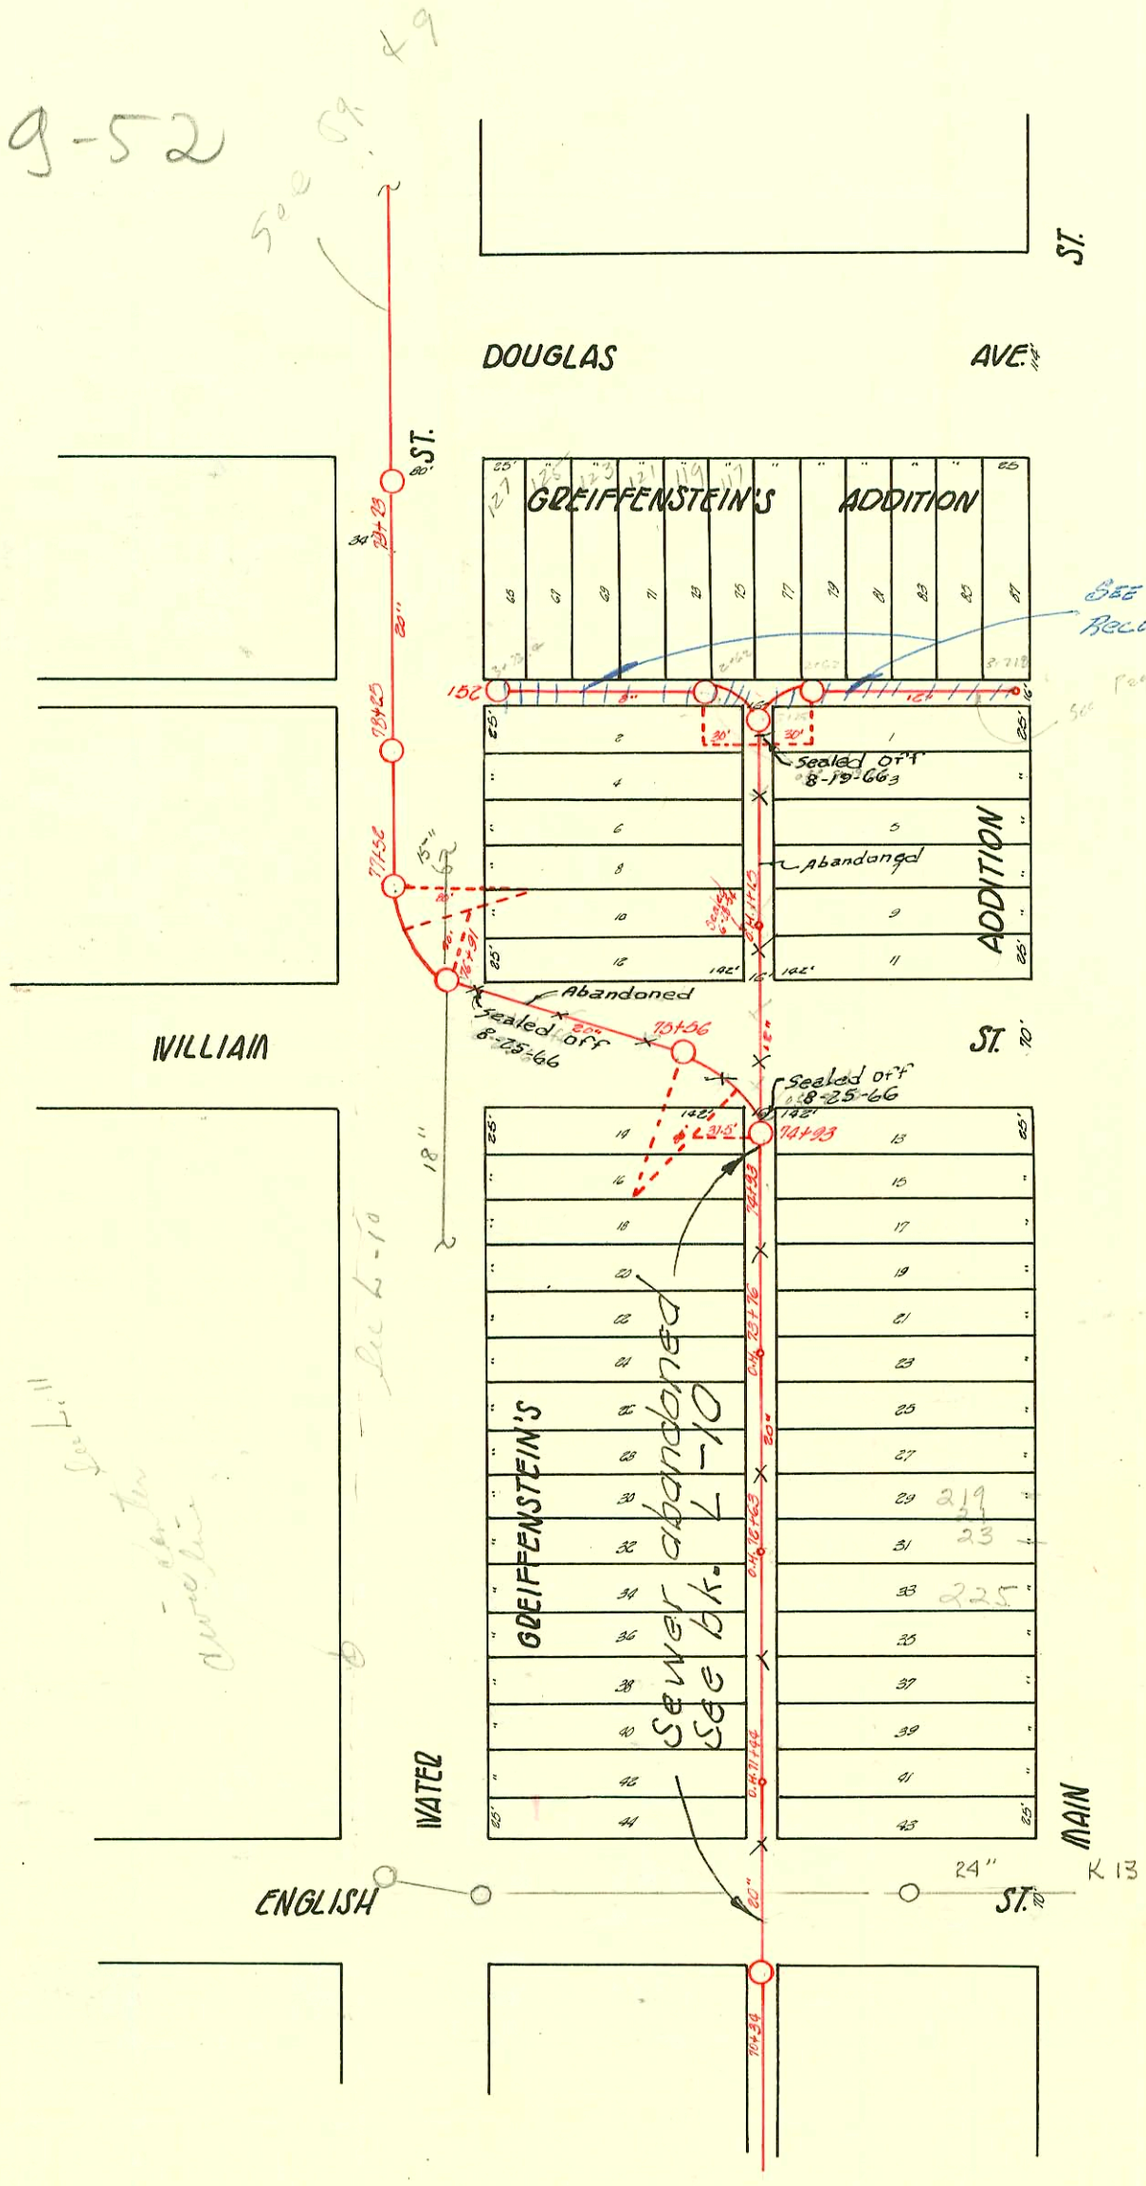

Form 41-(54) 12-54

CONSTRUCTION RECORD							SERVICE RECORD					
STATION	ELEVATION		Depth	MANHOLE	4-INCH "Y" BRANCHES		No. of Permit		House Number		DATE OF PERMITS	
	Ground	Grade			North West	South East	North West	South East	North West	South East	North West	South East
				+73.4 F.T.								
						+62.7 N.		Seal off #35029 #163		127 W. Douglas		2-3-66
	112.00	105.33	6.67			+36.3 N.	#981 Seal off	#5030 85	125 W. Douglas	125 W. Douglas	6-6-19	2-20-92 2-3-66 4-7-12
3						+12.9 N.		#251		123 W. Douglas		4-3-11
						+89.7 N.	#102	Seal #311 880		121 W. Douglas		10-11-65 8-24-91
	111.99	105.20	6.79	+62		+82 N.		#465		119 W. Douglas		9-18-15
						+65.5 N.						7-20-98
						+47 N.						8-9-98
						+34.4 N.						
2	111.65	105.08	6.57	+25	+15	+13					9-25-06	8-1-98
					+75	1 +88	#18	#211	120 S. Water	119 S. Main Lot 5 & 7 S. Main ?	3-8-07	3-30-04
						+62		#21?				3-9-03
	111.26	104.81	6.45	SEALED 6-28-54 +15 O.H.	+14.0 +40.8	+38.8	#37		NO Record		3-7-07 5-8-91	
						+13.5	#71 #1141	#1146	Bet. Matha & Mt. Wm to English	NO Record 125 S. Main	8-1-23	7-15-90
						+9.5		#159				7-24-06
79	111.41	104.54	6.87	+73								
78	111.63	104.44	7.19	+25								
77	111.63	104.39	7.24	+52								
	112.29	104.32	7.95	+91		+46 N.						
76	111.59	104.24	7.35			+16.9 N.						
						+91.3 N.						
75	111.20	104.20	7.00	+56.3		+59 N.						
	110.85	104.12	6.73	+93			#838	#2152	Standard Oil Filling Sta.	Temp. Brew Joint next to 211 S. Main SW Cor Main & Miller	11-14-17	4-2-20
					+86.1	+84.1		#236				12-6-05
					+61.2	+59.2		#1340		205 N. MAIN	7	10-30-19 5-13-90
					+36	+34	#1626	#786	109 W. William	816 N. ? WATER	11-7-23	8-29-21
74	110.93	104.04	6.89		+11.1	+09.1						
				+76 O.H.	+86	+84	#24	#250	Cor. Water & William	No Record 213 S. Main	3-13-07	12-12-01
					+58.8	+56.8		#480				8-11-10
					+34	+26.2	215?	#6	458 N. MARKET 217-19 S. MAIN		9-27-99	1-4-95
73	111.17	103.94	7.23		+09	+04.5						
				+63 O.H.	+85.5	+79	219?	11829	220 S. WATER No Record	~~219-21-23 S. Main~~	11-2-99	11-9-59 5-23-01
					+61	+59	#380				6-28-02	
					+36	+34	#430	#968	226 S. WATER	225 S. Main	7-16-18	9-7-28
72	111.24	103.84	7.40		+11.3	+09.3		#326		233 S. MAIN		5-23-17
					+85.7	+83.7	#439	#455	230 S. WATER	233 S. Main	6-27-17	5-1-28
				+44 O.H.	+60.8	+58.8	#647		230 S. Water		11-26-10	
					+36.5	+39.5	#465		No Record		8-26-98	
71	111.28	103.74	7.54		+11.5	+09.5						
70				+34			#361		NE Corner WATER & ENGLISH		5-4-21	

#745 - Tap - 235 S. Main - 7-12-28 - Baker
#642 - Tap - 115 W. Douglas - 6-3-29 - Johnson Plbg.
#226 - Tap - 201 S. Main - Stein Bldg. - 9-27-35 - Johnson Plbg.
#93 - Tap - 115 W. Douglas - 3-19-37 - Johnson
#192 - 113 W. Douglas - 4-29-37 - Johnson - Used old connection
#2808 - Tap - 121 W. Douglas - 10-23-40 - Albert J. Hoff