
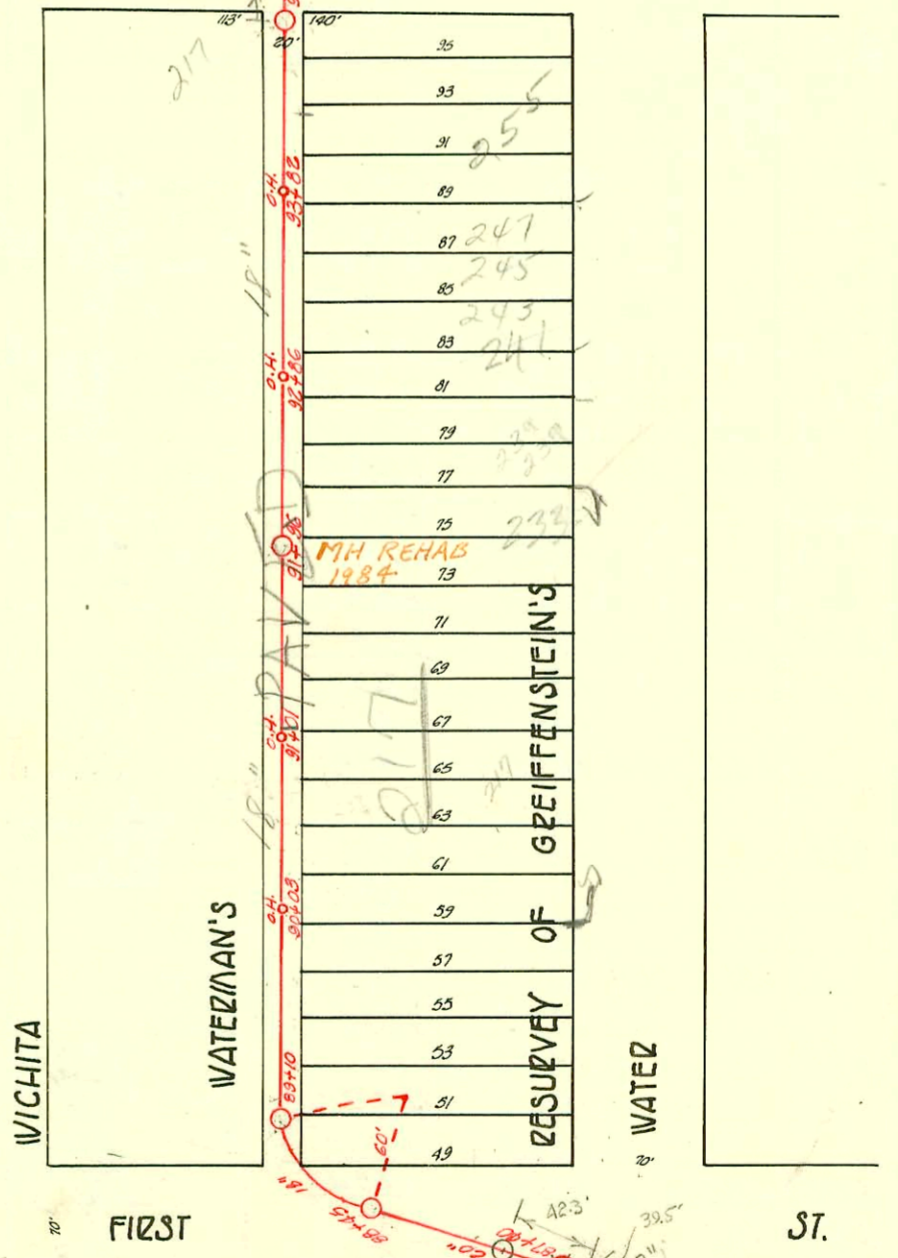


MAIN "A" FROM FIRST ST. TO THIRD ST.

S.S. #1-1889
SCALE 1"=100'

Plat 8-49

(See Page B260)

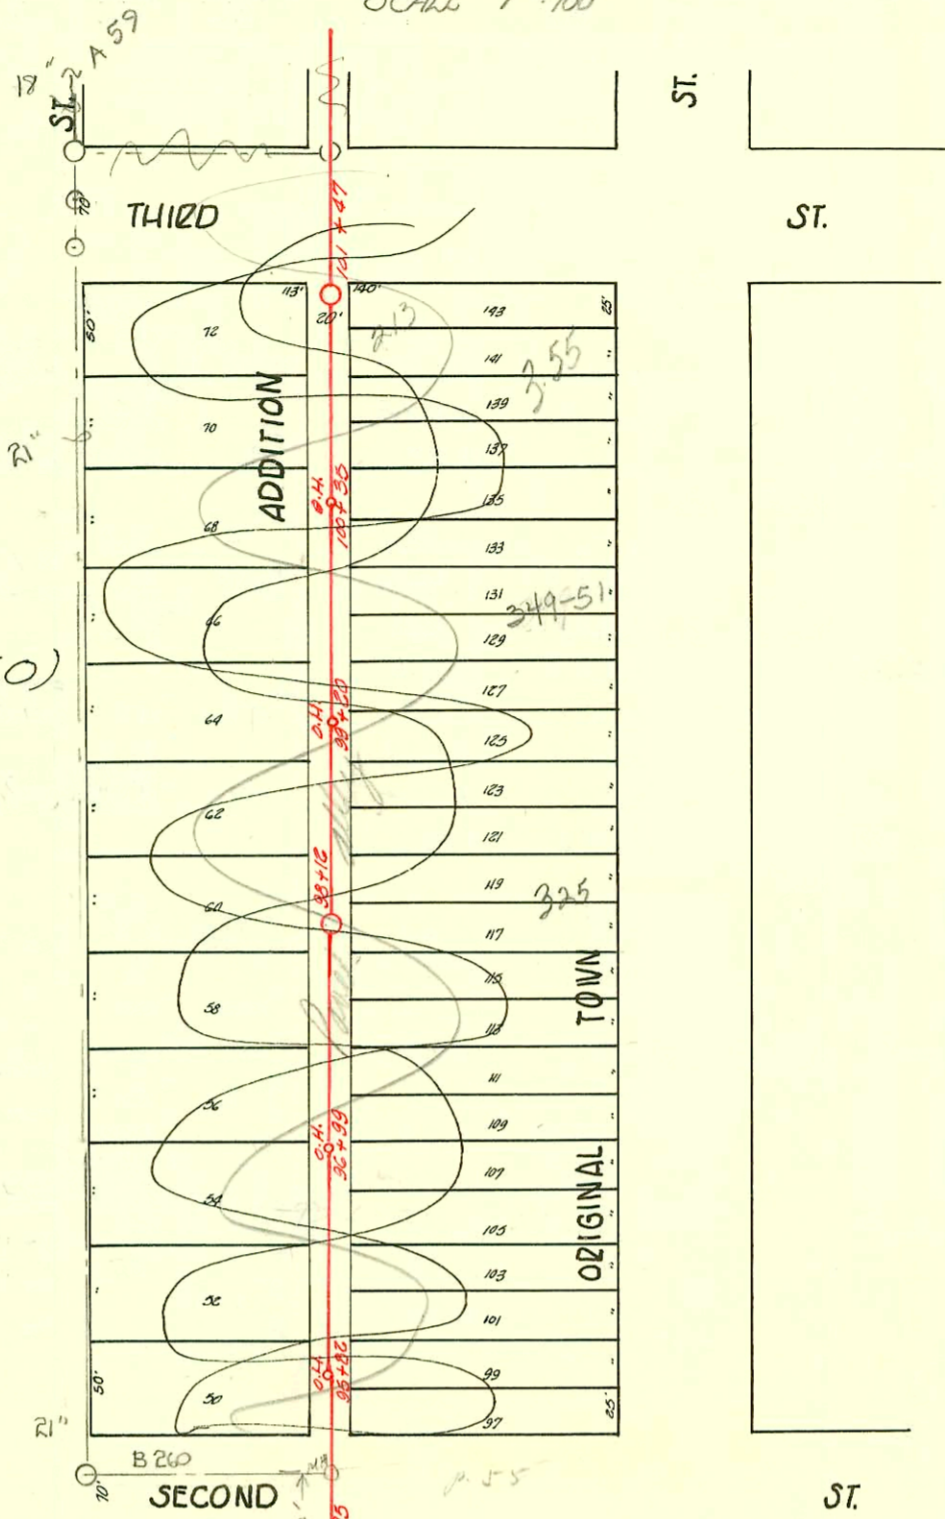

New line fm corner of 1st & Water to alley w. of water in 1st - as set by flow crew 7-22-76

20" A 49

