


EAST SUB MAIN "A" ON NINTH ST & LAT. N.
EAST SUB MAIN "A" ON TENTH ST & LAT. N.

TRAP AREA

Plot 9-43

S.S #1-1889

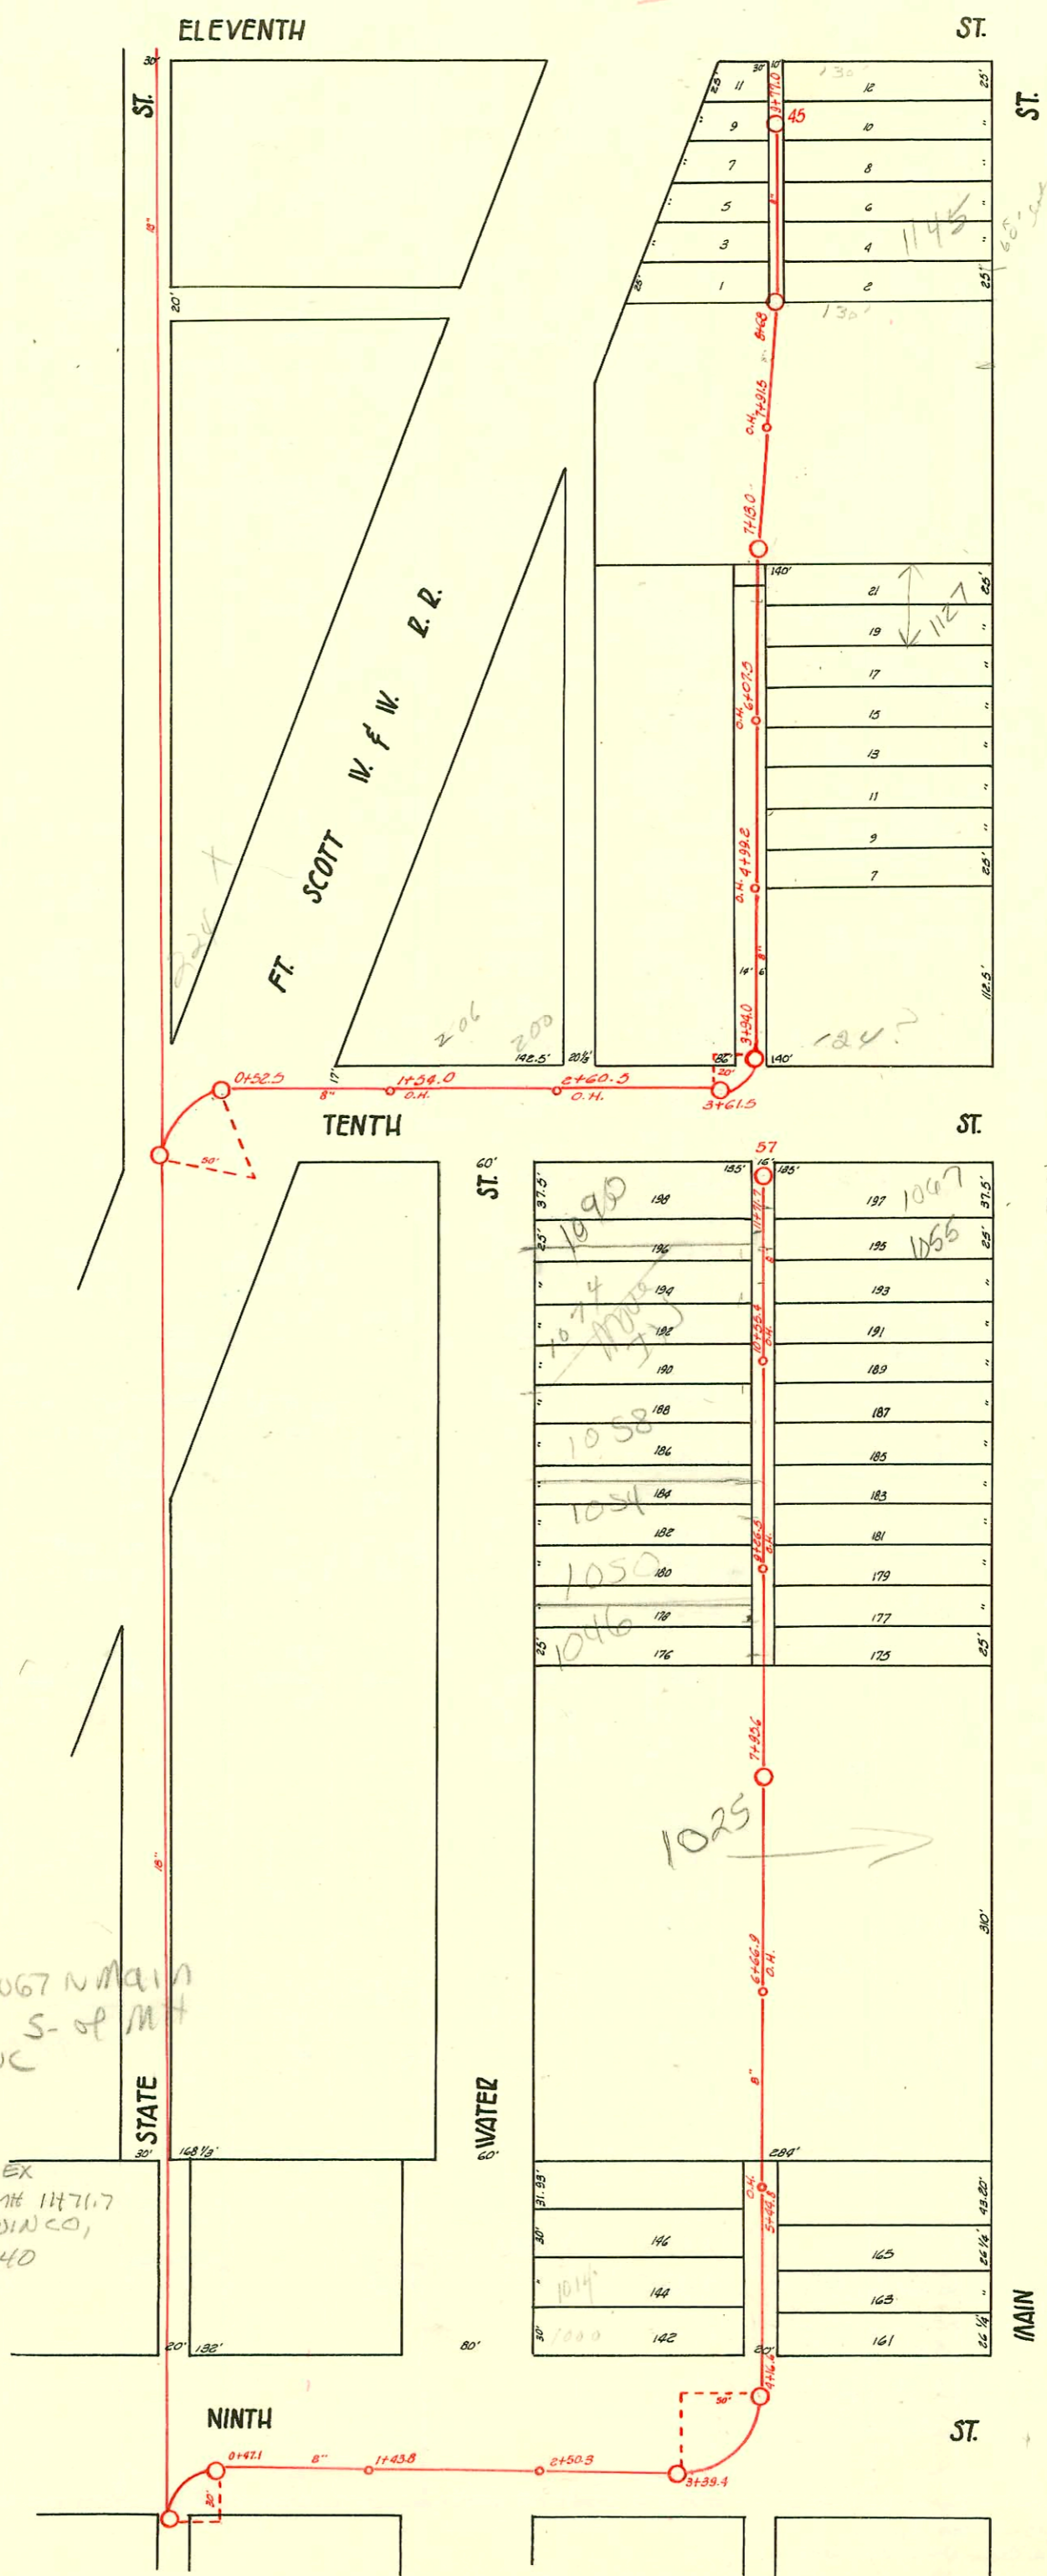

99-3043-7 3-5-97 1067 N Main
 ABC/lot: City trap 9' S of MH
 Alley cut 4" sch 40 PVC

99-4380-7 - 4/2/99 -
 1050 N Water - Padgett Ex
 Donut into 4 2466' S of MH 1471.7
 (9+25.1) 2V45, 1VH, 1TWIN CO,
 Trap installed - 4" SCH 40

2003-01422 1055 N Main 5/29/03
 HD Mills - s/o 4" SDR35 line 23'
 N of SPL + 12' from main. No
 alley cut

N/C 2001-01956 - 8/8/01 - 1025 N Main (Park Elem. Bldg Addn) City Repair - 4" Predco
 167.6' S of MA 7495.6 (6+28) 4 Dir CO, 2H22, 1V45, 4" 40PVC, 1 Trap
 s/o 2002-01059 - 4/12/02 - 1025 N Main - RTC Professional SVC - s/o portable bldg facing main

5600-1060 N Water 4-13-82 Onsite

