A 87

WEST SUB MAIN "A" ON THIRTEENTH ST. & LAT. N.
S.S. #1 – 1889

Plat 9-10

TRAP AREA

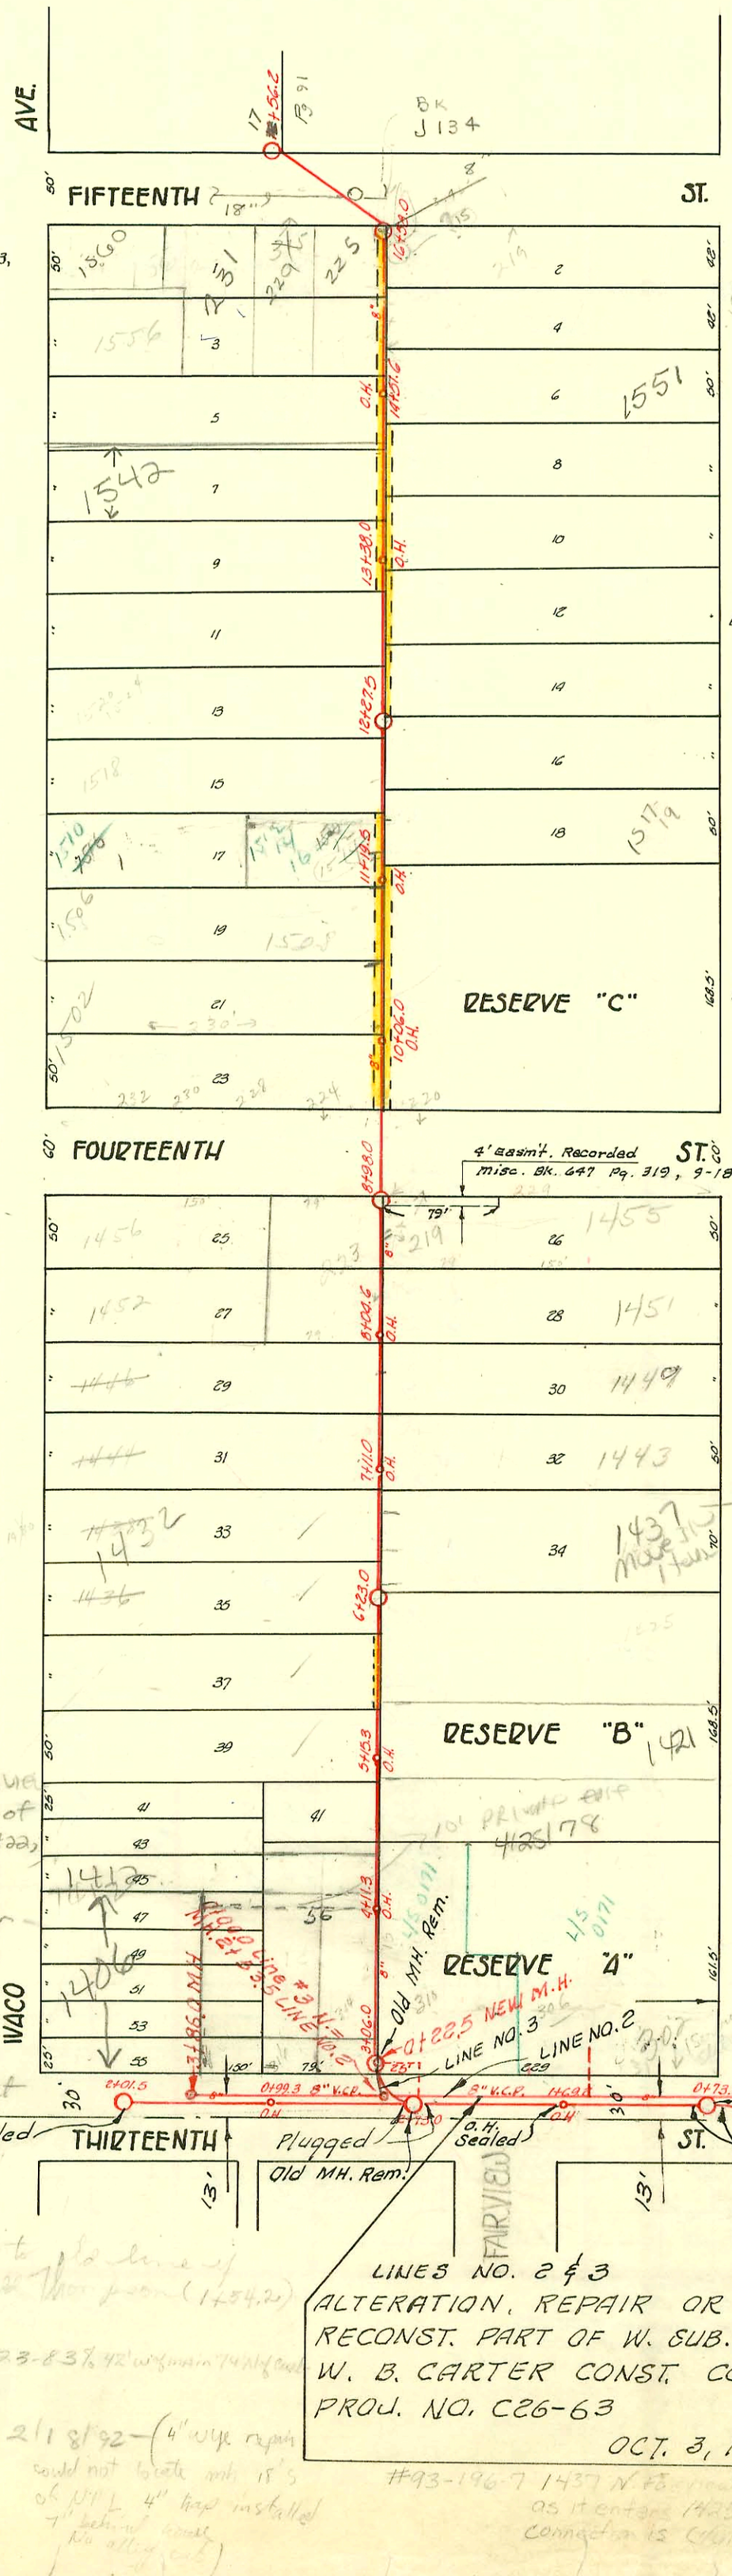

Easement No. 111 – On East 89' of Lots 1 & 3, except South 2½' of Lot 3.

Easement No. 67 – On East and of South 2½' of Lot 3 & Lots 5, 7, & 9

Easement #18 – Lots 8 & 10.

Easement #68 – Rear of Lots 12 & 14

Easement #268 – Lots 17 & 19.

Easement #240 – Lots 21 & 23.

Easement #1 – On West line of Reserve "C".

Easement #171 – Lot 37.

House Moved (1) From 911 N. Topeka

SWR 2002-02756 · 10-702 1437 N Fairview
McCullough: 6" Predco, City Repair, 31.8' N of MH 6+23 (6+54.8) 6x4 Bush, 1 V45, trap, 1 H22, 1 Dir Co, 4" 40 PVC, 1 Twin Co, 1-6x4 Bushing

2001-01115-5/8/01-1551 N. Fairview – Roto Rooter – 4" SCH40 – 1 Twin Co – No MSMT

2001-00418-2/27/01-1406 N Waco – Overnight 4" trap installed 113' N of MH 0+22.5 (1+35.5) 6" clay to 4" Ferneo 20' from Bldg F.T. or O.H. Sealed Main runs N/S 220' E of WPL

@ 59876-1406 N. Waco – ... to line of Preible – 2-11-77 – ... (1+54.2)

S/O #8495 – 316 W. 13th Kenning 6-23-83 42' w/s main 74 N/s ...

#2113 – 1517-19 W Fairview McClung – 2/18/92 – (4" wye repair could not locate mh; 15's of 4" trap installed 7" below ... No alley (AB)

LINES NO. 2 & 3
ALTERATION, REPAIR OR RECONST. PART OF W. SUB. A & E. SUB. A, S. S. NO. 1
W. B. CARTER CONST. CO. SEPT. 1966
PROJ. NO. C26-63 BK. NO. K-89
OCT. 3, 1966

#93-196-7 1437 N Fairview – S/O – Sealed off. Line at property line as it enters 1425 N Fairview. Do not know where connection is (AB).

Form 41-(54) 12-54

CONSTRUCTION RECORD

STATION	ELEVATION Ground	ELEVATION Grade	Depth	MANHOLE	4-INCH "Y" BRANCHES North West	4-INCH "Y" BRANCHES South East
2	118.76	114.74	4.02	+01.5 F.I.		
					+99.0	
					+82.8	
					+60.0	
					+33.2	
1	118.59	114.34	4.25		+07.8	
				+99.3 O.H.		
					+78.6	
0					+37.0	
	120.20	116.80	3.40	+56.2		
16					+50.4	+48.4
	120.02	116.56	3.46	+59.0		
					+30.0	+28.0
15	120.19	116.44	3.75	15	+05.8	+03.8
					+81.0	+79.0
				14 +51.6 O.H.	+56.0	+54.0
					+31.7	+29.7
14	119.69	116.24	3.45	14	+06.8	+04.8
					+80.7	+78.7
				13 +38.0 O.H.	+58.5	+56.5
					+36.0	+34.0
13	119.76	116.04	3.72	13	+05.5	+03.5
					+81.4	+79.4
					+55.6	+53.6
				12 +27.5	+30.8	+30.8
12	120.25	115.84	4.41	12	+09.0	12 +07.0
					+84.6	+82.6
					+60.4	11 +58.4
				+19.5 O.H.	+36.2	+34.2
11	120.89	115.64	5.25	11	+11.8	+09.8
					+87.3	+85.3
					+64.0	+62.0
					+37.0	+35.0
10	120.38	115.44	4.94	+06.4 O.H.	+12.7	+10.7
				9	+88.0	9 +86.0
9	120.03	115.24	4.79	9	+64.0	+62.0
				8 +98.0		T# 9+01
					+75.2	+73.2
					+51.5	+49.5
				8 +04.6 O.H.	+27.0	+25.0
8	120.03	115.04	4.99	8	+03.0	8 +01.0
					+79.0	7 +77.0
					+54.6	7 +52.6
				+11.0 O.H.	+30.0	7 +28.0
7	119.68	114.84	4.84	7	+05.8	7 +03.8
					+81.2	6 +79.2
					+56.8	6 +54.8
				6 +23.0	+32.6	6 +30.6
6	119.54	114.64	4.90	6	+04.5	6 +02.5
					+76.4	5 +74.4
					+51.7	5 +49.7
				+15.3 O.H.	+25.7	5 +23.7
5	109.02	114.44	4.58	5	+02.0	5 +00.0
					+66.0	+64.0
						+38.0
4	119.12	114.24	4.884	+11.3 O.H.		+13.7
					+86.0	+84.0
						+59.6
					tap (3+70)	+33.7
3	119.05	114.05	5.00	+06.0		
2	118.54	113.94	4.60	+73.0		
1	119.26	113.44	5.82	+69.2 O.H.		
0	119.35	113.35	6.00	+93.2		
LINE 2 0+00	119.4	113.16	6.2	0+00 LINE 2 = 0+52.3 LINE NO. 1		
1+00	119.1	113.46	5.6		1+19.0 Con. N.	
2+00	119.0 / 119.0	113.76 / 113.98 out / 114.84 in	5.2 / 5.1 / 5.0	2+53.5		
3+00	119.0 / 119.0	114.11 / 114.45	5.9 / 4.5	3+86.0		
LINE 3 0+00	118.8 / 119.8	114.04 / 114.11	4.8 / 5.7	0+00.0 Line #3 = 2+53.5 Line #2 New MH = 0+22.5		

SERVICE RECORD

No. of Permit North West	No. of Permit South East	House Number North West	House Number South East	DATE OF PERMITS North West	DATE OF PERMITS South East
#61		357 W. 13th		3-11-07	
#567	#2909	315 W. 15th / 1556 N. Waco	619 W. 15th St.	10-17-10	10-27-42
#216	#220	1558 Fairview		5-26-16	12-19-96
#4140		1538 N. Waco		4-8-55	
#1171		1544 N. Waco		8-20-19	
#1999-00579		1542 N. R Waco		9-2-99 / 9-3-20	
#681					
	#1380		1533 Fairview		3-13-39
#13		1530 N. Waco		1-12-11	
#234		1532 N. Waco		5-2-13	
#1601		1540 N. Waco		9-3-19	
	#285		1521 Fairview		8-4-21
#168		1518 N. Waco		8-31-07	
	#292		1523 Fairview		4-15-21
#796		1514 N. Waco		3-27-19	
#4721		1506 N. Waco		4-4-53	
	#121		1511½ Fairview		9-24-03
#4722 (joey folsom)		1508 N. Waco			4-4-53
		? (1502) 1508 N. Waco			
#521				8-19-09	
#115		226 W. 14th		5-28-06	
	C21133		1455 Fairview		9-28-70
	#256		1453 Fairview		12-22-05
	#C17636 #259		223 W. 14th St. Waco / 1456	? EAST Wing	1-13-70 / 1-6-06
#61	#335	1452 N. Waco	1457 Fairview	4-30-07	9-14-04
	C60633		1449 Fairview		4-6-77
C11996	#302	1446 N. Waco	1447 Fairview	12-17-68	12-15-08
C11751	#423	1444 N. Waco	1447 (1443) Fairview	12-2-68	8-6-31
C11137 #209	#718	1438-40	1523 ? Fairview ?	10-29-68 / 11-23-92	8-19-26
#632		1432 N. Waco		11-21-13	
#37		1436 N. Waco		3-13-06	
C11138				10-29-68	
C11750	#575	1420 N. Waco	1421 Fairview	12-2-68	10-19-10
	#681	1416 N. Waco	1417 Fairview	10-29-68	11-1-09
C11137 #50				6-23-09	
	#222		Fair-view		11-13-05
#121		314 W. 13th		3-11-10	
	#378	312 W. 13th	310		6-19-09
C39569		314 W. 13th St.		6-19-73	

Alteration, Repair or Reconst. W. Sub. A. & E. sub A, S. S. No. 1

#2-Private Line-1560 N. Waco-3-8-23
#?-Private Line-209-211 N. 15th-6-4-26
#?-Tap-219 N. 14th-12-6-37-Johnson Plbg. Co. (8+71)
#?-Tap-219 N. 14th-12-6-37-Johnson Plbg. Co.
#2680-Tap-1510 N. Waco-Frederick Plbg.-9-26-52
#4722-Tap-1508 N. Waco-Lex Robertson-8-14-53

Tap C34315 - 1432 N. Waco - Jay Sartin - 8-16-72 (MH Tap - 6+23°)

So. C42882 - 1402 N. Waco - 12/27/73 (sealed 85' N. - 1404 q 5 P/L) - 1416 N Waco see next pg / 322 N. 13th - 1 " / 320 " / 318 " } all addresses sealed with 1402 N. Waco

tap 7" south replaced lower 25' of line to point.)