


TRAP AREA

EAST SUB MAIN "B" ON LEWIS ST. f LAT. N. f S.  
S.S. #1-1889

Plat 9-53

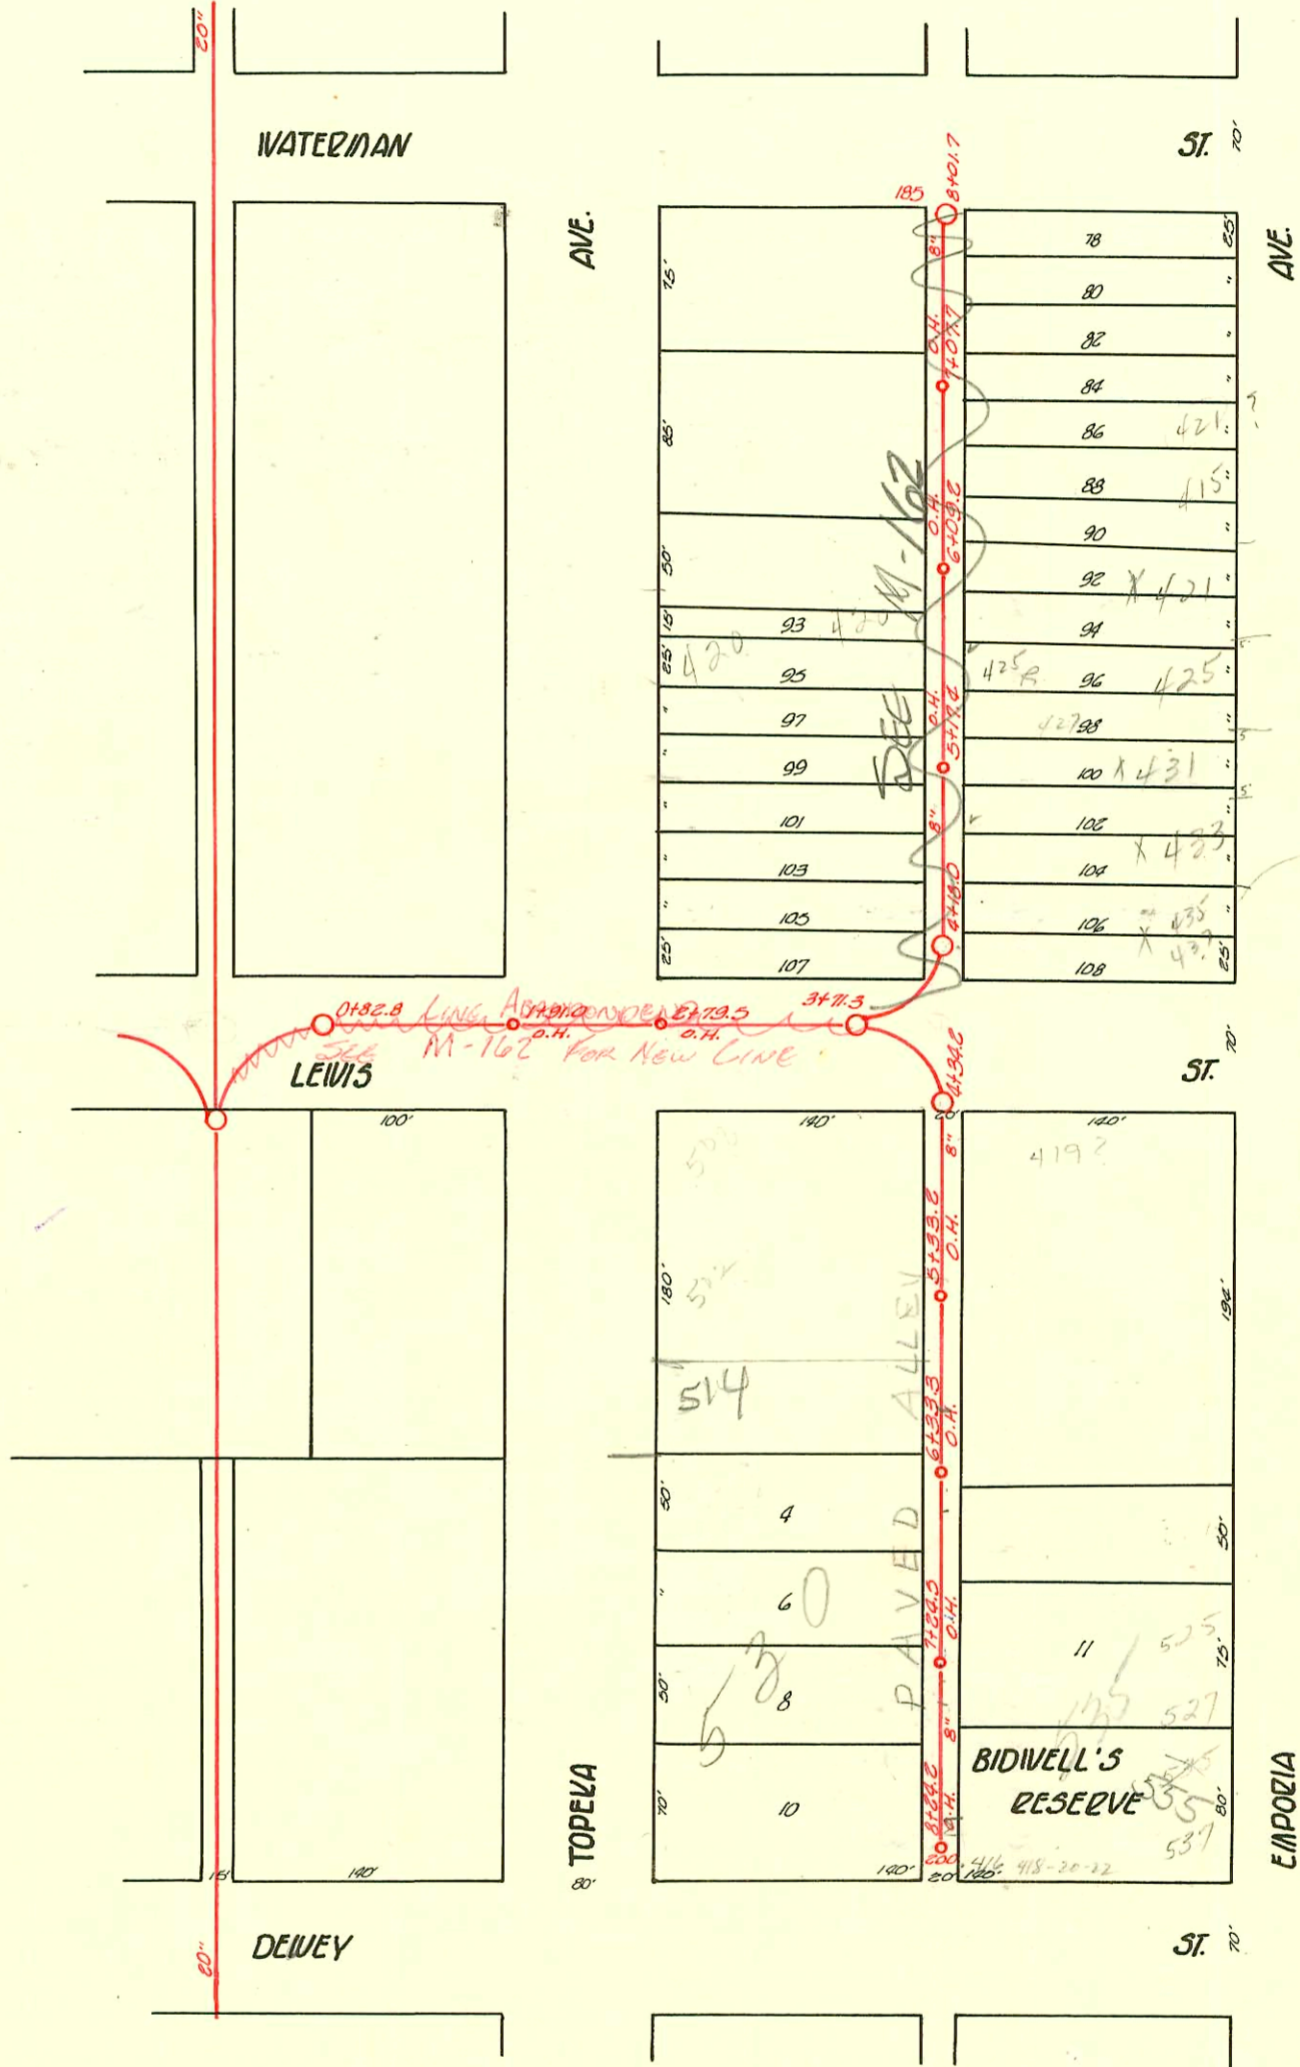

SWR 2053-03368 12/24/03 514 S TOPELA McCullough sealed w/ concrete  
12' from main

