A 163

EAST SUB-MAIN "B" on ELM ST. and LAT. "A"
EAST SUB-MAIN "B" on MURDOCK AVE. and LAT. "S"
S. S. No. 1 - 1889

Plat 9-47

TRAP AREA

Murdock Sanitary Sewer Replacement
from WICHITA to WABASH
468-82707 OCA # 621763

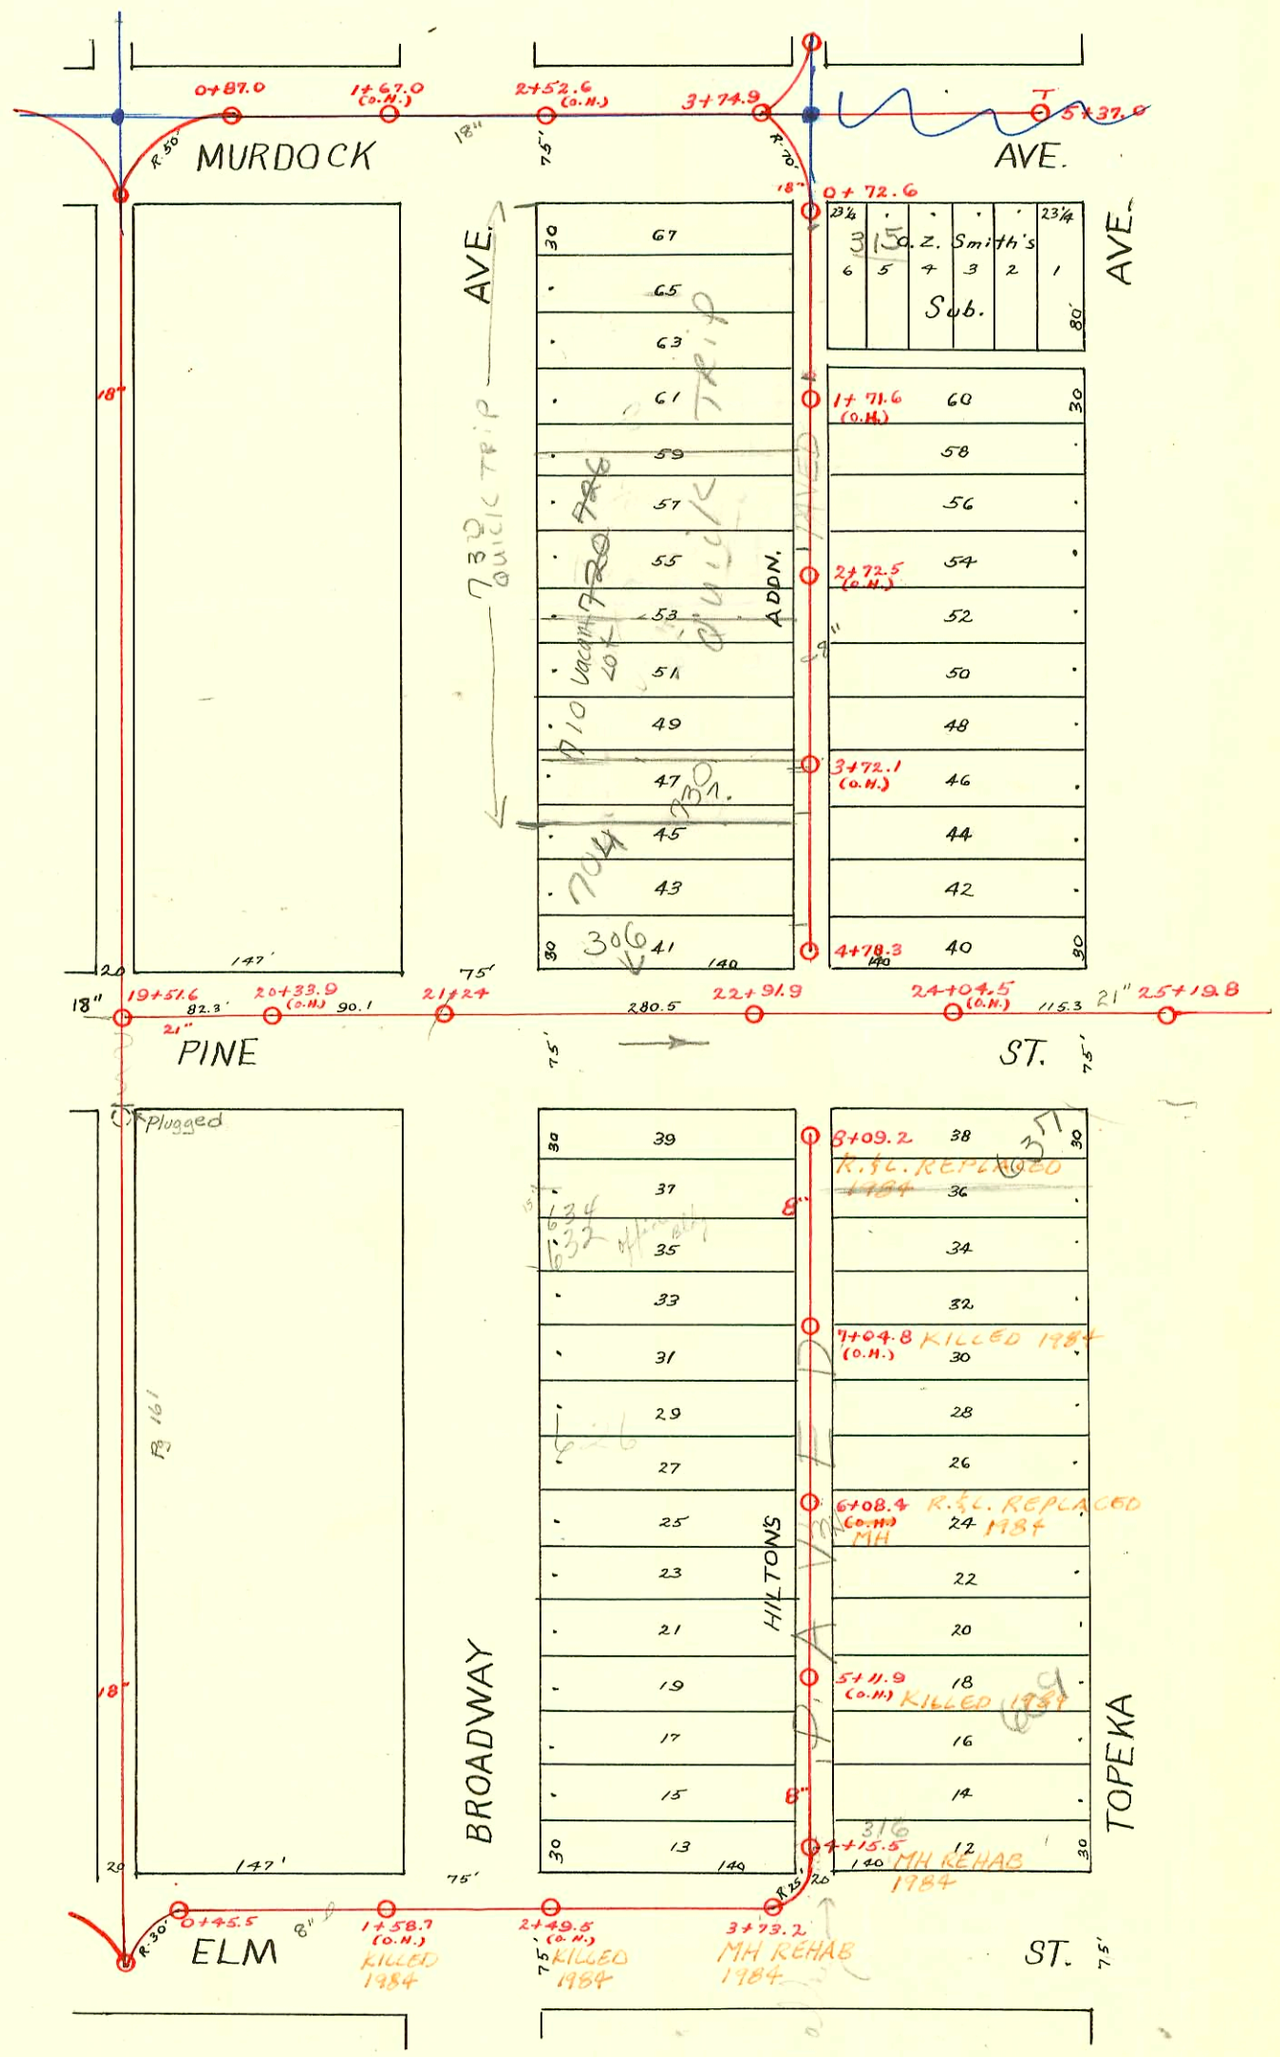

2001-01003- 4/26/01 - 631 N TOPEKA - CK CONTRACTING - 4" SCH 40 & 6" SCH 40 - Tied back to clay tile, used existing trap, did not replace - 5 TWIN CO, 5 KICKOUTS, 1422

23333 - 6-8-89 Alt 20 so. Broadway - Henning - (3+29.3)
26953 - 7-28-91 637 N. Topeka sta - Henning - (sealed 4' N of SPL and 26' E of WPL)

Form 41-(54) 12-54

CONSTRUCTION RECORD / SERVICE RECORD

STATION	ELEVATION Ground	ELEVATION Grade	Depth	MANHOLE	4-INCH "Y" BRANCHES North West	4-INCH "Y" BRANCHES South East	No. of Permit North West	No. of Permit South East	House Number North West	House Number South East	DATE OF PERMITS North West	DATE OF PERMITS South East
	112.49	109.86	2.63	4 + 78.3								
					4 + 65.0	4 + 67.0	#662		702 N. Broadway		6-21-28	
					4 + 47.7	4 + 39.8						
					4 + 24.0	4 + 26.0	77-8010-7	#318	704 N. R Broadway		5-21-97	5-22-14
4	112.59	109.68	2.91		~~4 + 00.0~~ 3+77.3	4 + 02.0	#23331 #126		704 N. Broadway		6-8-89 10-10-03	
					3 + 76.0	3 + 78.0	#48				4-11-93	
					3 + 52.0	3 + 54.0						
					3 + 28.5	3 + 30.5						
3	113.07	109.43	3.64		3 + 04.0	3 + 06.0		#70				5-16-05
					2 + 80.4	2 + 82.4		#1392			11-20-19	
					2 + 57.2	2 + 59.2	#42	#237	722 Bdwy	735 N. B Topeka	6-28-95	10-29-85 4-20-10
					2 + 33.4	2 + 35.4		#600				3-23-08
2	113.27	109.18	4.09		2 + 09.7	2 + 11.7						
					1 + 86.0	1 + 88.0						
1					1 + 62.2	1 + 64.2	#641	#123	730 Bway	Quick Tap 737 Topeka	11-24-13	10-15-90
0	113.80	108.86	4.94	0 + 72.6	0 + 81.6 TAP	0 + 77.1	22413	15312			1-13-89	
				5 + 37.0								
					5 + 26.0	5 + 24.0						
5	114.09	109.20	4.89		5 + 04.0	5 + 02.0						
					4 + 82.3	4 + 80.3						
					4 + 60.0	4 + 58.0						
					4 + 37.7	4 + 35.7						
4					4 + 15.6	4 + 13.6		#409				7-2-09
	113.11	108.68	4.43	3 + 74.9								
					3 + 65.4	3 + 63.4						
					3 + 22.2	3 + 41.5						
3	112.91	108.51	4.40		3 + 00.3	3 + 20.2						
						2 + 98.3		?				12-27-00
					2 + 78.2	2 + 76.2	#135				8-7-94	
2	113.46	108.26	5.20		2 + 57.0	2 + 55.0						
					1 + 52.0	1 + 50.0						
					1 + 32.3	1 + 30.3						
1					1 + 12.8	1 + 10.8						
	113.09	108.98	4.11	0 + 87.0	0 + 92.8	0 + 90.8						
					0 + 66.0	0 + 64.0						
				8 + 09.2								
8	112.53	109.80	2.73		8 + 04.0	8 + 02.0	#5				2-25-95	
					7 + 86.0	7 + 84.0						
					7 + 61.7	7 + 59.7	C13989		632-34 N. Broadway		5-8-69	
					7 + 41.0	7 + 39.0						
7	112.59	109.55	3.24		7 + 13.7	4" SCH 40 7 + 11.7		#2001-01003 #1634	631 N. R Topeka	See next pg		4-26-01 11-15-29
					6 + 89.5	6 + 87.5		#1635	631 N. Topeka			11-15-29
					6 + 65.0	6 + 63.0		#792	625 N. R Topeka			7-1-29
					6 + 41.0	6 + 39.0		#793	625 N. Topeka			7-1-29
6	112.78	109.30	3.48		6 + 17.2	6 + 15.2						
					5 + 92.6	5 + 90.6		#285				12-4-08
					5 + 68.0	5 + 66.0		#36				5-25-95
					5 + 43.0	5 + 41.0						
5	112.72	109.05	3.67		5 + 19.8	5 + 17.8	C-72 #599 #102 #61	#25	608 N Broadway 610 N. Broadway 604 N Broadway		8-26-63 12-21-12	5-1-95 5-13-35 5-26-33
					4 + 96.0							
					4 + 71.6	4 + 94.0						
					4 + 47.0	~~4 + 69.6~~		C68547	603 N. Topeka			10-10-78
	112.93	108.84	4.09	4 + 15.5	4 + 21.0	4 + 45.0		C68548 #46	603 58 N. Topeka			9-26-78 3-29-06
4						4 + 08.5		C47383	314 E. S.O. Elm			11-15-74
3	112.58	108.71	3.87	3 + 73.2				C48065	316 E. Elm			1-16-75
2	113.84	108.30	5.54			Jp.		C68545	603 N. Topeka			9-26-78
1	112.60	108.05	4.55									
0	112.77	107.91	4.86	0 + 45.5								
19	113.14	107.84	5.3	19 + 51.6								
20	112.99	107.72	5.27									
21	112.99	107.53	5.46	21 + 24								
24												
25	112.97	107.28	5.69	25 + 19.8								

15309 - 737 N. S.O. Topeka - 12-19-85 - Buckley 0+72.6 S.
N/R 15312 - 737 N. Topeka 12-19-85 " 0+72.6 N.

Tap - #1634 - 631 N. Topeka - 11-15-29 - Simmons Plbg.
Tap - #1635 - 631 N. Topeka - 11-15-29 - Simmons Plbg.
Tap - #277 - 632 N. Broadway - 11-15-35 - C. C. McLaughlin
#3104 - 724 N. Broadway - 2-8-41 - M. L. Lansdowne - Used old connection
#3090 - 638 N. Broadway - 10-31-52 - Davidson Plbg. - Setting 6" wye
16562 - Seal off - 600 N. Broadway - 1-10-63 - Darrell Williams
B4494 Seal off 716 N. Broadway 11-8-65 Jennie Olson

#23332 - 6-8-89 - 710 N. Broadway S.O. - Henning (3+57.3)

#22114 - 11-28-88 - 307-311 N. Murdock S.O. - Henning - Tied to Sewer for 736 & 738 B way 53' S. of 0+72.6
#22115 - 11-28-88 - 736 38 N. Broadway S.O. - Henning
#22116 - 11-28-88 - 732 N. Broadway S.O. - Henning - 1+62.6
#22117 - 11-28-88 - 730 N. Broadway S.O. - Henning - 1+66.6
#22118 - 11-28-88 - 726 N. Broadway S.O. - Henning - 2+13.6
#22119 - 11-28-88 - 720 N. Broadway S.O. - Henning - 2+57.2