


Plat 9-50

TRAP AREA

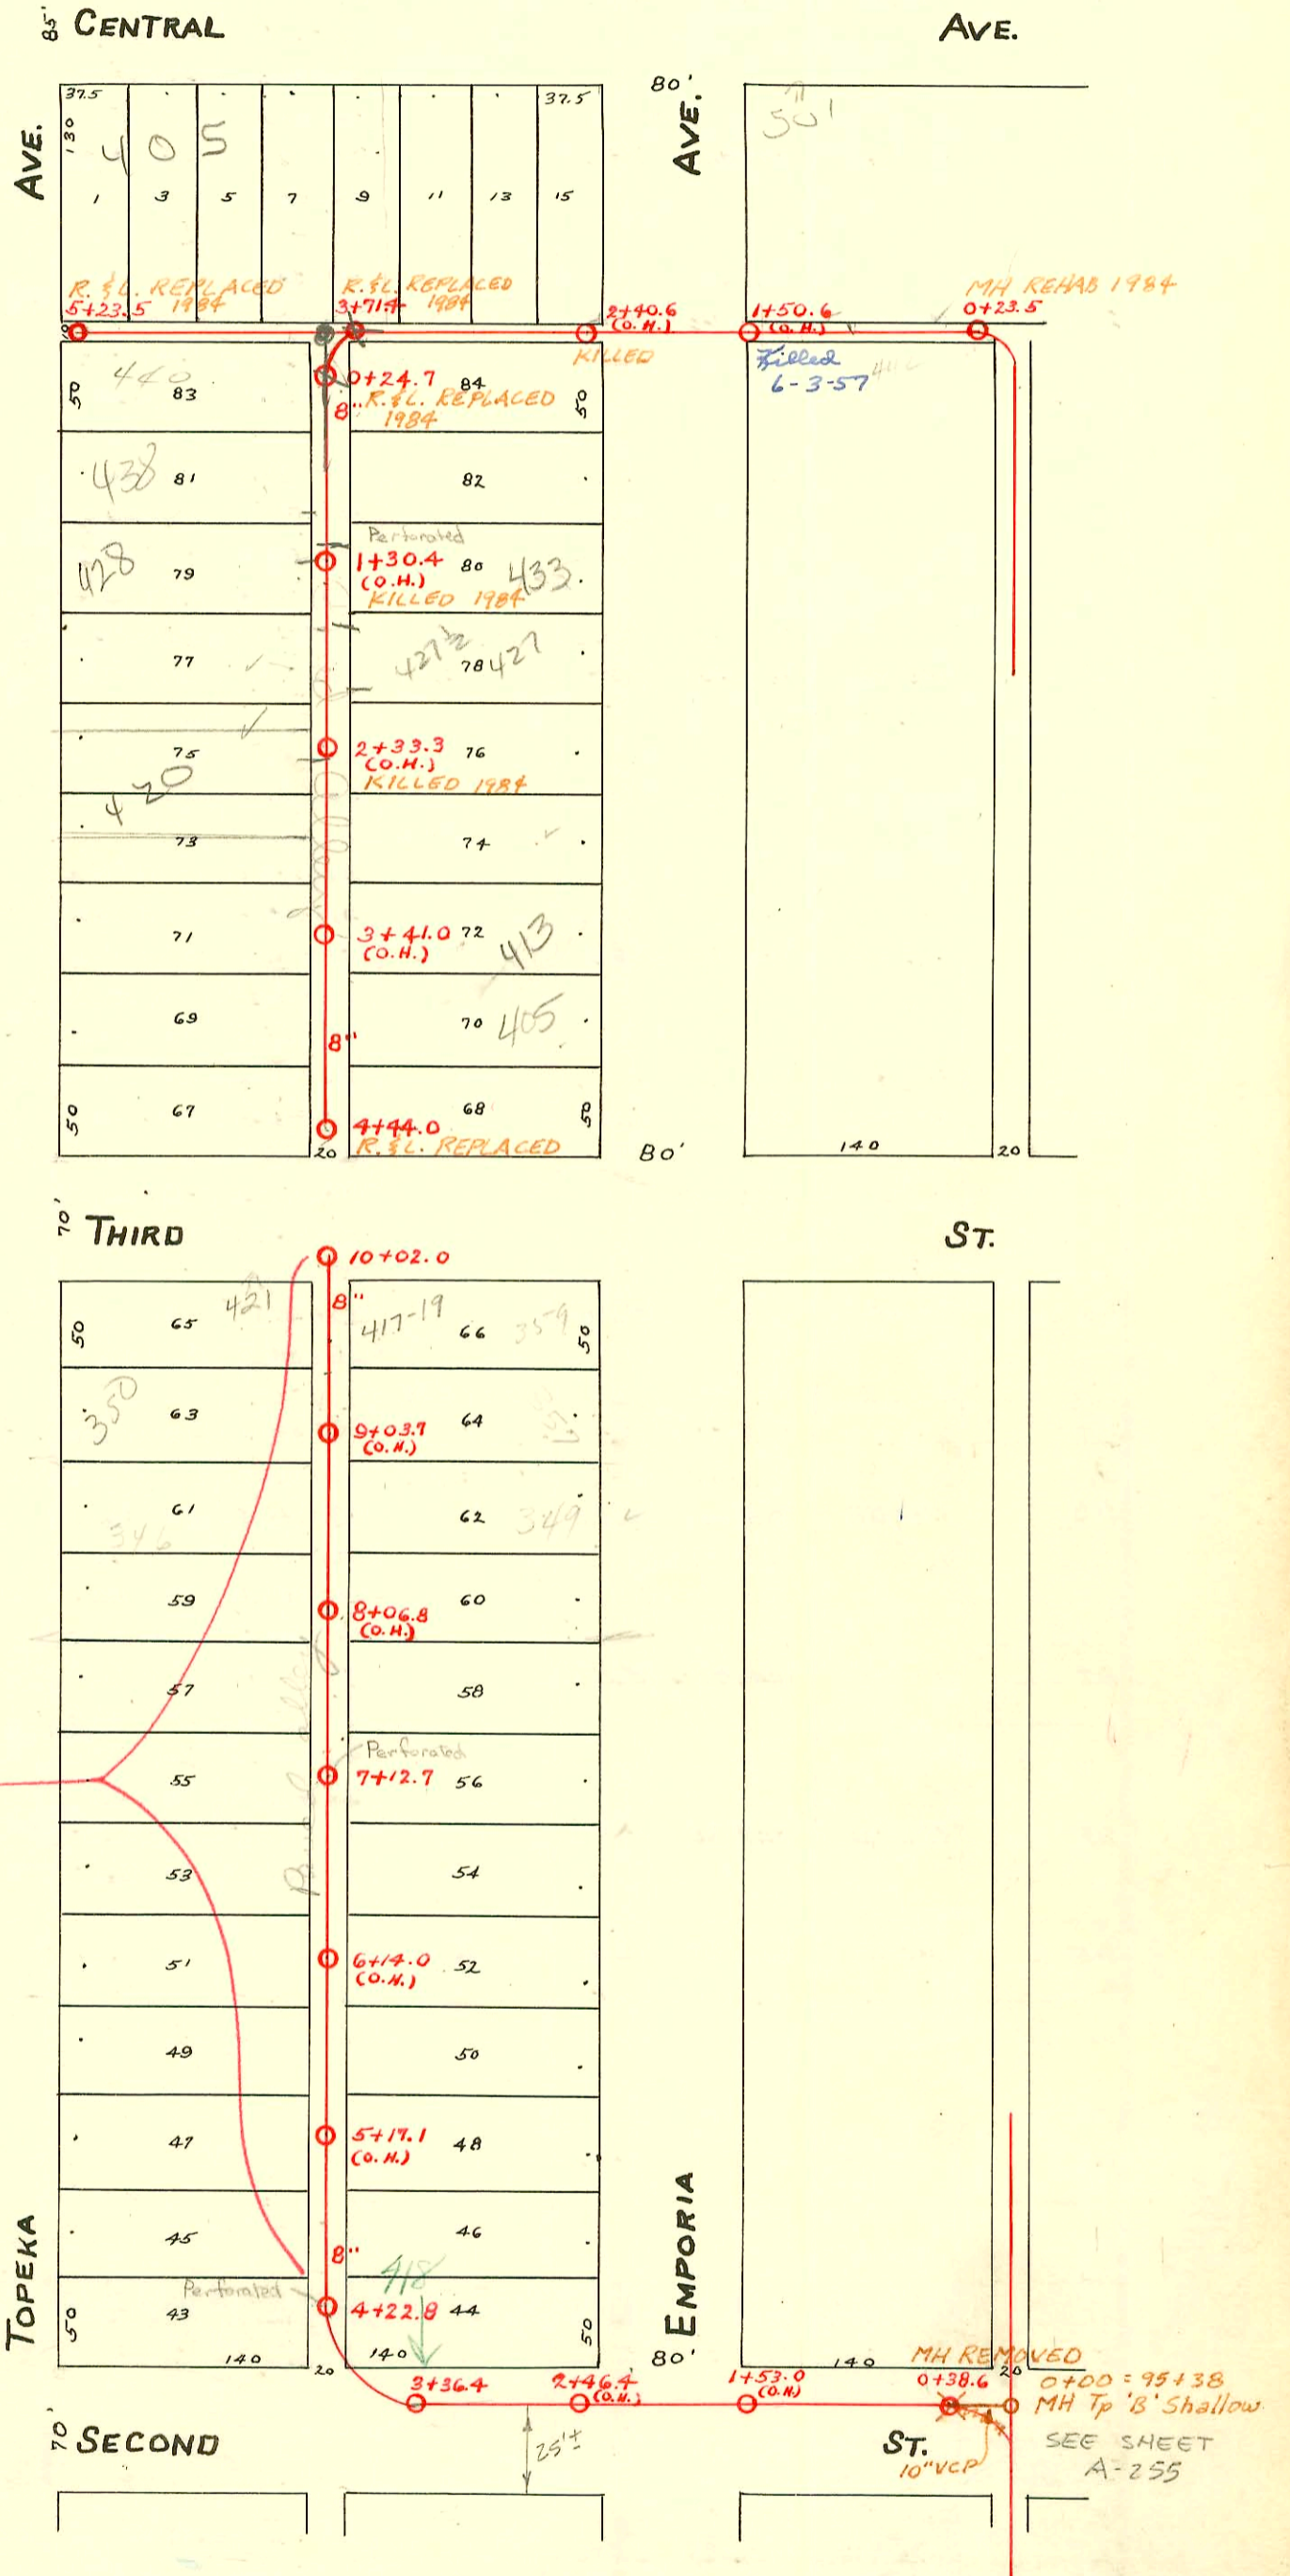

CONSTRUCTION RECORD						SERVICE RECORD						
STATION	ELEVATION		Depth	MANHOLE	4-INCH "Y" BRANCHES		No. of Permit		House Number		DATE OF PERMITS	
	Ground	Grade			North West	South East	North West	South East	North West	South East	North West	South East
Sewer Rehab... Dist 1 & 20 North of 2nd St. Between Topeka & Emporia												
0+00	111.7	107.40	4.3	0+00	0+00 6" SERV. W.							11-2-84
					0+56 6" SERV. W.							11-5-84
1+00		107.70										
					1+27 6" SERV. W.							11-6-84
2+00		108.00										
	112.5	108.27	4.2	2+90								
3+00		108.30			2+97 6" SERV. W.							11-8-84
					3+79.5 6" SERV. W.		93-29159-1		405 N 210 Emporia			11-24-84 11-9-84
4+00		108.60										
5+00		108.90			5+13.5 6" SERV. W.		94-1954-7		350 V 210 Topeka			11-30-84 11-13-84
	112.0	109.07	2.9	5+56	5+39.5 6" SERV. W.	5+56 6" SERV. E.	93-29220-7		405 E 32			11-21-84 11-13-84 11-14-84