A 263

EAST SUB-MAIN "C" IN ALLEY No. OF CENTRAL AVE. AND LAT. N.
EAST SUB-MAIN "C" ON PINE ST. AND LAT. S.
S.S. No. 1 - 1889

Plat 9-A7

TRAP AREA

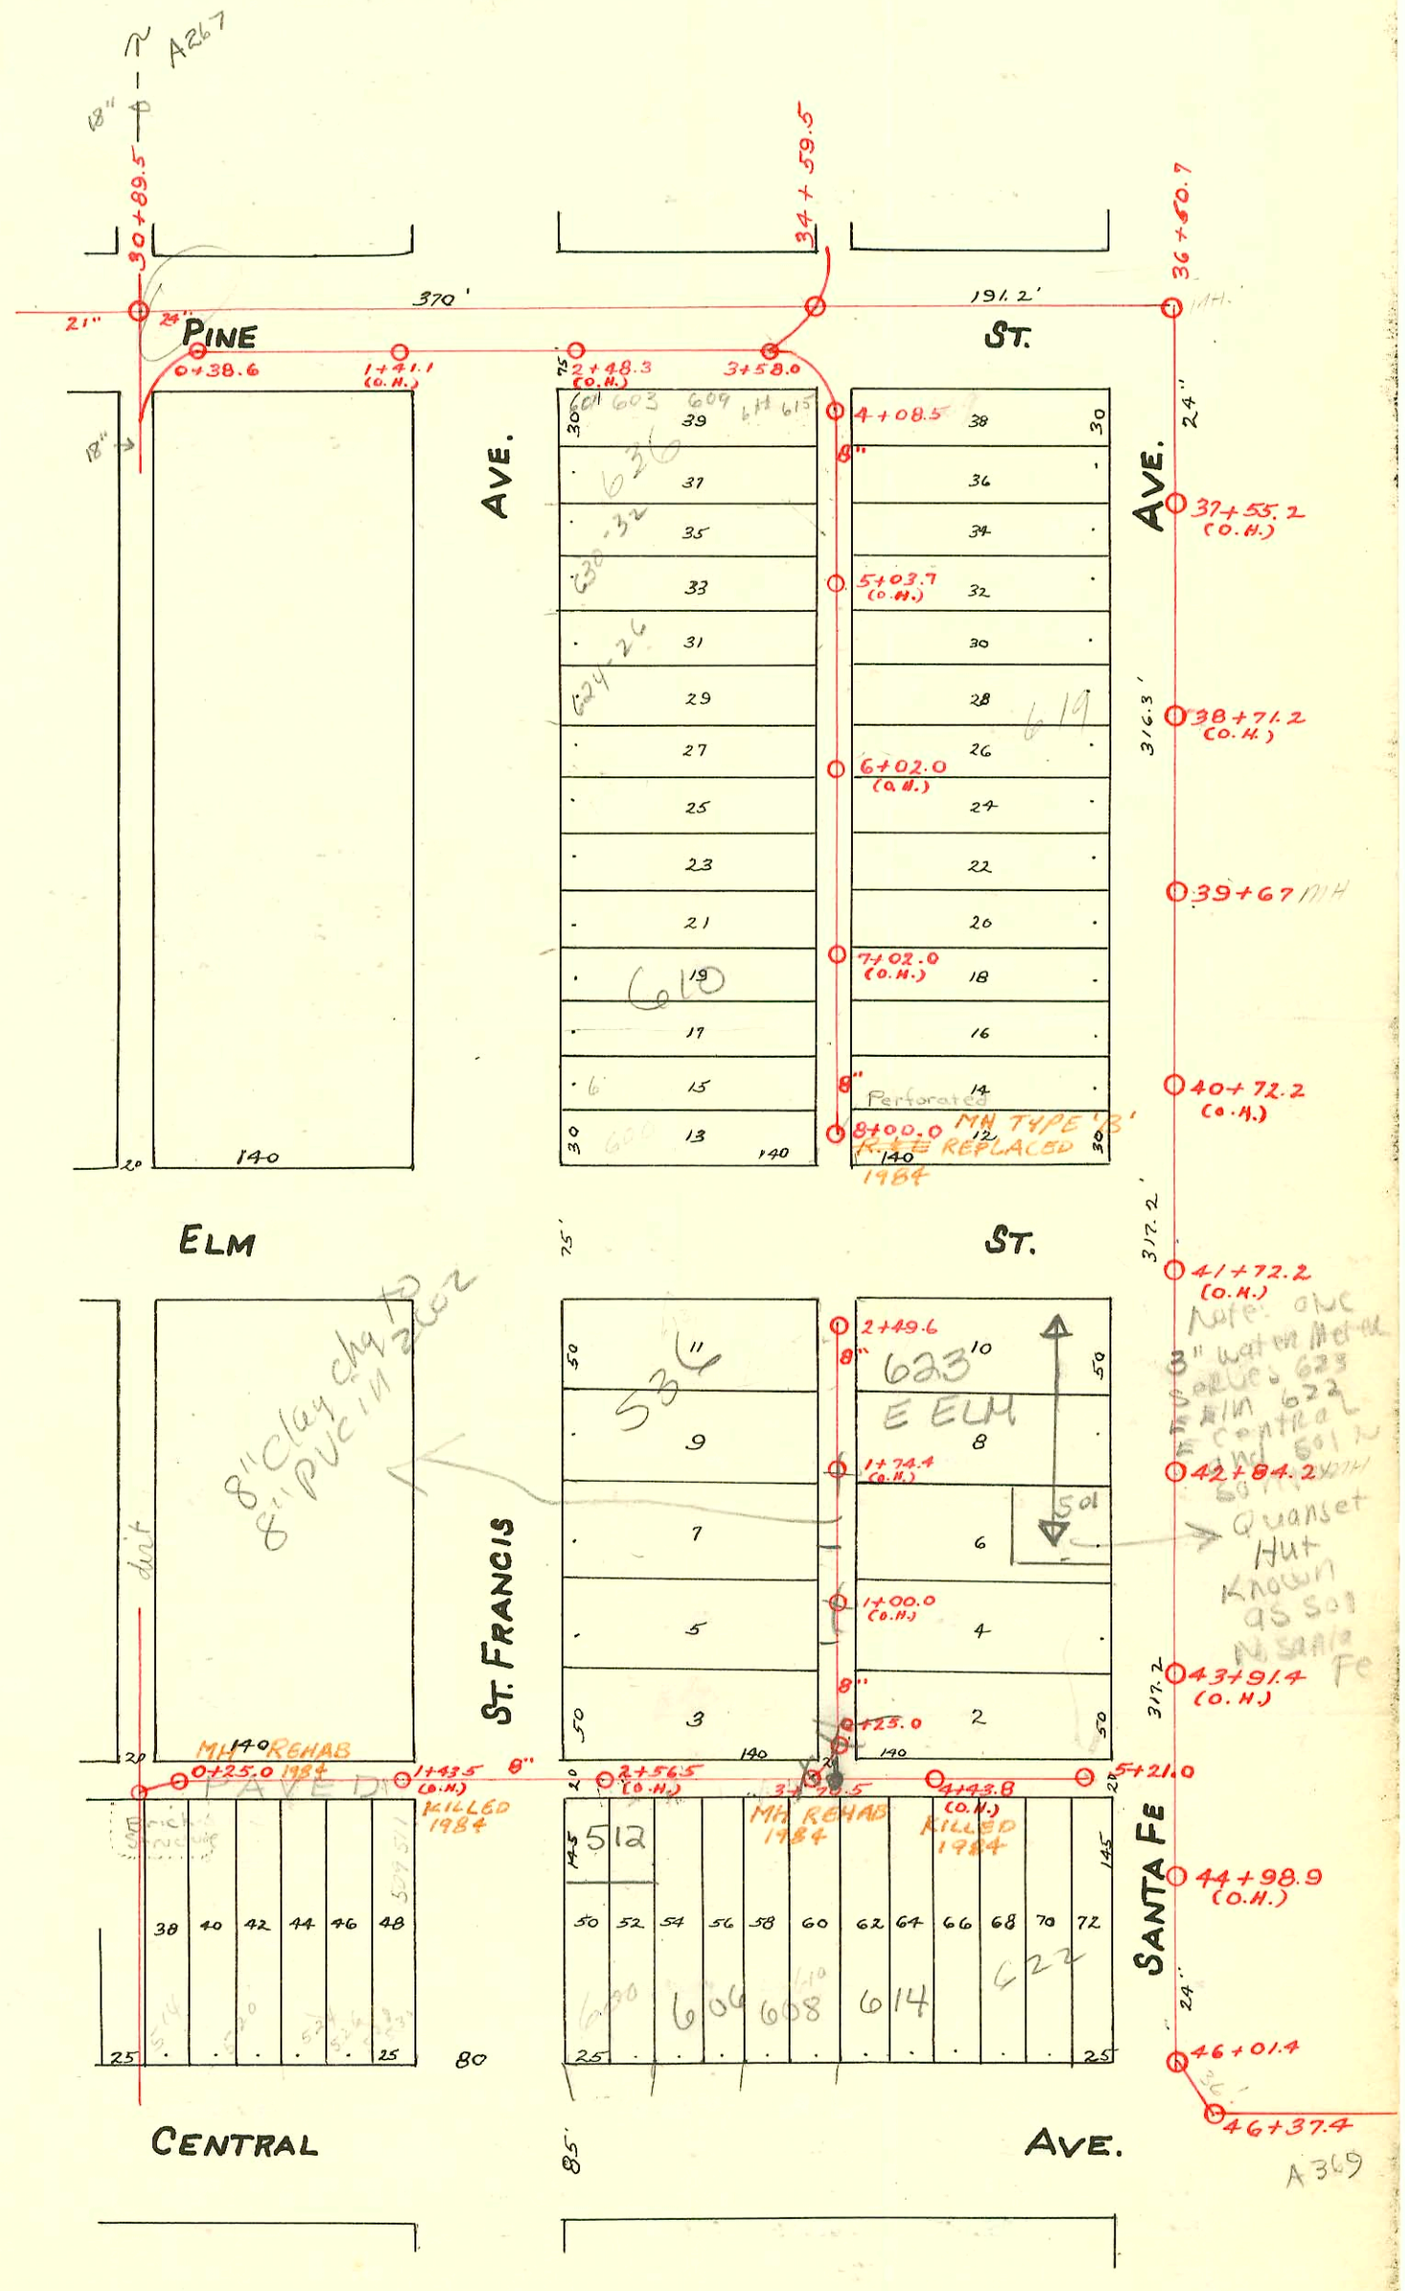

SWR2002-00110 - 610 N St Francis - Full replacement 09' N y MH, (2)22V, (1)45H, (1)22H, 4" Sch 40 PVC, Saddle (1) 1 wye c/o - AE Henning - 1-29-02
2002-00900 - 614 E Central 3/29/02 - Mies Const Twin co, 4" Sch 40, tied back to clay tile

* 624 E Central - Remodel now 622 E Central - not sure what happened with old connection - New Connect permit SWR2000-02662 under 622 E Central - 12/5/00 - Comm'l Mech - 4" SCH 40 - wye connection 4' W of MH 5+21.0 (5+17) Trap installed, 1 Twin co, 1V22, 1H22, 2 H45

2001-00777 - 4/5/01 - 501 N Santa Fe (N/C) - Comm'l Mech - 4" SCH 40 - MH STUB - (DE MH 5+21) - 1 Twin co, 1H22, 2V45, 4" TRAP
2000-02659 - 12/5/00 - 623 E Elm St - City Tap Predco 44' S of MH 2+49.6 - Commercial Mech

2001-02977 - 11/21/01 - 512 N St Francis - S/O McCullough Sealed w/concrete 94' W of MH (NOTE 512 N St Francis + 602 E Central were both tied together - 1 S/O takes care of both)
92-43322-7 11-30-92 612 E. Central S/O Henning
S/O at Alley edge 41 ft East of MH (4+11.5) 12/1/92

2003-00587 8-7-03 536 N St Francis (N/C) (Cyclotron facility) Central Air: 8x4 Saddle 88' S of MH 2+49.6 (1+61.6) 4" dir co, 5 V45 (4 for running trap) 1-4" WYE 4" 40 PVC

Form 41-(54) 6-56

CONSTRUCTION RECORD / SERVICE RECORD

STATION	ELEVATION Ground	ELEVATION Grade	Depth	MANHOLE	4-INCH "Y" BRANCHES North West	4-INCH "Y" BRANCHES South East	No. of Permit North West	No. of Permit South East	House Number North West	House Number South East	DATE OF PERMITS North West	DATE OF PERMITS South East
8	113.37	107.50	3.87	8+00.0		7+94		#487		Santa Fe		8-14-14
					7+86.7	7+84.7	#1870				12-19-23	
					7+~~62.0~~ 70.0	7+60.0	SO C31433 #196		600-606 N. St. Francis		4-7-72 10-12-07	
				Tap	7+~~33.4~~ 51.0	7+31.4	C32727		630 N. St. Francis		6-7-72	
					7+08.7	7+06.7						
7	112.92	107.20	3.72		6+84.0	6+82.0						
					6+59.0	6+57.0						
					6+35.0	6+33.0						
6	112.56	108.90	3.66		6+10.8	6+08.8						
					5+86.0	5+84.0		#2907		619 N. Santa Fe		11-29-40
					5+62.0	5+60.0						
					5+37.0	5+35.0	#33		632 N. St. Francis		3-9-06	
					5+12.0	5+10.0						
5	112.66	108.60	4.06		4+~~88.0~~ 86.0	4+86.0	#501	#1850	636 N. St. Francis	633 N. Santa Fe	7-18-17	7-10-52
					4+63.8	4+61.8						
					4+39.0	4+37.0	#C15312 #116		615 E. Pine		10-16-67 6-26-07	
				Tap 4+35.9	~~4+14.0~~	4+12.0	57739		636 N. St. Francis		9-16-76	
4	112.92	108.32	4.60	4+08.5								
3	112.83	108.17	4.66	3+58.0								
2	113.22	107.70	5.52									
1	112.88	107.40	5.48									
0	112.86	107.22	5.64	0+38.6								
				2+49.6			C43615		538-40 N. St. Francis		2-25-74 1-18-05	
					2+46.0	2+44.0	#5					
					2+28.0	2+26.0	C43613	2000	611 (615) E. Elm	623 E ELM	See Next 2-25-74 3-16-18	12-5-00
2	112.76	108.21	4.55	CITY TAP Predec	2+03.0	2+01.6 4" SCH40	#94	02659				
					1+78.5	1+76.5	C43614 #89	?	534-36 N. St. Francis SO		2-25-74 7-13-03	6-4-02
					1+54.0	1+52.0	9763 8732	#486	524-30 N. St. Francis	623 E. Elm	11-30-83	4-11-56
					1+29.5	1+27.5	#718	#1922	530 N. St. Francis	623 E. Elm	7-18-23 5-11-23	4-1-48
					1+02.5	1+04.5	8654		526 526½ N. St. Francis		7-7-83	
1	112.62	107.96	4.66									
					0+80.0	0+78.0	9762		524-26 N. St. Francis		11-30-83	
					0+55.3	0+53.3	C31243		522 N. So. St. Francis		3-29-72	
					0+30.3	0+28.3	#434				9-22-02	
0	112.46	107.77	4.69	0+25.0			9761		520-22 N. St. Francis		11-30-83	
				5+21.0						622 E Central		
5	113.54	108.03	5.51			5+19.0		#2248		624 E. * Central		4-22-40
						4+98.5						
						4+71.0		#466-Repair		New Cor Santa Fe & Central		4-3-23
						4+46.1		#291		614 E. Central	see next pg	7-28-04
4	112.11	107.78	4.33			4+21.5 4" SCH40		#259				6-25-29
						3+96.8						
						3+74.0						
	112.25	107.71	4.54	3+70.5		Seal off 3+58.2		2001-01906 #515		~~608~~ 610 E. Central S/O		5-16-01 7-30-48
						3+42.0		#16		610 E. Central		3-9-05
3	111.80	107.53	4.27			3+17.0						
						2+92.0		#96		604 E. Central		7-31-03
						2+67.2		#61		606 E Central S/O		4-19-06
2	111.83	107.28	4.55			2+43.0						
						1+47.8						
						1+27.0		C55006		530 E. Central		4-27-76
1	111.25	107.03	4.22			1+02.4		#C22733		526 E 528-30 CENTRAL		1-27-71
						0+78.0		#138				8-8-94
						0+54.0						
						0+29.3						
0	111.25	106.84	4.41	0+25.0								
30	112.64	106.99	5.65	30+89.5								
34	112.65	106.59	6.06	34+59.5								
36	113.73	106.21	7.52	36+50.7								
39	112.77	106.14	6.63	39+67								
42	113.76	105.84	7.92	42+84.2								
46	113.00			46+01.4								

Alley Bet Sanborn & St Francis So. Elm

Alley N Con Tr or

Main See Pg 368

NC #15511 636 N. St. Francis - Sub-Seal off 1-27-76 (5+41.5)
#15512 " " " " " (5+04.5)

I.O. C35427-601-03-09 E. Pine - Al Henning 10-17-72

#646 - Tap - 520 E. Central - 8-1-27 - Dermody Plbg.
#922 - Private line - 606 E. Central - 10-14-47 - Fray Bros.
#1259 - Tap - 514 E. Central - 12-10-47 - Burgan Plbg.
5195 Tap 612½ E Central - 9-12-57 Byers
15908 private line conn. 600 E. Central Bradford Brown 7-17-62
#C 19371 - 639 E Elm - Seal off - Herb Hoaney - 5-17-70 (41+16.2 + 27' E. of R.R. tracks)
C-20980 - 509-11 N. St Francis (seal off) J. C Severs - 7-14-70
(0+95) 1 conn sealed 15' so. on private line
1 conn " 25' " " " "

#27106 - 2-20-91 - 616 N. St. Francis S/O - Jim Labbers - (sealed 170' N of center of 6th St)