


WEST SUB-MAIN "C" ON NINTH ST. & LAT: NORTH AND SOUTH  
 S.S. No. 1-1889

A-271

Plat 9-44

TRAP AREA

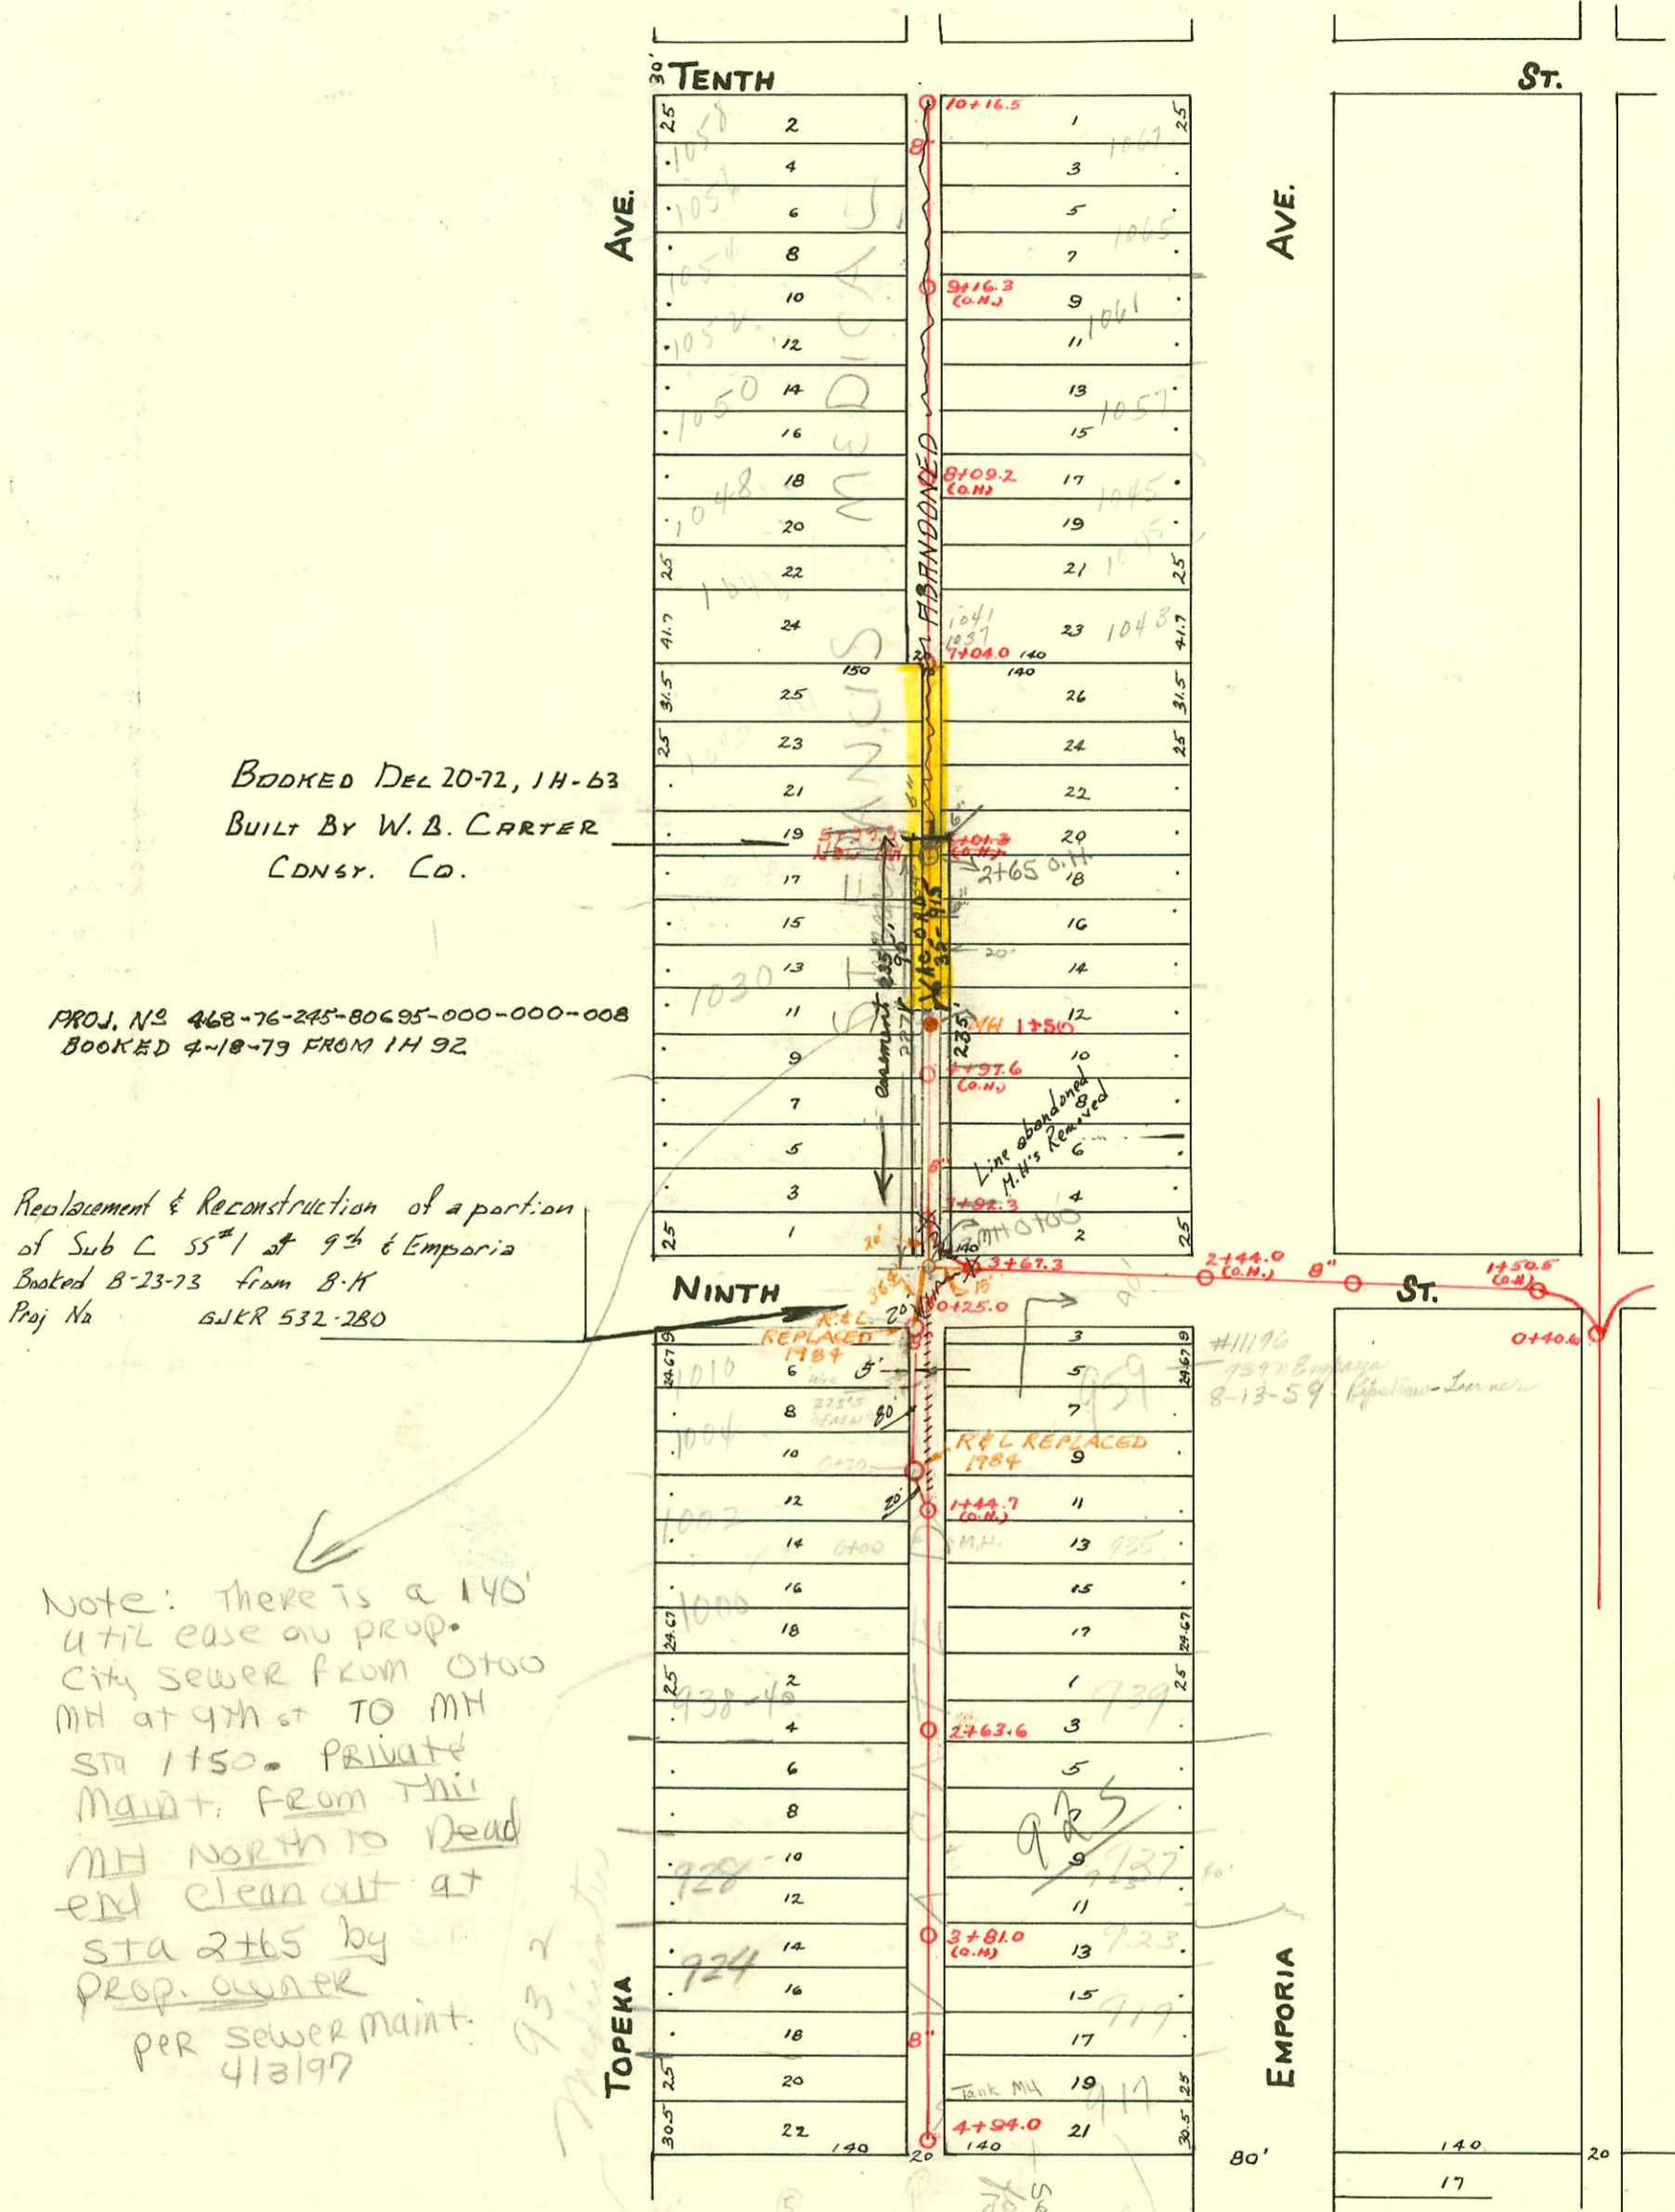

BOOKED DEL 20-72, 1H-63  
 BUILT BY W. B. CARTER  
 CDNSY. CO.

PROJ. NO 468-76-245-80695-000-000-008  
 BOOKED 4-18-79 FROM 1H 92

Replacement & Reconstruction of a portion  
 of Sub C 55" at 9th & Emporia  
 Booked B-23-73 from B.H  
 Proj No SJCR 532-280

Note: There is a 140'  
 util ease on prop.  
 City sewer from 0+00  
 MH at 4th st TO MH  
 STA 1+50. PRIVATE  
 Maint. from this  
 MH NORTH TO Dead  
 end clean out at  
 STA 2+65 by  
 PROP. OWNER  
 PER sewer maint.  
 4/3/97

Scale 1"=100'

