A 273

MAIN "C" FROM SOUTH LINE OF BURLEIGH ADD. TO TENTH ST.

S.S. No. 1 - 1889

Plat 9-44

TRAP AREA

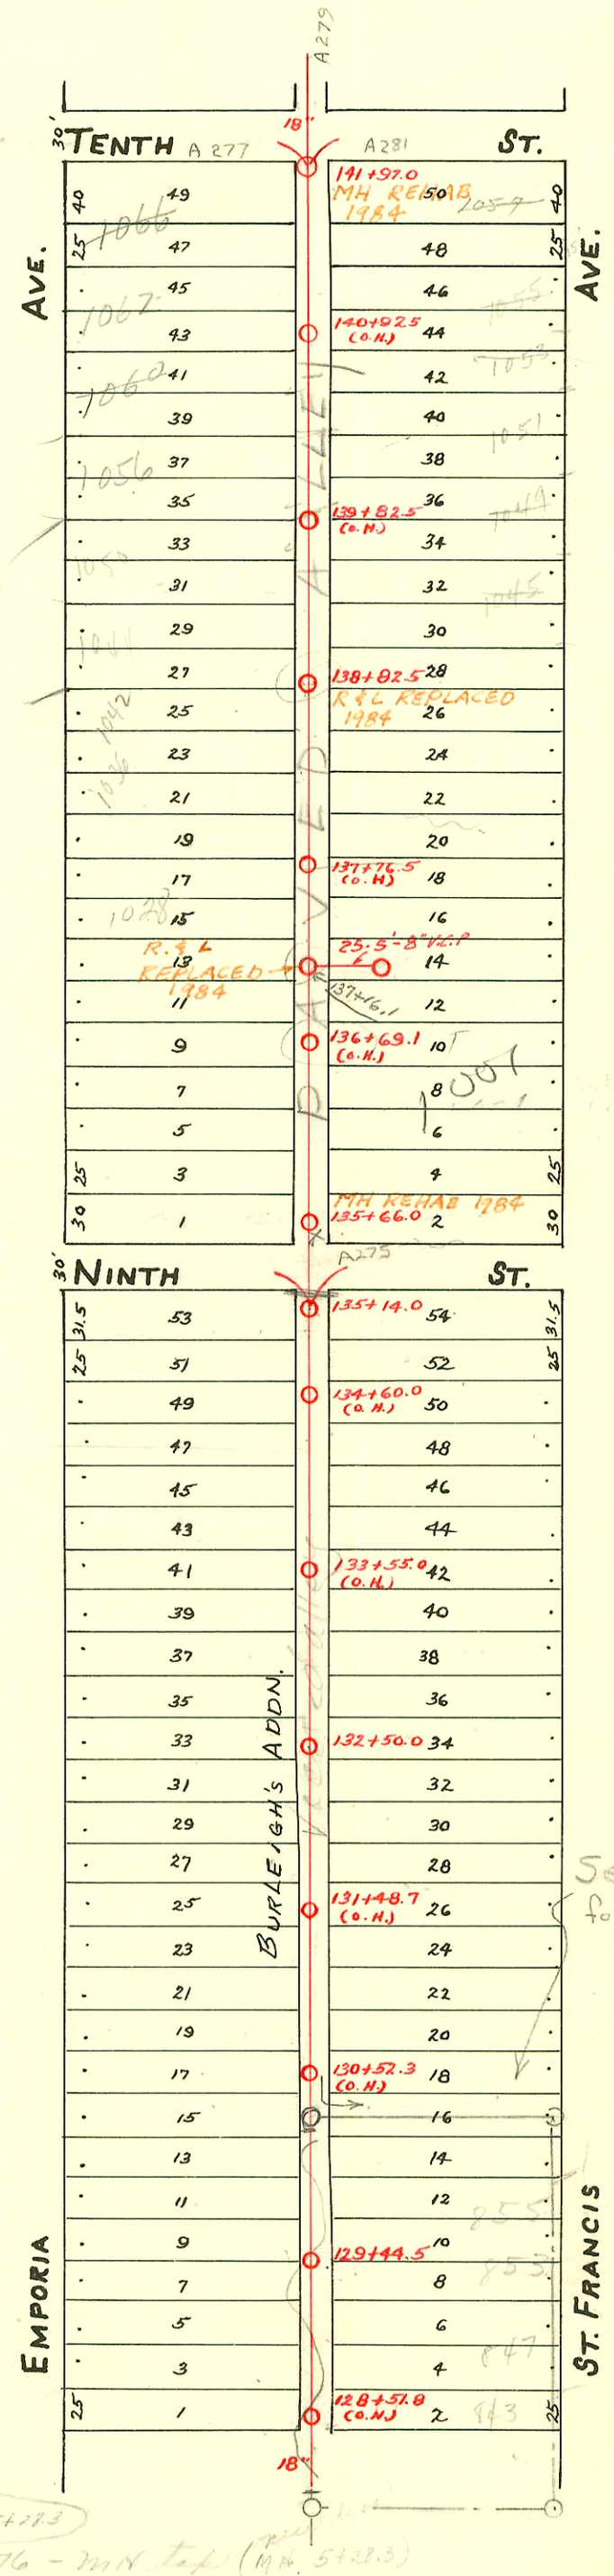

See B275 for relocated section

929 N ST Francis - S/O Known as 1001 N ST Francis - Old Laundry Area

S/O SWR 2001-01457 - 6-13-01 - Central Air:
S/O SWR 2001-01458 " "
S/O SWR 2001-01459 " "
S/O SWR 2001-01461 " "
S/O SWR 2001-01462 "
see also page A 275

929 N ST Francis - S/O 2nd add: 1020 N Emporia - Old Nurse's Home

2000-01708 7-26-00 The Fagan Co - 7/29/00 S/O OK
2000-01709 " " - 7/29/00 S/O OK
2000-01710 " " - 7/29/00 S/O OK
2000-01711 " " - 7/29/00 S/O OK
2000-01712 " " - 7/29/00 S/O OK

S.O. C 70340 - 929 N St. Francis - 2-26-79 (2 trailer Conns.)
C 60125 - Joe Kendall - 929 N. St. Francis - 2-21-77 102.5' S of new MH. 5+28.3
C 58583 - Joe Kendall - 929 N. St. Francis 11-10-76 - MH tap (MH. 5+28.3)
#17308 - 6-3-63 - Kendall Bldg lead off 1051 N. St. Francis
B 1307 - 5-26-64 - Kendall Bldg - tap into MH. 135+14.0
C 55548 - Kendall Bldg - 929 N. St. Francis - 5-20-76 (tap for trailer)
C 55549 - Kendall Bldg - 929 N. St. Francis - 5-20-76 (tap for trailer)

272

Form 41-(54) 6-56

CONSTRUCTION RECORD / SERVICE RECORD

STATION	ELEVATION Ground	ELEVATION Grade	Depth	MANHOLE	4-INCH "Y" BRANCHES North West	4-INCH "Y" BRANCHES South East	No. of Permit North West	No. of Permit South East	House Number North West	House Number South East	DATE OF PERMITS North West	DATE OF PERMITS South East
				144+97.0								
					141+88.0	141+86.0	C34221	C34216	1066 N. Emporia	1057 N. St Francis	8-11-72	8-11-72
					141+63.5	141+61.5	?	?				
					144+39.2	141+37.2		C34215		1055 N. St Francis		8-11-72
141	114.69	109.40	5.29		141+13.2	141+11.2		#381				12-6-04
					140+88.7	140+86.7		#B1390 65 Seal off		1053 N. St Francis		5-26-64
					140+64.0	140+62.0	C34220 #62		1060 N. Emporia		8-11-72 2-26-09	4-20-06
					140+39.0	140+37.0						
140	114.90	109.30	5.60		140+14.0	140+12.0	Seal off #B764	#103 #B1306 78 Seal off	1056 N. Emporia	1051 N St Francis 1049 N St Francis	1-30-64 7-10-00	6-16-05 5-26-64 4-24-08
					139+87.4	139+85.4	Seal off #B3460		1050 N. Emporia		5-20-65 11-4-08	
					139+63.0	139+61.0	#B253	C34214 #588		1041-45 N. St Francis		8-11-72 11-1-10
					139+37.0	139+35.0						
139	116.02	109.20	6.82		139+12.9	139+10.9	Seal off B3459 #C4138		1044 N. Emporia 1044 N. Emporia		5-20-65 6-5-00 7-27-67	
					138+88.0	138+86.0						
				138+82.5								
					138+61.7	138+59.7	#242		1040 N. Emporia		11-22-06	
					138+39.5	138+37.5		?				8-15-98
138	115.93	109.10	6.83		138+13.6	138+11.6	#351		1036 N. Emporia		10-5-04	
					137+87.3	137+85.3						
					137+62.8	137+60.8	#12537 #225	#937	1030 N. Emporia	1021 N. St Francis	11-9-84 10-31-06	5-22-19
					137+38.5	137+36.5	11853		1028 N. Emporia		8-23-89	
137	115.93	109.10	6.93		137+12.3	137+10.3	#2943		1020 N. Emporia		12-10-40	
					136+87.8	136+85.8	#667		1022 N. Emporia		9-7-17	
					136+59.7	136+61.7						
					136+35.5	136+37.5	Tap #2794	#131	1010 N. Emporia Nurses Home	NO Record Nurse Home St Francis St Fran. Hosp	10-22-40	7-16-94
136	116.05	108.90	7.15		136+07.0	136+09.0		#339 #563				4-27-21 9-10-18
					135+85.6	135+87.6	#110		1009 Emporia		6-7-93	
					135+55.0	135+57.0						
				135+66.0								
135	115.94	108.80	7.14	135+14.0								
					134+91.0	134+93.0		#433		St Francis Hospital		10-14-16
					134+66.3	134+68.3						
					134+42.0	134+44.0						
134	116.34	108.70	7.64		134+16.0	134+18.0	#592		St Francis Hospital		10-6-14	
					133+91.5	133+93.5						
					133+65.5	133+67.5						
					133+41.3	133+43.3	?		St Francis Hospital		8-1-02	
					133+25.0		#657				11-5-14	
133	115.77	108.60	7.17		133+15.3	133+17.3	?				8-25-02	
					132+91.7	132+93.7	C55902	#126	902 N. Emporia	St Francis Hospital	4-27-76	6-10-08
					132+65.8	132+67.8						
	114.27	108.50	5.77	132+50.0								
					132+41.7	132+43.7	#32	#83	942 N Emporia	937 N. St Francis	3-9-06	3-29-12
132	113.90	108.40	5.50		132+15.8	132+17.8		?				5-7-01
					131+91.5	131+93.5	#1129	#590	902 N. Emporia	925 N St Francis	10-8-38	6-29-11
					131+65.5	131+67.5		#655		939 N. St Francis		11-4-14
					131+41.0	131+43.0						
					131+16.5	131+18.5		C51333 #281		925 N. St Francis		9-15-75 6-17-12
					130+90.6	130+92.6						
					130+62.5	130+64.5		#381		885 N. St Francis		8-17-12
					130+42.0	130+44.0						
130	114.48	108.20	6.24		130+15.8	130+17.8						
					129+92.3	129+94.3						
					129+66.3	129+68.3	#583	#15312 189 Seal off	820 N. Emporia	855 N. St Francis	9-14-09	3-16-67 9-28-07
				129+44.5								
					129+38.2	129+40.2	Seal off #5 15891	#15311 Seal off	846 N. Emporia	853 N. St Francis	7-13-62 3-24-08	3-16-62 6-3-08
129	113.61	108.10	5.51		129+16.0	129+18.0	15890 Seal off		844 N Emporia		7-13-62 7-19-98	
					128+92.0	128+94.0		#15310 Seal off		847 N. St Francis		3-16-67 5-7-01
					128+66.0	128+68.0						
128				128+51.8 (O.H.)								
				0+00								
								#10052		1035 N. St Francis		4-16-59
								10053		"		"
								10054		"		"
								10055		"		"
								10056		"		"
								10057		"		"
								10058		"		"

NC. C61467 - 929 N. St. Francis (Laundry Room) - Ted Kendall - 6-7-77 (m Tap 3.5+66.0)

035578 - 1062 N. Emporia - 10-25-72 - al Henry - Seal off

5462 Tap 849 N. Emporia 10-17-57

#670 Kendall 9-28 St Francis 6-5-57 6 on 8 private line

#45 - Tap - St. Francis Hospital - 2-1-29 - F. X. Hoff & Son
#570 - Tap - St. Francis Hospital - 5-18-29 - F. X. Hoff & Son
#572 - Tap - St. Francis Hospital - 5-18-29 - F. X. Hoff & Son
#573 - Tap - St. Francis Hospital - 5-18-29 - F. X. Hoff & Son
#2416 - Private line - 7-27-42 - Kansas Plbg. Co.
#1001 - Tap - 512 E. Ninth - 8-21-43 - Pray Plbg. Co.
#393 - Tap - St. Francis Hospital - 7-12-46 - Harvey Haase
#7307 - Tap - 1002 S. Emporia - 2-3-56 - C.G. Coleman Plbg. Co.
#2643 - 6" on 10" wye - Kendall Plbg. - 10-3-56 - St. Francis Hospital - Private line sewer
#2644 - 6" on 10" wye - Kendall Plbg. - 10-3-56 - St. Francis Hospital - Private line sewer
#2670 - Stub in manhole - 10-5-56 - St. Francis Hospital - Private line sewer
#338 - Moore-Robertson Plbg. - 6-27-46 - St. Francis Hospital - Private line

#2980 - Moore-Robertson Plbg. Co. - 426-46 - Private line - St. Francis Hospital
#2981 - " " " " " " "
#2982 - " " " " " " "
#2983 - " " " " " " "
#2984 - " " " " " " "
#2985 - " " " " " " "
#281-282-283 - Taps in Private line - 6-18-46 - Moore-Robertson - St. Francis Hospital
#297-298-299-300-301-302 - Taps in Private line - St. Francis Hospital - 6-20-46 - Moore-Robertson Plbg.
#294-295-296 - Private line conn. - St. Francis Hospital - 6-20-46 - Moore-Robertson Plbg.