MAIN "C" FROM TENTH ST. TO TWELFTH ST.
S.S. No. 1- 1889

A 279

Plat 9-44

TRAP AREA

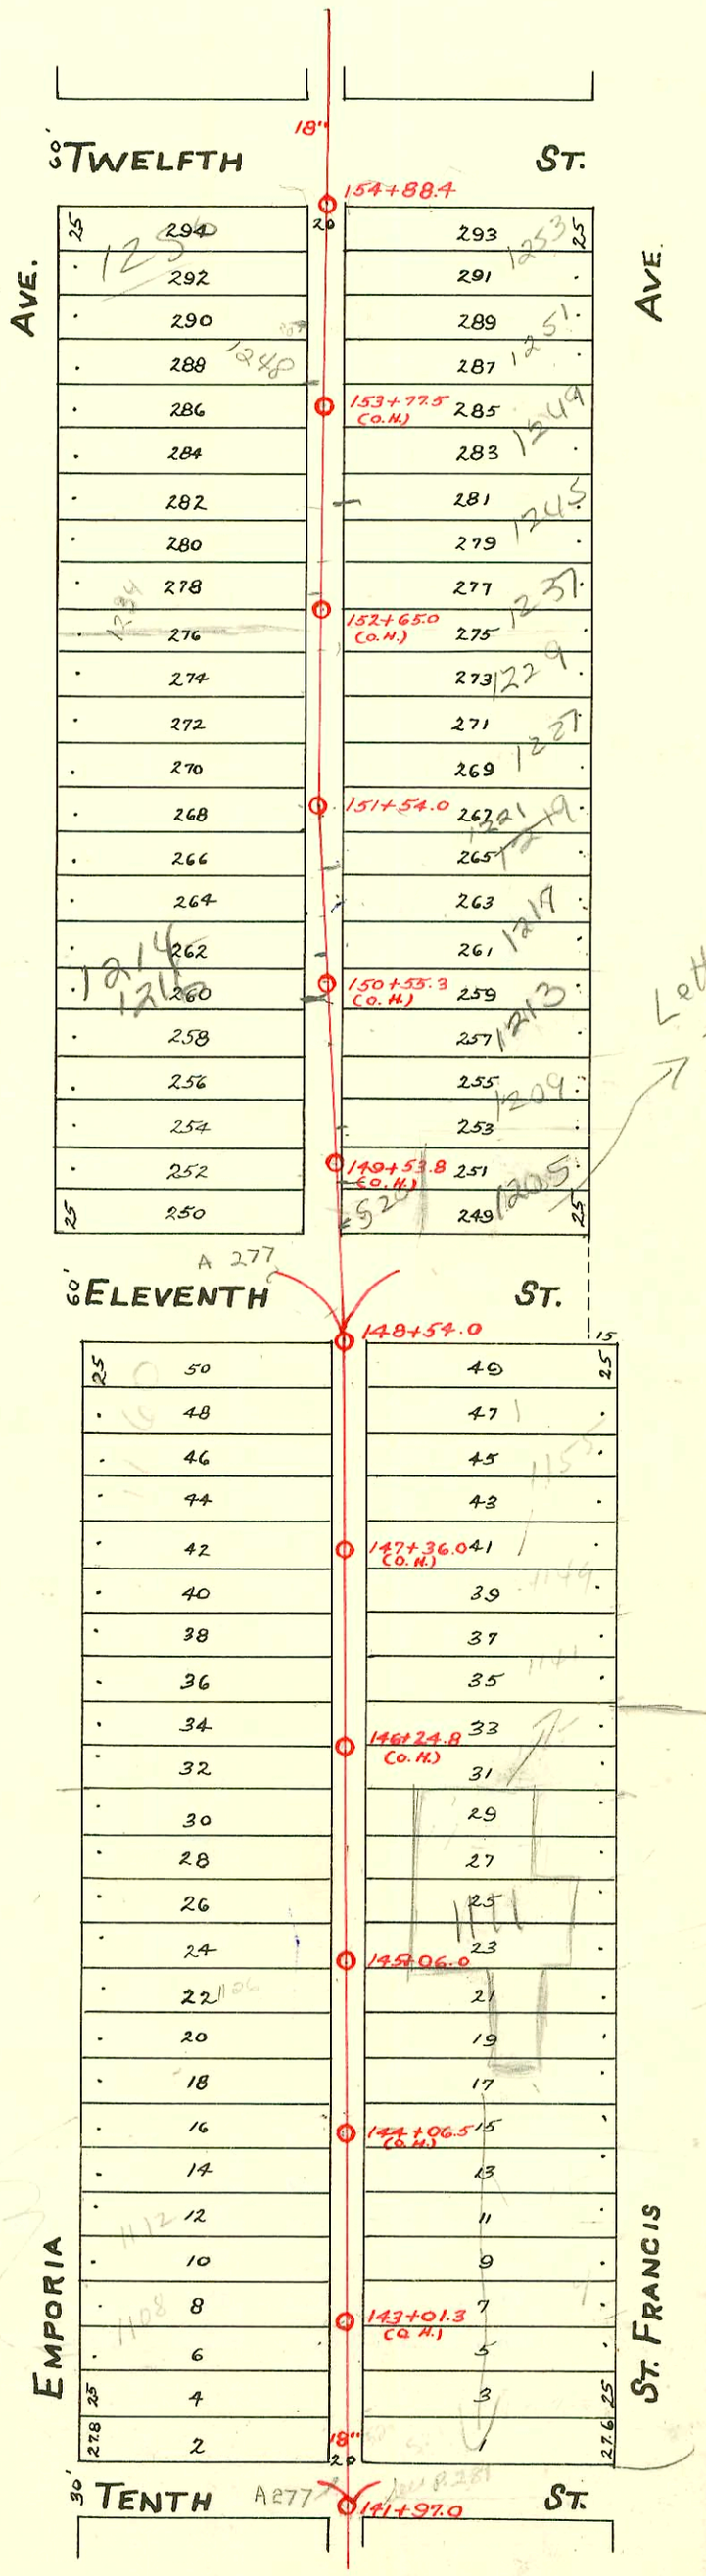

Letter dtd 4/23/62 by Teresa Rodkiewicz allowing 1115 & 1205 N St Francis to be repl. across front of lot 50 x 115

2006-01767- 1155 N. St Francis - 70'S of MH 5548-6022- trap, (1) twin clo (2) 45's 4" Sch 40 PVC
Padgett EA, 7/20/06

2003-00602- 3/10/03- 1249 N St Francis- Bowers Plbg- twin co, 1122, existing PVC under garage, trap is believed to be in Main

→ 1213 N St Francis (4" ABS 1/4" Fall 132.5 Ft S of MH exist wye comm sewers tapped)

→ 1210 N St Francis (1-4" CO. 1-4" trap 4" Sch 40 ABS wye 60's of MH Meyer)

278

Form 41-(54) 6-56

CONSTRUCTION RECORD / SERVICE RECORD

STATION	ELEVATION Ground	ELEVATION Grade	Depth	MANHOLE	4-INCH "Y" BRANCHES North West	4-INCH "Y" BRANCHES South East	No. of Permit North West	No. of Permit South East	House Number North West	House Number South East	DATE OF PERMITS North West	DATE OF PERMITS South East
				154+88.4	Seal Off							
					154+69.6	154+67.6	#90	#555	1250 N. Emporia	1253 N. St. Francis	3-15-09	10-23-37
					154+44.5	154+42.5						
154	116.50	110.70	5.80		154+19.8	154+17.8		#35		1251 N. St. Francis		3-13-08
					153+94.5	153+92.5	#256		1250 N. Emporia		5-5-09	
					153+69.3	153+67.3	#545		No Record		11-21-12	
					153+44.5	153+42.5						
153	115.35	110.60	4.75		153+19.3	153+17.3	#388	#65	No Record	No Record	8-23-12	3-19-12
					152+94.4	152+92.4						
					152+69.0	152+67.0		#231		St. Francis		4-30-13
					152+44.0	152+42.0						
152	114.95	110.50	4.45		152+19.5	152+17.5	#2253	#418	1230 N. Emporia	1227 N. St. Francis	9-6-50	8-17-37
					151+94.3	151+92.3		#261				1-8-08
					151+70.0	151+68.0						
			6"	151+54.0								
					151+45.4	151+43.4	#168	#452	1226 N Emporia		7-29-08	10-26-76
151	114.76	110.40	4.36		151+20.5	151+18.5	#254	#590	1224 N. Emporia		12-11-06	9-16-09
					150+96.0	150+94.0	#4968		1224 N. Emporia		6-13-51	
					150+72.0	150+70.0						
					150+47.5	150+45.5	#1375		1214 N Emporia		11-13-19	11-30-98
150	115.00	110.30	4.70		150+23.8	150+21.8	#510	#1067		1211 N St Francis	9-6-10	7-14-19
					149+99.0	149+97.0	#6276	#994	1208 N. Emporia	1209 N St Francis	10-26-51	6-12-19
					149+75.4	149+73.4						
					149+48.0	149+46.0		#18				2-28-08
149	114.71	110.20	4.51		149+23.3	149+21.3	#720	#173	1100 N. Emporia	11th	11-16-09	9-4-07
				148+54.0								
					148+34.8	148+32.8				1155 N. St. Francis		8-17-99
148	114.51	110.10	4.41		148+10.0	148+08.0						
					147+85.3							
					147+61.0	147+83.3	#3020		1146 N. Emporia		12-27-54	
					147+42.3	147+59.0						
						147+32.0		#136				6-18-06
147	114.94	110.00	4.94		147+09.4	147+07.4						
					146+85.0	146+83.0	#486	#233	1146 N. Emporia	1141 N. St. Francis	3-14-24	11-6-06
					146+58.7	146+48.7	#4		1140 N. Emporia	1135 N. St. Francis	1-9-05	3-4-71
					146+33.4	146+27.3						
146	114.41	109.90	4.51		146+10.7	146+08.7						
					145+85.7	145+83.7	144		1134 N. Emporia		8-11-05	
					145+59.0	145+57.0		#153		1133 N. St. Francis		8-17-05
					145+36.3	145+34.3	#349	#65	1130 N. Emporia	1131 N St. Francis	10-4-04	5-10-05
					145+11.0	145+09.0						
145	114.35	109.80	4.55	145+06.0								
					144+86.0	144+84.0	#120		1126 N. Emporia		9-23-03	
					144+61.2	144+59.2		#12		1125 N St Francis		2-19-06
					144+36.2	144+34.2						
					144+11.2	144+09.2	#1395	#255	1120-22 N Emporia	1115 N. St. Francis	11-21-19	12-30-07
144	114.17	109.70	4.47									
					143+85.8	143+83.8		#92		1115 N St Francis		4-15-08
					143+61.0	143+59.0		#159 Stable Connection	1110 N. Emporia		4-15-77	7-18-08
					143+36.5	143+34.5			1110 Emporia		3-15-85	10-18-02
					143+09.8	143+07.8						
143	114.41	109.60	4.81									
					142+83.9	142+81.9	#2	#33	516 E.	520	5-26-11	1-26-11
					142+59.6	142+57.6						
142	114.31	109.50	4.61		142+35.6	142+33.6						
141				141+97.0		142+18				1111 N St Francis		1-7-77

R 2002-01177 4/24/02 1205 N St Francis - Bowers - 4" 40PK, 6x4 Ferneo 2' from main, ferneo @ house, 1TWINCO, 1H22

R 2002-01246 5/1/02 520 W 11th - Bowers - TWINCO - New trap, 2V45 tied to daylite w/ ferneo

R- 2001-00468 - 3/5/01 - 1111 N St Francis - Redde - 4" SCH40 - 1TWINCO only

R- 1999-01418 - 12/8/99 - 1234 N Emporia - Bucks - 4" SCH40 Predco 113' N of MH 15H54 (152+67) 1TWINCO, 1H22, 1V45

R #7396 1222 N. Emporia Henderson 12-3-86

R #7918 - 1114 St Francis - 4-25-83 - Al Henning - 141+97.0 N

R #7301 - 1248 N. Emporia (Butcher) 1-4-83 MH 154+88.4 (97.0 S of MH) (153+91.4)

C75703 - 1111 N St Francis Bill Lee (21' N of MH)

C59402 - 1111 N. St Francis - 1-7-77 - J. Matthews - (145+27.0)

S.O. C49108 - 1108 N. Emporia - 4-18-75 - Al Henning (142+84)

#715 - Tap - 1209 N. St. Francis - 12-3-41 - W. B. Carter

#3335 - Tap - In 10th St. Sewer - 1103 N. St. Francis - 2-16-50 Seal off C18994 - Al Henning 4-28-70 (0+70)

Tap - 1110 N. Emporia - 12-7-50 - C. G. Coleman

Reg # 4974 - Tap - 1205 N. St Francis - Bowers - 2-8-57

#4558 - 1227 N. St Francis Broiler

#4559 " " Private line connection C Lee Jade 5-20-57

#C3745 - 1251 N. St Francis (rear) Seal off - Bowers Plbg - 6/28/67

#91-36837-7 11/6/91 1213 N. St. FRANCIS NC →

#91-37054-7 11/12/91 1217 N ST. FRANCIS NC →

92-7508-7 5/20/92 1221 N ST FRANCIS - NC