


MAIN "C" FROM THIRTEENTH ST. TO FIFTEENTH ST.
S.S. No 1-1889

Plat 9-41

TRAP AREA

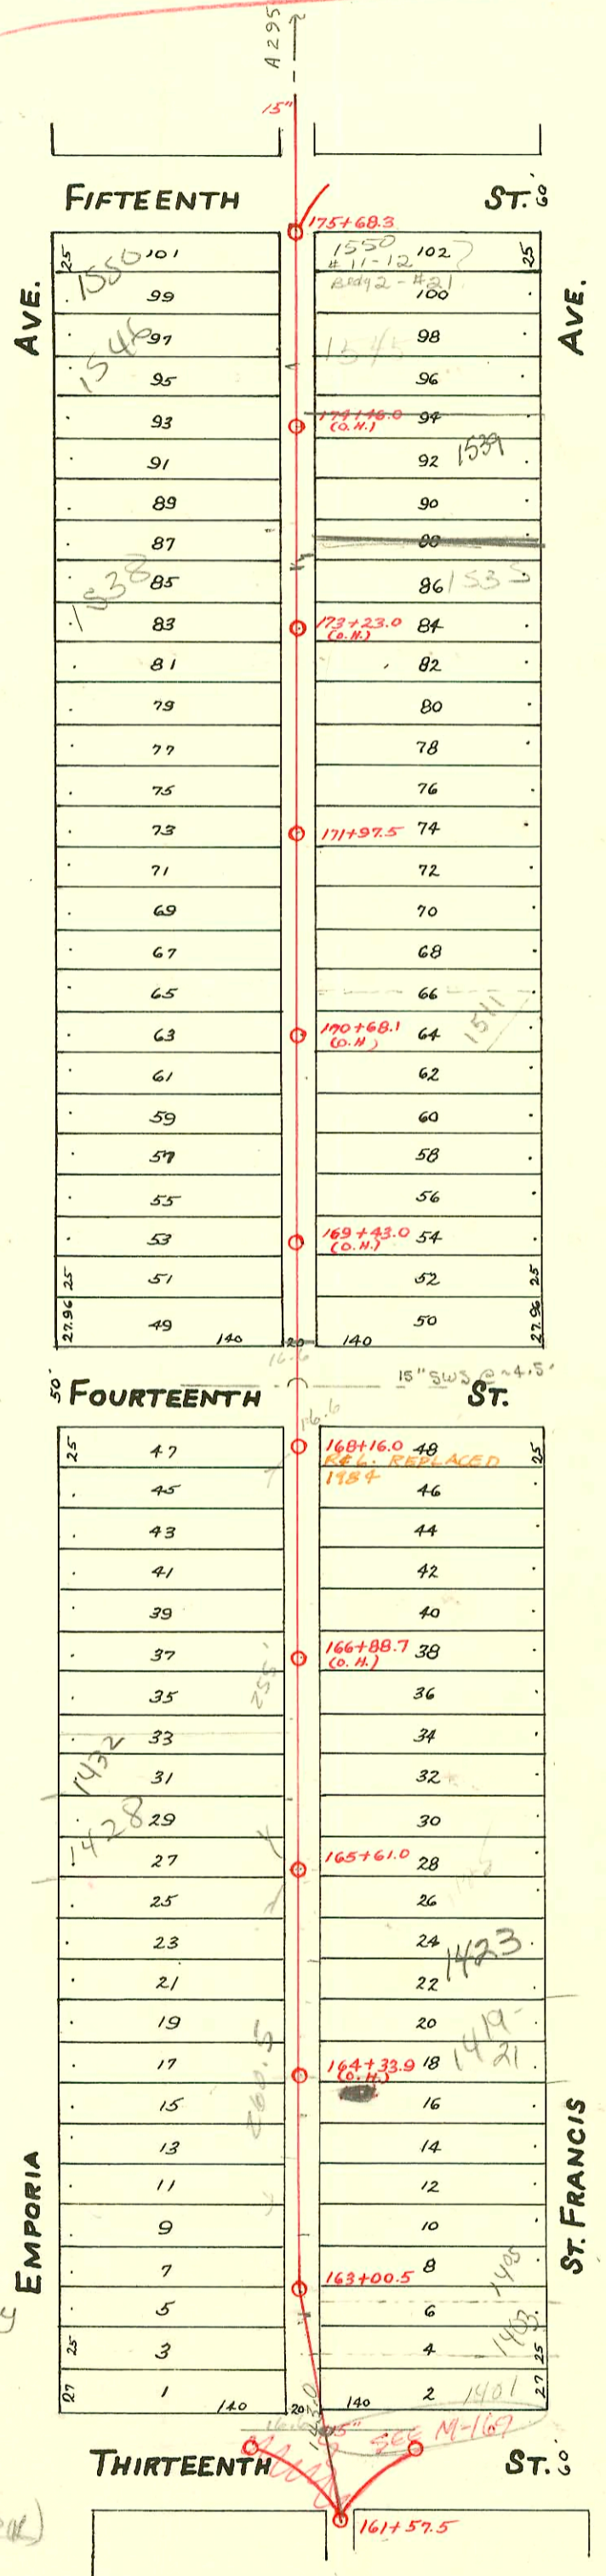

2003-02881-11/5/03- 1423 N ST Francis - Lonny Wright - Replace from 8' from house to alley, put in trap, (left 25' under bldg) 2-1 way CO, 1 twin CO, 3V45, 4 twin CO, 1-wye, 3H45, 1 running trap

98-4428-7 3/24/08 1419 N ST FRANCIS (CARRIAGE HOUSE IN REAR) S10 230' N of Mt

CONSTRUCTION RECORD						SERVICE RECORD						
STATION	ELEVATION		Depth	MANHOLE	4-INCH "Y" BRANCHES		No. of Permit		House Number		DATE OF PERMITS	
	Ground	Grade			North West	South East	North West	South East	North West	South East	North West	South East
				175+68.3								
					175+60.0	175+58.0	#649	#902	1550 N. Emporia	no record	10-15-09	12-4-11
175	119.16	112.80	6.36		175+35.8	175+33.8						
					175+11.3	175+09.3	#1868	#649	1534 N. St. Francis	1546 N. St. Francis	11-7-06	9-1-17
					174+86.6	174+84.6	215	#425	Emporia	1541 N. St. Francis	3-31-21	5-1-22
					174+62.6	174+60.6						
174	118.78	112.70	6.08		174+38.3	174+36.3	#1174		1537 N. St. Francis	1540 N. St. Francis	9-11-22	
					174+13.4	174+11.4	#114		Emporia	1537 N. St. Francis	3-1-21	
					173+88.4	173+86.4	#20037	#303	1542 N. Emporia	1537 N. St. Francis	2-2-88	7-21-16
					173+64.3	173+62.3	482	#1098	Emporia	1535 N. St. Francis	4-5-23	8-28-22
					173+40.0	173+38.0						
173	118.33	112.60	5.73		173+15.2	173+13.2						
					172+91.0	172+89.0						
					172+67.0	172+65.0	#1290	#27	1536 N. Emporia	1525 N. St. Francis	10-1-22	1-16-20
					172+42.6	172+40.6	#1463		1522 N. Emporia	1525 N. St. Francis	11-2-22	
172	118.48	112.50	5.98		172+18.0	172+16.0		#808	1525 N. St. Francis			11-5-17
				171+97.5								
					171+93.0	171+91.0	#877	#1243	1528 N. Emporia	1523 N. St. Francis	7-22-22	9-22-22
					171+68.6	171+66.6		#1073	1517 N. St. Francis			8-24-22
					171+44.5	171+42.5						
171	117.87	112.40	5.47		171+20.6	171+18.6	#142	#455	1538 N. Emporia	no record	2-8-24	5-18-11
					170+96.3	170+94.3						
					170+72.0	170+70.0		#1724	1511 N. St. Francis			12-18-22
					170+48.7	170+46.7		#300	1509 N. St. Francis			5-23-10
170	117.67	112.30	5.37		170+24.2	170+22.2	?				6-17-01	
					169+99.8	169+97.8		#570	no record			10-18-13
					169+75.2	169+73.2		#418	1508 N. St. Francis			7-11-18
					169+51.5	169+49.5	#325		1506 N. Emporia		1-19-09	
					169+27.6	169+25.6						
169	117.70	112.20	5.50		169+03.0	169+01.0	#259	#416	1502 N. Emporia	1501 N. St. Francis	11-9-08	7-11-18
					168+80.0	168+78.0						
168	117.31	112.10	5.21	168+16.0								
					167+97.0			#231	1442 N. Emporia		11-25-07	
					167+73.2	167+95.0						
					167+49.8	167+71.2		#149	1442 N. Emporia		8-14-05	
					167+25.7	167+47.8		#317	no record			7-1-12
167	117.07	112.00	5.07		167+01.5	167+23.7	#148	#407	1438 N. Emporia	1445 N. St. Francis	8-14-05	5-14-21
					166+99.5							
					166+77.0	166+75.0	#242	#220	1437 N. Emporia	1441 N. St. Francis	12-14-05	10-6-08
					166+53.0	166+51.0	#76	#284	1432 N. Emporia	1435 N. St. Francis	4-10-08	5-11-17
					166+28.4	166+26.4	#555		1431 N. St. Francis		8-2-21	
166	116.73	111.90	4.83		166+04.1	166+02.1	#76		1430 N. Emporia	no record	5-23-05	
					165+79.5	165+77.5		#680	no record			9-3-20
				165+61.0								
					165+54.0	165+52.0	#729	#326	1426 N. Emporia	1425 N. St. Francis	2-4-19	2-24-84
					165+30.3	165+28.3		#2003-02881	1423 N. St. Francis	R seen next pg	11-5-03	10-25-22
165	116.30	111.80	4.50		165+05.3	165+03.3		#1435				
					164+80.8	164+78.8						
					164+56.4	164+54.4	#375		1426 N. St. Francis	1421 N. St. Francis	8-3-15	
					164+32.4	164+30.4	#372		1416 N. St. Francis	1412 N. St. Francis	9-13-16	8-2-29
164	117.01	111.70	5.31	M.H. 164+33.9	164+07.7	164+05.7	#36	#415	1414 N. Emporia	1414 R. St. Francis	3-12-06	7-24-13
					163+83.5	163+81.5	#35		1410 N. Emporia		3-12-06	
					163+59.2	163+57.2						
					163+35.4	163+33.4	#55009	#297	1504 N. St. Francis		#-37-76	5-14-14
					163+11.0	163+09.0	#721		1408 N. Emporia	1405 N. St. Francis	6-30-49	
163	117.61	111.60	6.01	163+00.5								
					162+86.5	162+84.5	#589	#293	502 E. 13th	1403 E. St. Francis	8-12-47	5-19-09
					162+62.0	162+60.0		#45				1-29-10
162	116.94	111.50	5.44		162+38.2	162+36.2						
161	116.68	111.46	5.22	161+57.5								

97-12546-7 7-23-97 1546 N Emporia - Padgett EA - 4" wye for 2nd kickout - schlapoc

