WEST SUB-MAIN "D" IN ALLEY N. OF DOUGLAS AVE. AND LAT. N. - ALSO SPUR WEST ON FIRST ST.
S.S. No. 1 - 1889

Plat 9-50

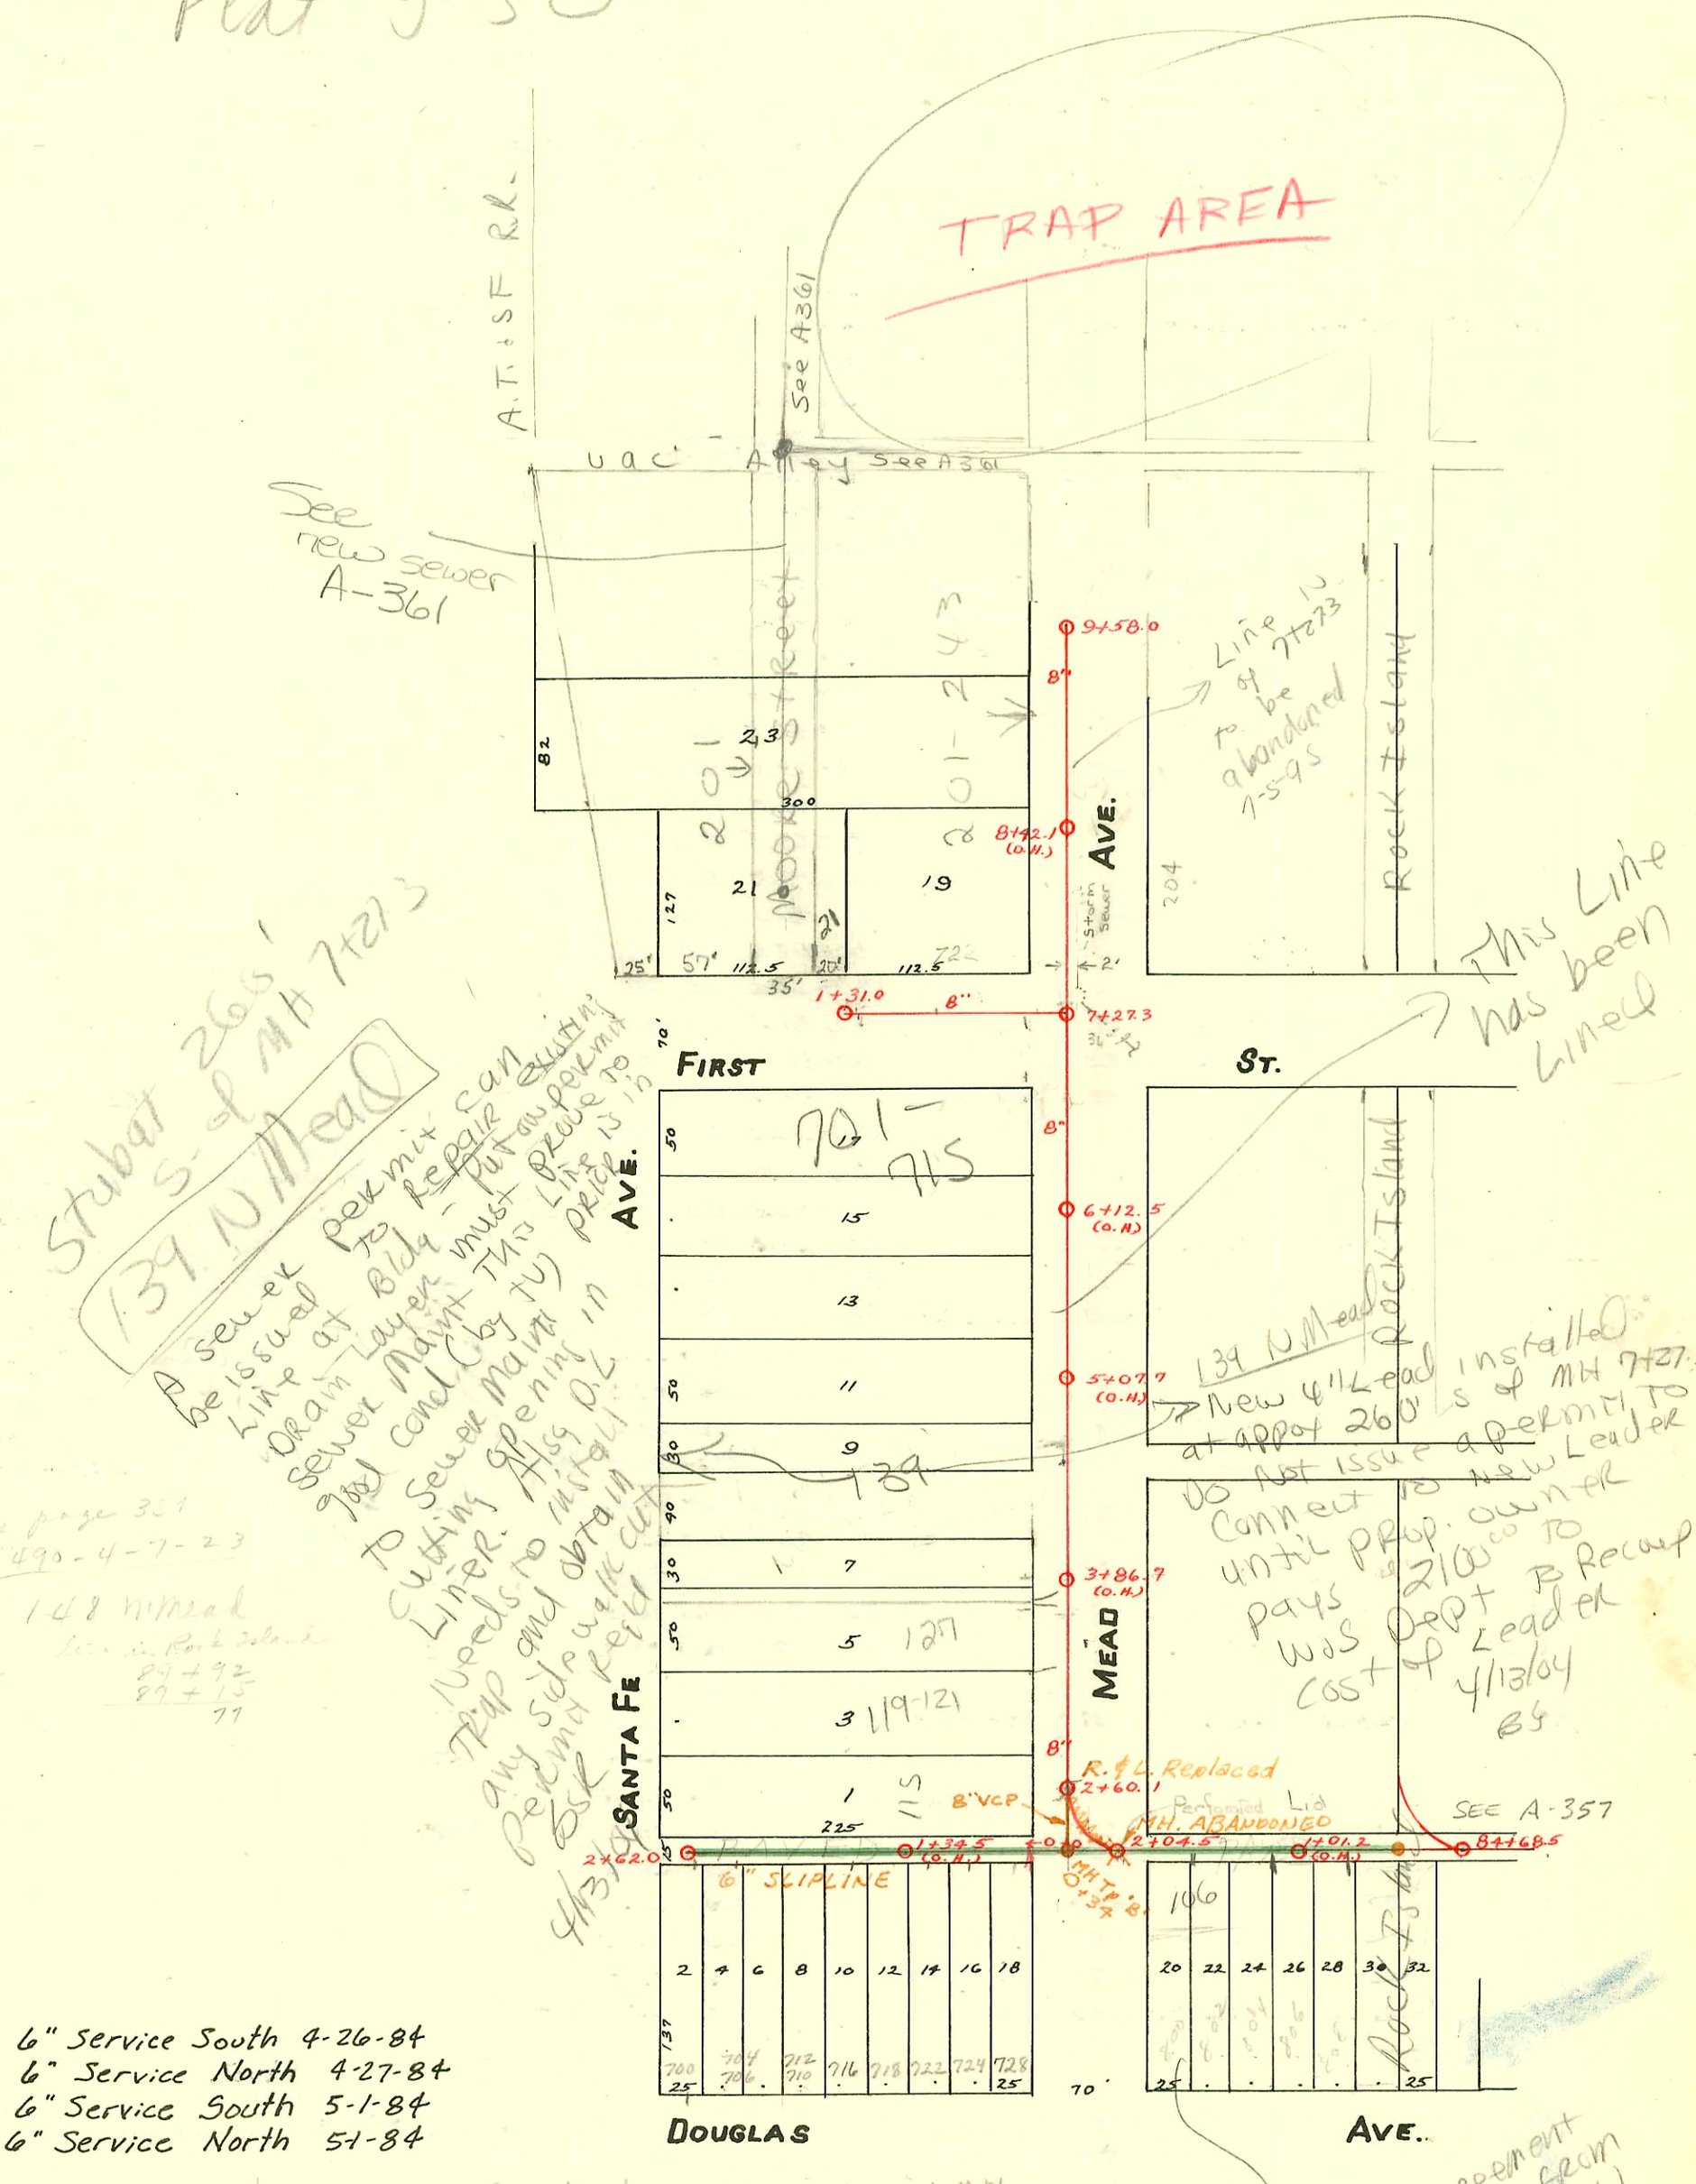

354

Form 41-(54) 6-56

	CONSTRUCTION RECORD							SERVICE RECORD					
	STATION	ELEVATION Ground	ELEVATION Grade	Depth	MANHOLE	4-INCH "Y" BRANCHES North West	4-INCH "Y" BRANCHES South East	No. of Permit North West	No. of Permit South East	House Number North West	House Number South East	DATE OF PERMITS North West	DATE OF PERMITS South East
Spur W. on 1st St.		109.79	105.06	4.73	1+31.0								
	1					1+27.5	1+25.0	#762	?	201 N Moore ?		8-23-21	4-5-06
	0+72.7	109.93	104.88	5.05			0+25.0		?				12-30-19
		109.71	105.25	4.46	9+58.0								
						9+49.0							
	9+27.3	109.80	105.15	4.65		9+25.0							
	9					9+00.0							
						8+75.2							
						8+50.5							
	8+27.3	109.53	104.88	4.67		8+26.0							
	8					8+01.0							
						7+76.6							
	7	110.14	104.66	5.48	7+27.3	7+51.6							
						6+79.0							
						6+54.5							
						6+29.3							
	6	109.67	104.18	5.49		6+05.5							
						5+79.1							
						5+54.5							
						5+30.5							
	5	109.90	103.88	6.02		5+06.0							
						4+81.8							
						4+57.2		#99		no 139 Mead address		3-18-18	
						4+33.3							
	4	109.93	103.58	6.35		4+09.5							
						3+84.8							
						3+60.1		#250		Smyth White		12-22-05	
						3+37.3							
	3	110.15	103.28	6.87		3+12.8							
						2+88.1		#251		Smyth White		12-22-05	
	2	109.98	103.16	6.82	2+20.3	2+63.6							
Spur W. in Alley N. of Douglas					2+62.0								
							2+53.0		#78		700 E. Douglas		2-9-14
							2+29.3		?				1-21-02
	2	110.51	104.99	5.52			2+05.0						
							1+81.0	Seal off	C22020		710-12 E. Douglas		12-2-70
							1+56.2	Seal off	C22021		714-16 E. Douglas		12-2-70 1-7-02
						1+09.0	1+33.0	Seal off	? C22674				9-25-02
	1	109.68	103.99	5.69			1+07.0		#93		718-22-24-28 E. Douglas		11-25-71 4-21-94
							0+82.5						
	0	109.92	102.99	6.93		0+55 500 opp page	0+58.5	94-421-7	C22618 ?	115 N. Mead	111 N. Mead	3/28/94	1-20-71 4-3-03
	2	109.92	102.97	6.95	2+04.5				#339		no Record		5-13-02
							1+59.4		#308		802 E. Douglas		3-29-28
							1+35.7						
	1	109.25	102.68	6.57			1+11.3		#340		no Record		5-13-02
							0+88.0						
							0+64.0		#14		(R) 808 E. Douglas ?		2-9-02
							0+40.2						
							0+16.1						
	0	108.39	102.38	6.01			0+04.0						

98-12025-7 7-8-98 - 701 E 1st (AKA 715) David Lefler. Tap at 55' S. of MH 6" SCH 40 PVC - C.O. and Trap Located inside Bldg

98-12024-7 7/8/98 701 E 1st (AKA 715 E 1st) David Lefler: Tap at 57.2' S of MH 6" SCH 40 PVC (cleanout & Trap inside Bldg) 2-4S it 145 Utah Bredco

R #8402 250 N. St Francis - (Wade) MH 1+31 Coleman Co 6-17-83

#109 - Murphy - Tap - 728 E. Douglas - 2-21-27
#1250 - Burgan - Tap - 115 N. Rock Island - 9-9-29
#103 - Tap - 720 E. 1st - 10-6-33 - J. E. Lansdowne
#540 - Tap - 722 E. 1st - 10-19-37 - W. W. Pray
#671 - 720 E. 1st - 12-31-37 - W. W. Pray - Used old conn.
#274 - Tap - 800 E. Douglas - 3-1-43 - Plummer Plbg. Co.

93-26052-7 10-5-93 201-243 N. Mead (AKA 718-22 E 1st) 6" sealed off 53' E of MH 1+31. (78.0)

93-26053-7 10-5-93 - (201 N Mead) S/O (AKA 243 N Mead) 4" SDR35

93-27995-7 10-28-93 - discharge permit approved by B. Gaynor - N/C - 4" SCH 40 PVC underground drilling