A 375

MAIN "D" ON SOUTH LINE OF FRISCO R. OF W. TO OAK ST.
WEST SUB-MAIN "D" ON PINE ST. AND LAT NORTH ON MEAD AVE.
WEST SUB-MAIN "D" ON PROP. LINE SOUTH OF MURDOCK AVE.
S. S. No. 1 - 1889

Plat 9-49

TRAP AREA

Murdock Sanitary Sewer Replacement
from Wichita to Wabash
468-82707 OCA # 621763

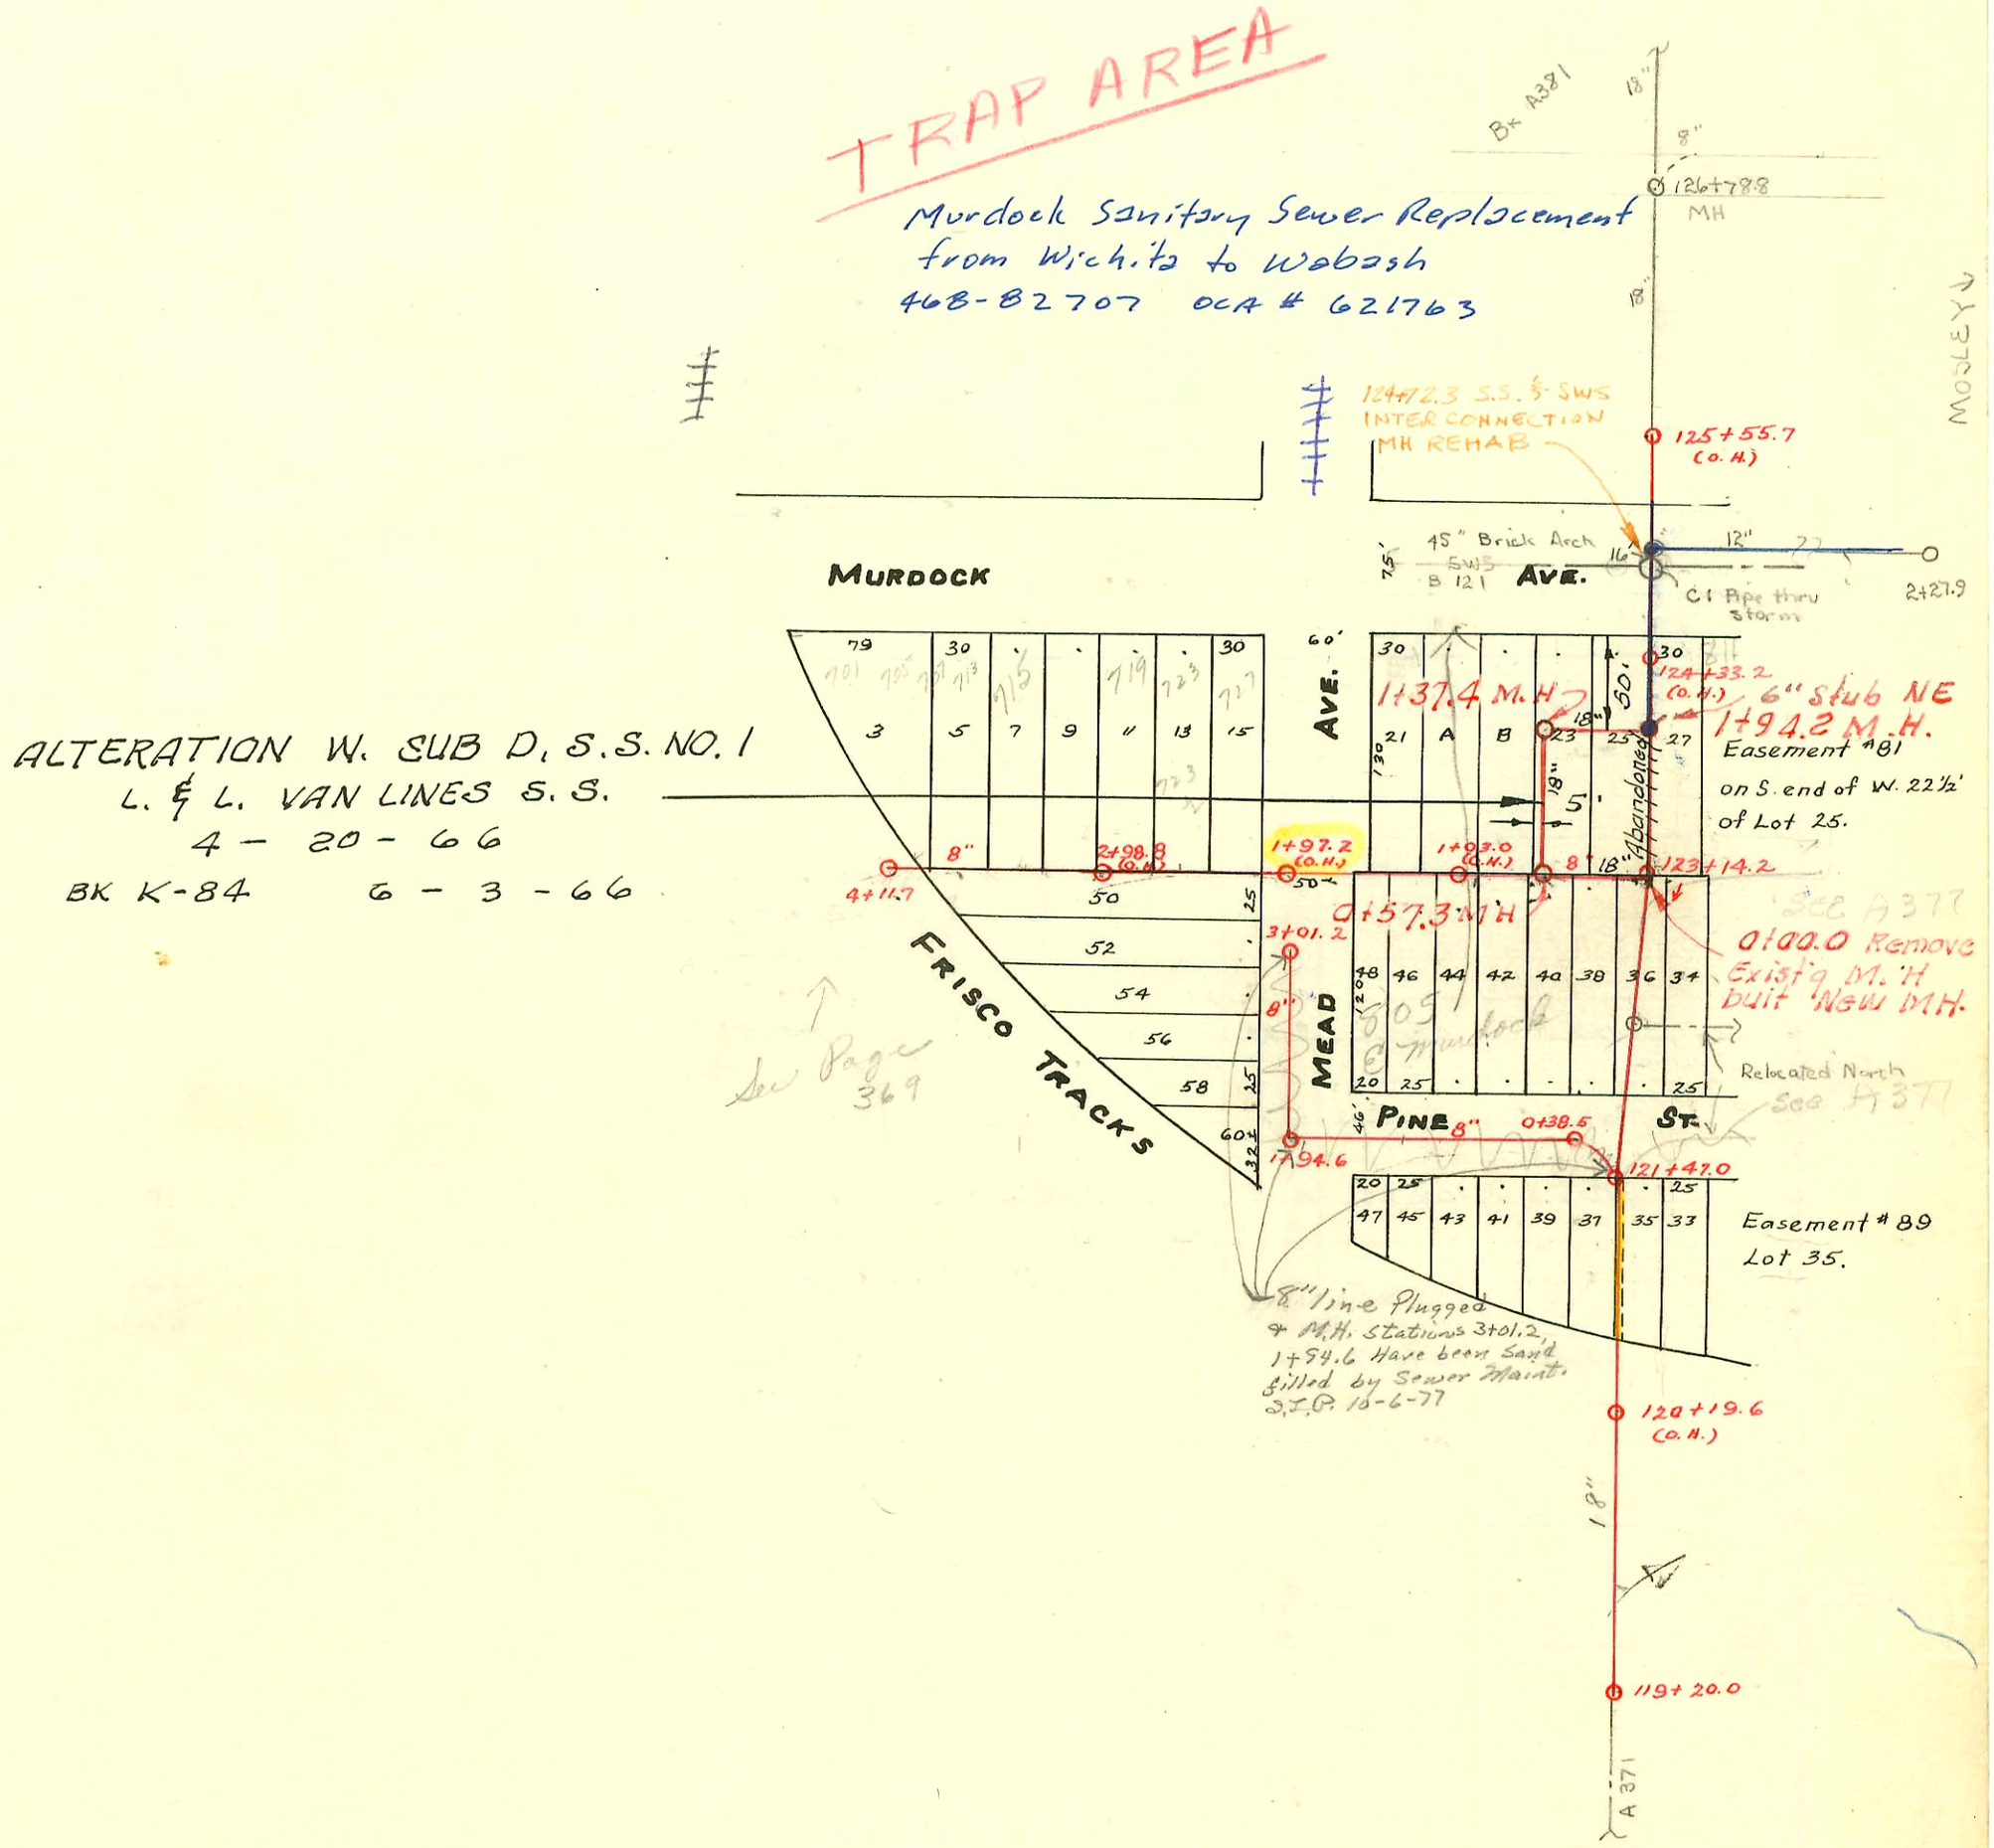

Form 41-(54) 6-56

CONSTRUCTION RECORD / SERVICE RECORD

STATION	ELEVATION Ground	ELEVATION Grade	Depth	MANHOLE	4-INCH "Y" BRANCHES North West	4-INCH "Y" BRANCHES South East	No. of Permit North West	No. of Permit South East	House Number North West	House Number South East	DATE OF PERMITS North West	DATE OF PERMITS South East
				4 + 11.7 ←	MH Map		C3136		701 E Murdock	Addon	3-22-72	
4	114.74	109.59	5.15		4 + 09.4		#547		703 E Murdock		9-16-14	
					3 + 94.5	Sq #C38639 #6			705 E. Murdock		5-1-73 1-31-96	
					3 + 69.8							
					3 + 39.0		#587		713 E. Murdock		10-1-18	
3	115.06	109.14	5.92		3 + 07.9	3 + 09.9 Seal						
					2 + 77.0		#106		723 E. Murdock		9-16-65 9-22-23	
					2 + 45.6 2+49.7		#1736		727 E. Murdock		12-21-22	
2	114.14	108.64	5.50		2 + 16.4		94-2290-7		721 E Murdock		2-22-94	
						1 + 41.0						
					1 + 31.0	1 + 18.9	#737		801 E. Murdock	805 E. Murdock	12-21-22	
1	113.10	108.14	4.96			Tap 1 + 02.3		C64481				12-16-77
					0 + 99.2	0 + 97.2	#1576		847 E. Murdock		10-26-23	
						0 + 72.7						
					0 + 70.7	0 + 56.0	#1406		807 E. Murdock		10-23-22	
0					0 + 34.5	0 + 20.5						
3	114.14	108.72	5.42	3 + 01.2								
					2 + 99.0							
					2 + 76.4							
					2 + 51.0							
2	115.10	108.32	6.78		2 + 26.2							
					1 + 98.3							
				1 + 94.6								
						1 + 38.0						
1	114.20	107.92	6.28			1 + 13.3						
						0 + 89.0						
						0 + 64.8						
0	113.43	107.67	5.76			0 + 41.7						
125	112.66	106.52	6.14	125+55.7 (O.H.)								
124	112.56	106.42	6.14									
					123+28.8	123+26.8	Seal Off #8547.5 #703		811 E. Murdock		4-20-66 11-30-14	
123	112.15	106.33	5.82	123+14.2								
122	112.99				122+19.0	122+17.0						
121	111.74	106.12	5.62	121+47.0								
						120+57.8						
						120+55.8						
120	114.80	106.02	8.72	120+19.6								

ALTERATION W. SUB. D. S.S. NO. 1
L. & L. VAN LINE S.S.

				0+00 ℄ New MH.								
0+00	112.5	106.15	4.3									
	112.5	106.17	4.3	0+57 3								
1+00	112.5	106.19	6.3									
	112.8	106.21	6.6	1+37 4								
	113.3	106.23	7.1	1+94 2	6" Stub NE		#5380		811 E Murdock		4-1-66	

80. C46706 - 801 E. Murdock - 9-18-74 - J. Spaulding (0+69.3)
C13229 - 701 E Murdock - Joe Spaulding 3-21-69 - Tap (3+23.7)
#297 - 6 on 8 wye - 825 E. Murdock - 3-8-54 - Joe McDonald
#695 - Tap - Reynolds Plbg. - 701 E. Murdock rear - 5-4-56
#9316 Seal Off - 715 E. Murdock - J.C. Lewis - 2-5-59
#5380 - 811 E. Murdock - Kobeck Plbg. 4-1-66 (6" Stub NE - M.N. - 1+95)
#C-1273 - 721 E Murdock - Geo Griffin - 12-19-66 (2+92.7)
94-22907 22294 721 E. Murdock N/C