A 377

EAST SUB-MAIN "D" ON PINE ST. AND PROP. LINE NORTH
S.S. No. 1 - 1889

Plat 9-47

TRAP AREA

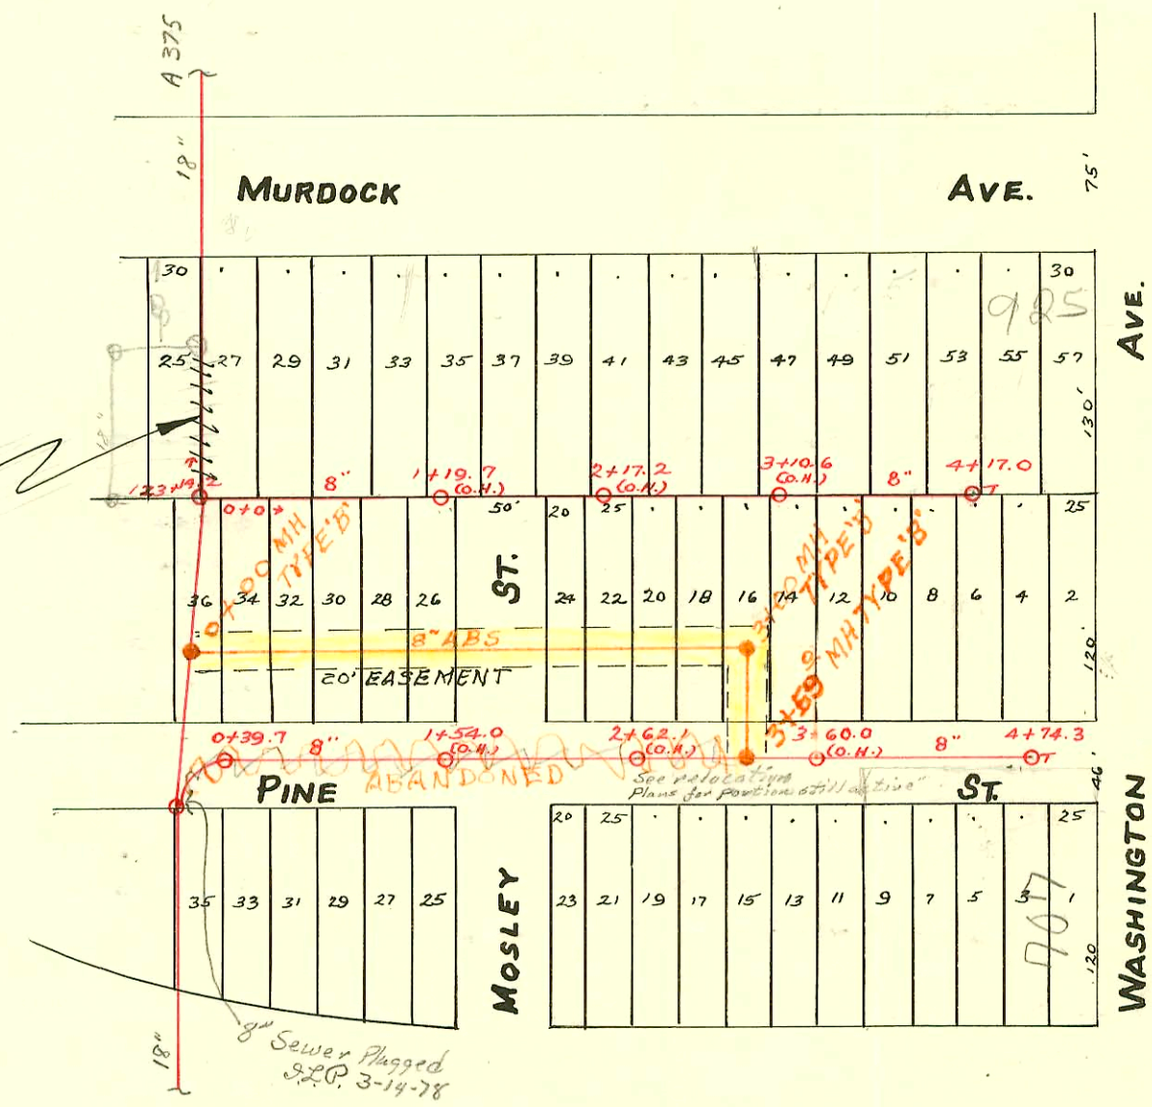

See page 375 for Relocation

RELOCATION FRISCO WAREHOUSE S.S.
BUILT BY: UTILITY CONTR. INC.
PROJ. No DBKW 707070
BOOKED 3-21-78 FROM MRT 7

Form 41-(54) 6-56

CONSTRUCTION RECORD							SERVICE RECORD					
STATION	ELEVATION		Depth	MANHOLE	4-INCH "Y" BRANCHES		No. of Permit		House Number		DATE OF PERMITS	
	Ground	Grade			North West	South East	North West	South East	North West	South East	North West	South East
				4+17.0	← M.H.	tap	C23675		825 E. Murdock		4-9-71	
4	112.44	108.64	3.80		4+14.6	4+12.6	#1353	#B4281	857 E. Murdock	707 N. Washington	11-13-22	9-27-65
					3+90.2	3+88.2 bd #B5518	#1658		849 E. Murdock		4-26-66 12-5-22	
						3+63.0						
					3+61.0	3+38.0						
					3+31.7	3+13.0						
3	111.91	108.39	3.52		3+03.0							
						2+87.5						
					2+75.2	2+63.3	bd #B5759 #565		835 E. Murdock		6-3-66 5-25-25	
					2+46.8	2+38.6						
2	111.93	108.14	3.79		2+15.4	2+13.4	#1279		833 E. Murdock		10-2-22	
					1+84.0	1+88.1	SO #36922					
					1+53.3	1+63.5	#1771		827 E. Murdock		1-29-73 12-28-22	
					1+21.7	1+38.8	SO #36921 #1770		825 E. Murdock		1-29-73 12-28-22	
1	112.77	107.89	4.88			1+18.3						
					0+99.0	0+88.6						
					0+68.2	0+62.4						
					0+37.8	0+39.8	#169		No Record		3-17-11	
0				0+0		0+14.5						
	112.46	108.73	3.73	4+74.3								
						4+71.0		#818		712-14 N. Washington		7-7-43
						4+52.8						
						4+27.7						
4	112.08	108.54	3.44			4+03.5						
						3+80.5						
						3+53.6						
						3+29.3						
3	112.11	108.27	3.84			3+04.6						
						2+79.5						
						2+58.3						
						2+34.2						
2	112.17	108.02	4.15			2+09.0						
						1+84.5						
						1+60.4						
						1+35.7						
1	112.33	107.77	4.56			1+11.6						
						0+85.5						
						0+59.0						
						0+42.3						
0	112.78	107.62	5.16	0+39.7								
RELOC FRISCO WHSE SAN SEWER												
0+00	115.5	107.05	8.5	0+00	6" tap 0+13		C67065		805 E. Murdock		6-26-78	
1+00		107.40			6" tap 1+01		C67066		805 E. Murdock		6-26-78	
2+00		107.75			6" tap 2+28		C67079		805 E. Murdock		6-26-78	
3+00	115.5	108.10 108.20	7.4 7.3	3+00								
	116.0	108.38 108.48	7.6 7.5	3+59.0								

C37173 - 825 E. Murdock - Joe Spaulding - 2-13-73 (1+19)

93-29906 7 12-1-93 707 N Washington - 4+69.3 = 4" S.D.R. 35.