



Plat 9-51

TRAP AREA

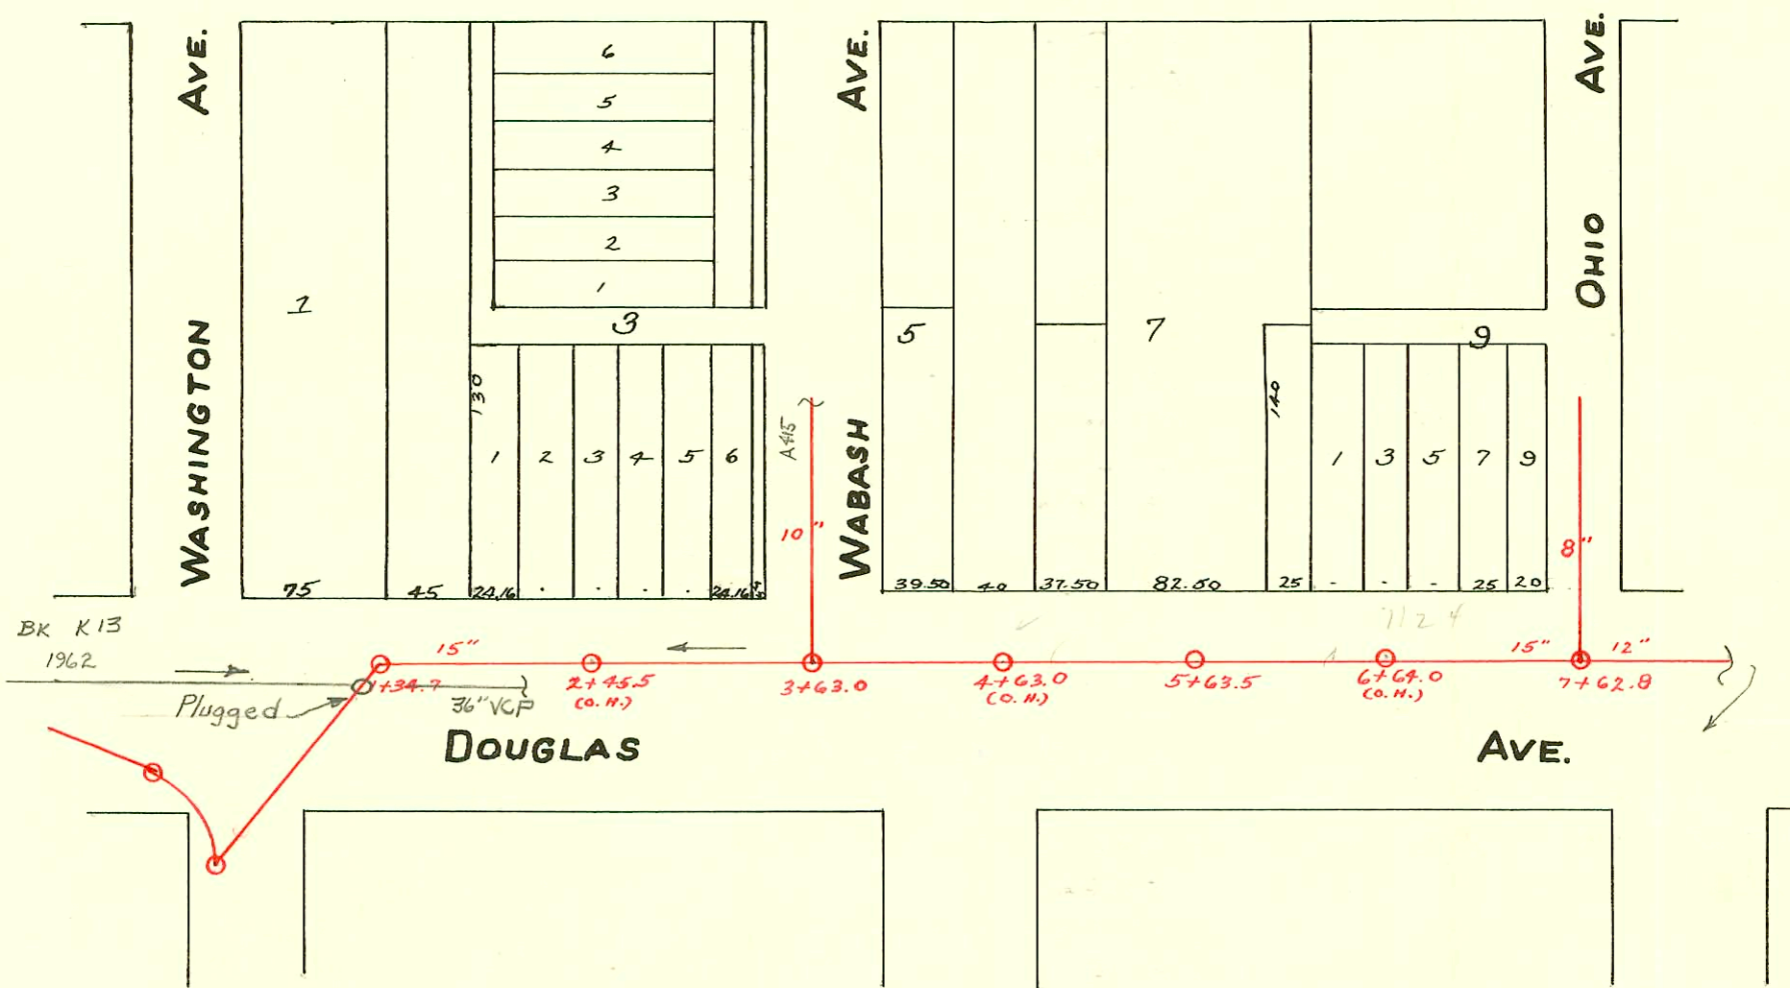

S.S. No. 2 - 1900 -
S.S. No. 20 - Dist. Y - 1920
SCALE 1" = 100'

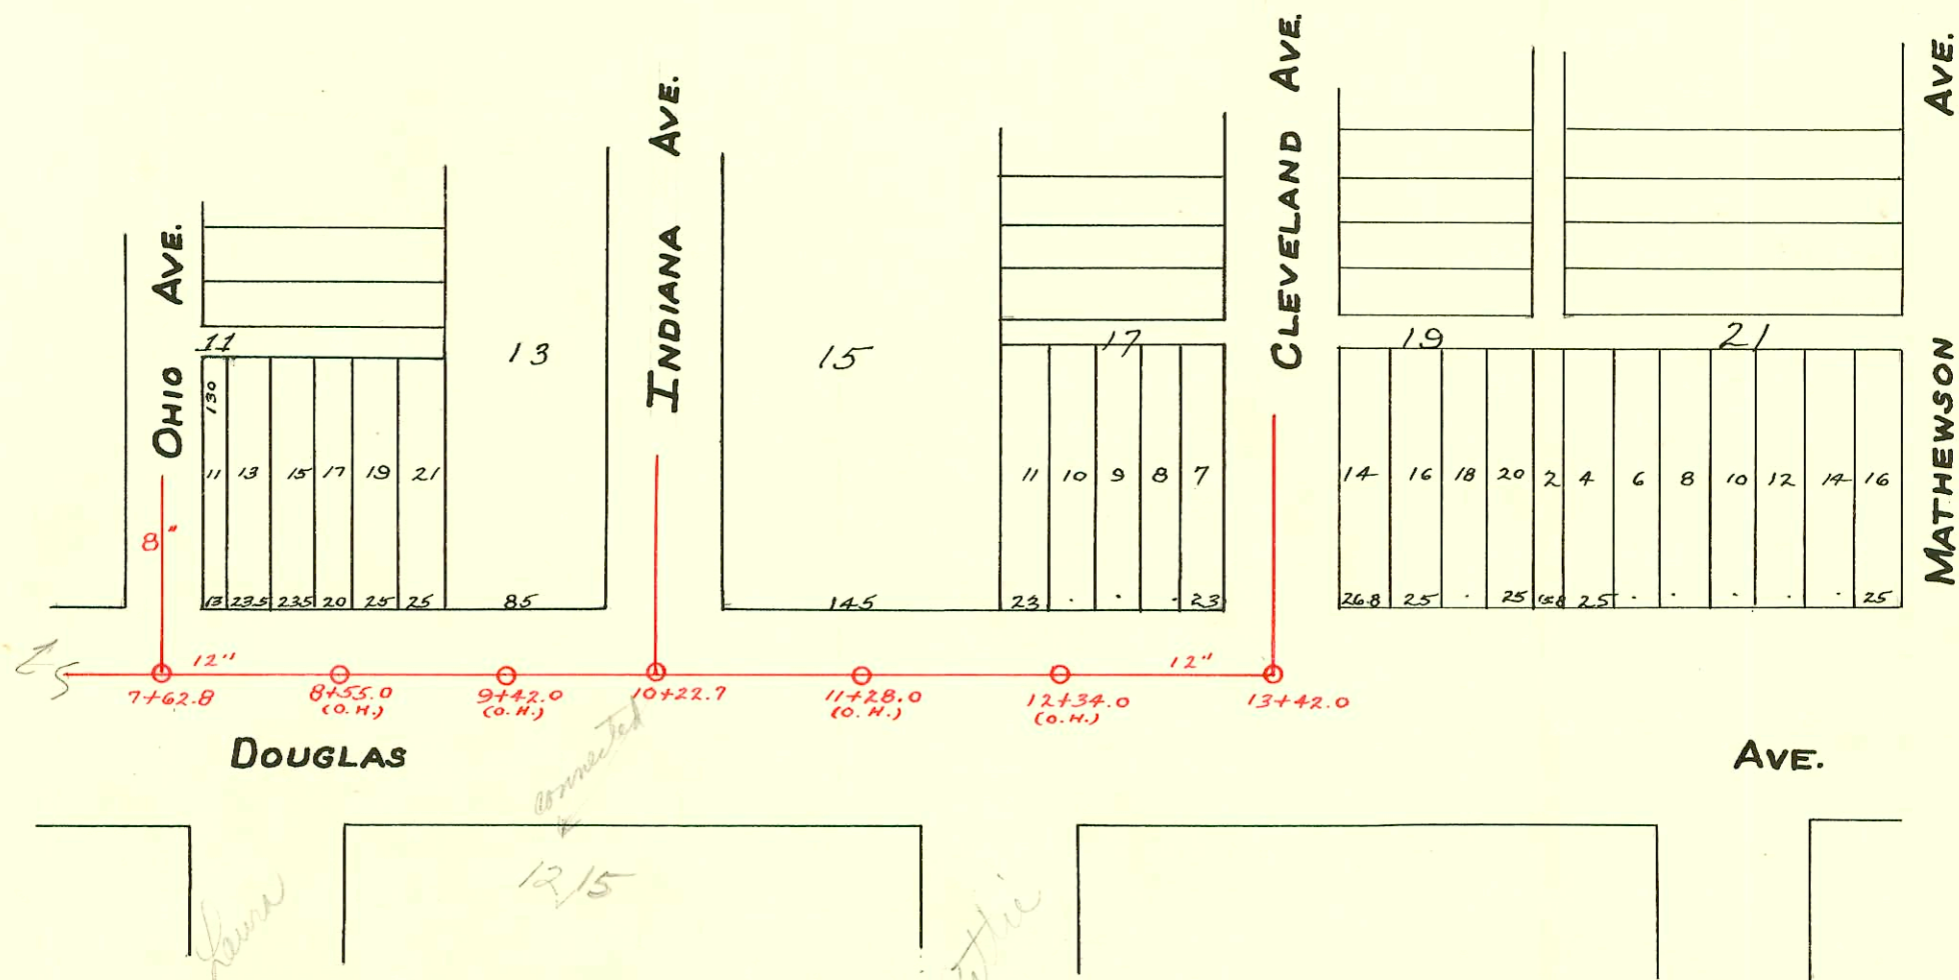

CONSTRUCTION RECORD						SERVICE RECORD						
STATION	ELEVATION		Depth	MANHOLE	4-INCH "Y" BRANCHES		No. of Permit		House Number		DATE OF PERMITS	
	Ground	Grade			North West	South East	North West	South East	North West	South East	North West	South East
				13+42.0								
13	106.73	103.00	3.73		13+07.0							
					12+92.0							
					12+67.0							
					12+42.0							
12	106.79	102.90	3.89		12+16.6							
					11+91.0							
					11+66.0							
					11+38.3							
11	106.75	102.80	3.95		11+13.0							
	106.94	102.72	4.22		10+88.0							
10	106.59	102.70	3.89		10+62.8							
					9+80.0							
					9+55.0							
					9+30.0							
9	106.85	102.60	4.25		9+05.0							
					8+78.0							
					8+53.0							
8	106.95	102.50	4.45		8+33.8							
					7+81.8							
	107.20	102.46	4.74	7+62.8	7+34.0							
7	107.13	102.40	4.73		7+08.5							
					6+84.5							
					6+59.0							
					6+33.0			#2072	1124 E. Douglas		9-11-24	
6	107.42	102.30	5.12		6+07.0							
					5+80.0							
					5+54.0							
				5+63.5	5+28.0							
5	107.68	102.20	5.48		5+02.0			#33	Remains Store		4-2-03	
					4+76.0							
					4+51.0							
					4+25.5							
4	108.01	102.10	5.91		4+00.0							
	108.20	102.06	6.14		3+27.0							
3	108.31	102.00	6.31	3+63.0	3+02.0							
					2+76.0							
					2+51.0							
2	108.32	101.90	6.42		2+20.5							
					1+98.0							
					1+70.7							
					1+44.2							
1	108.60	101.80	6.80	1+34.7	1+18.0							
0	108.23	101.70	6.53									

Used old connection 1020 E. Douglas - 12-14-50 - Wichita Pkg. Co.