


WABASH - LATERAL WEST  
S.S.No.2-1900- S.S.No. 2 - DIST. Y-1920

Plat 9-51

TRAP AREA

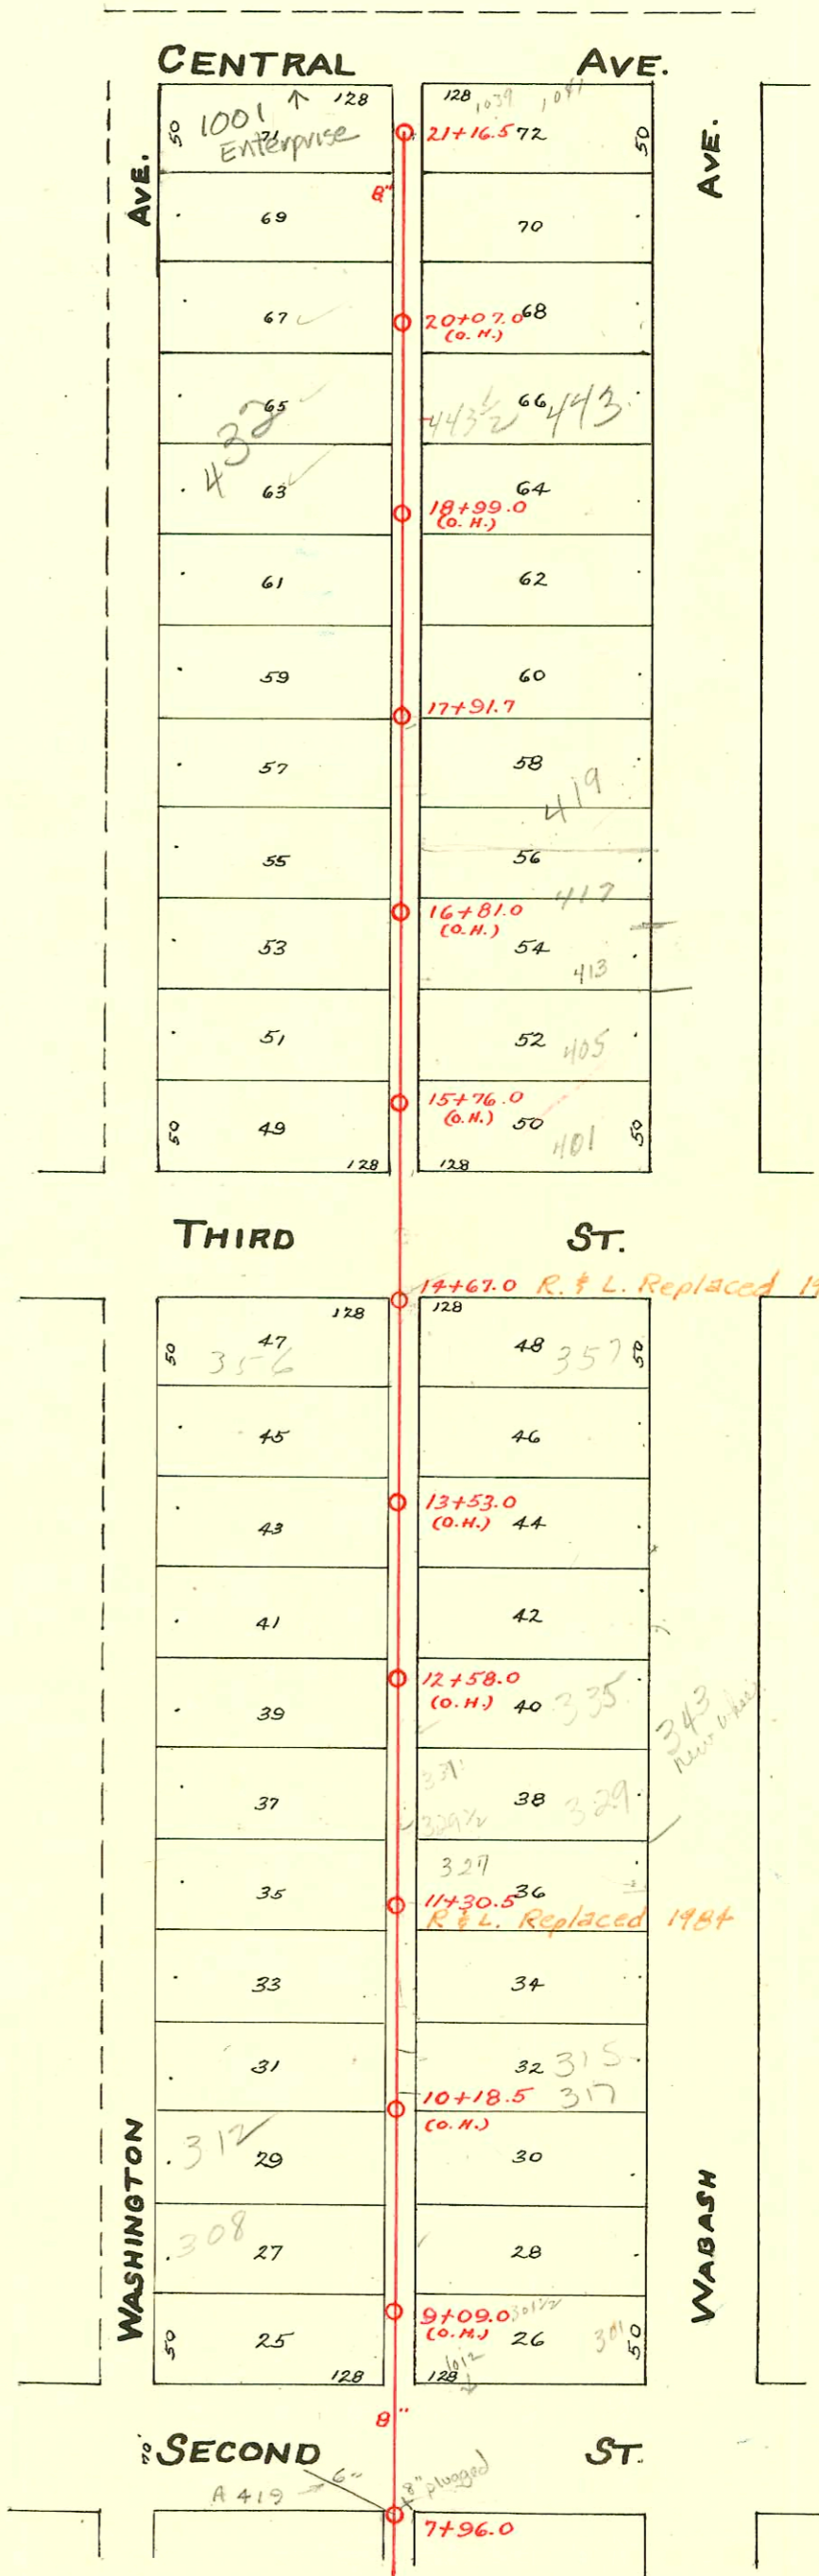

CONSTRUCTION RECORD

SERVICE RECORD

STATION	ELEVATION		Depth	MANHOLE	4-INCH "Y" BRANCHES		No. of Permit		House Number		DATE OF PERMITS			
	Ground	Grade			EAST	WEST	EAST	WEST	EAST	WEST	EAST	WEST	EAST	WEST
				21+16.5										
21	110.48 110.65	107.74 107.71	2.74 2.94		21+13.0 20+98.5 20+73.5 20+47.5 20+22.5	21+08.5 20+96.0 20+71.0 20+45.0 20+20.0	#3093 #3504 #71 #1648	2000-02664 #3804 #193 2000-02665 #71	1039 1039 E. 1039 E. 446 N. Washington	1001 E Central 1001 E. Central 1001 E. Central	1-31-66 2-5-41 6-12-67 3-31-02 12-2-22	12-6-20 7-14-41 2-24-04 12-6-00 2-2-26		
20	110.72	107.51	3.21		19+97.5 19+72.5 19+47.5 19+22.0 18+97.0 18+76.5 18+51.5 18+26.5 18+00.5	19+95.0 19+70.0 19+45.0 19+19.5 18+94.5 18+74.0 18+49.0 18+24.0	#997 #303 #29665 #155 #5432 #1648	#39499 #650 #1248 #267 #286	436 N. Washington 442 N. Washington 443 N. Washington 426 N. Washington	444+461 444+461 444+461 444+461 444+461 444+461 444+461 444+461 444+461	7-9-23 7-9-23 7-11-73 3-1-23 6-22-73 10-18-74 2-24-23 8-7-57 12-2-22	5-26-72 5-1-23 8-22-23 8-14-07 2-28-23		
19	111.06	107.31	3.75		17+91.7 17+72.5 17+47.0 17+21.5 16+96.5 16+71.5 16+46.5 16+21.5 15+96.5 15+71.5 15+46.5 14+67.0 14+27.0 14+01.5 13+76.5 13+51.0 13+26.0 13+03.5 12+78.5 12+53.0 12+26.5 12+01.5	17+98.0 17+70.0 17+44.5 17+19.0 16+94.0 16+69.0 16+44.0 16+19.0 15+94.0 15+69.0 15+44.0	#278 #266 #17466 #294 #13121 #1693 #13259 #570 #346 #294 #174 #1237 #800 #53 #693 #245 #2688 5541 #609 #334 #2380 #243 #1807 #1609 #159 #83 #237 #223 #219 #169 #311 #220 #109 #1674 #485 #3097 #433	#693 #266 #17466 #294 #13121 #1693 #13259 #570 #346 #294 #174 #1237 #800 #53 #693 #245 #2688 5541 #609 #334 #2380 #243 #1807 #1609 #159 #83 #237 #223 #219 #169 #311 #220 #109 #1674 #485 #3097 #433	425 Wabash 423 N. Washington 419 Wabash 417 Wabash 417 Wabash 413 Wabash 410 N. Washington N.W. Cor. Wabash & 3rd 357 Wabash 346 N. Washington 334 N. Washington 334 N. Washington 334 N. Washington 338 N. Washington 335 Wabash 332 N. Washington 343 Wabash 332 N. Wash 327 N. Wash 327 Wabash 323 Wabash 320 N. Washington 318 N. Washington 309 Wabash 309 Wabash 305 Wabash 301 Wabash 303 N. Wash 1004 E. 2nd 302 N. WASHINGTON	2-26-23 2-24-23 3-13-69 11-12-69 9-16-02 3-25-69 7-21-20 3-8-23 9-13-05 2-19-60 11-2-17 4-22-07 12-16-10 5-4-65 2-21-23 12-5-49 11-1-57 11-16-10 9-3-52 2-21-23 7-7-52 11-1-23 4-11-77 3-3-20 4-11-77 5-4-06 6-10-16 11-12-07 10-3-08 10-14-01 9-5-05 11-9-07 4-24-07 6-19-07 12-9-48 6-13-07 2-5-41 7-14-09	5-8-23 2-24-23 8-14-07 2-28-23 5-8-23 2-24-23 3-13-69 8-1-63 4-19-20 6-12-85 2-28-23 7-28-2 4-22-07 12-16-10 5-4-65 2-21-23 12-5-49 11-1-57 9-13-04 9-3-52 2-21-23 7-7-52 3-3-20 6-10-16 11-12-07 9-5-05 4-24-07 6-19-07 8-4-09 2-5-41 7-14-09			







