A 445

LAT. 3- NORTH
S.S. No. 4- 1907- DIST. Y- S.S. No. 20- 1920

Plat 9-54

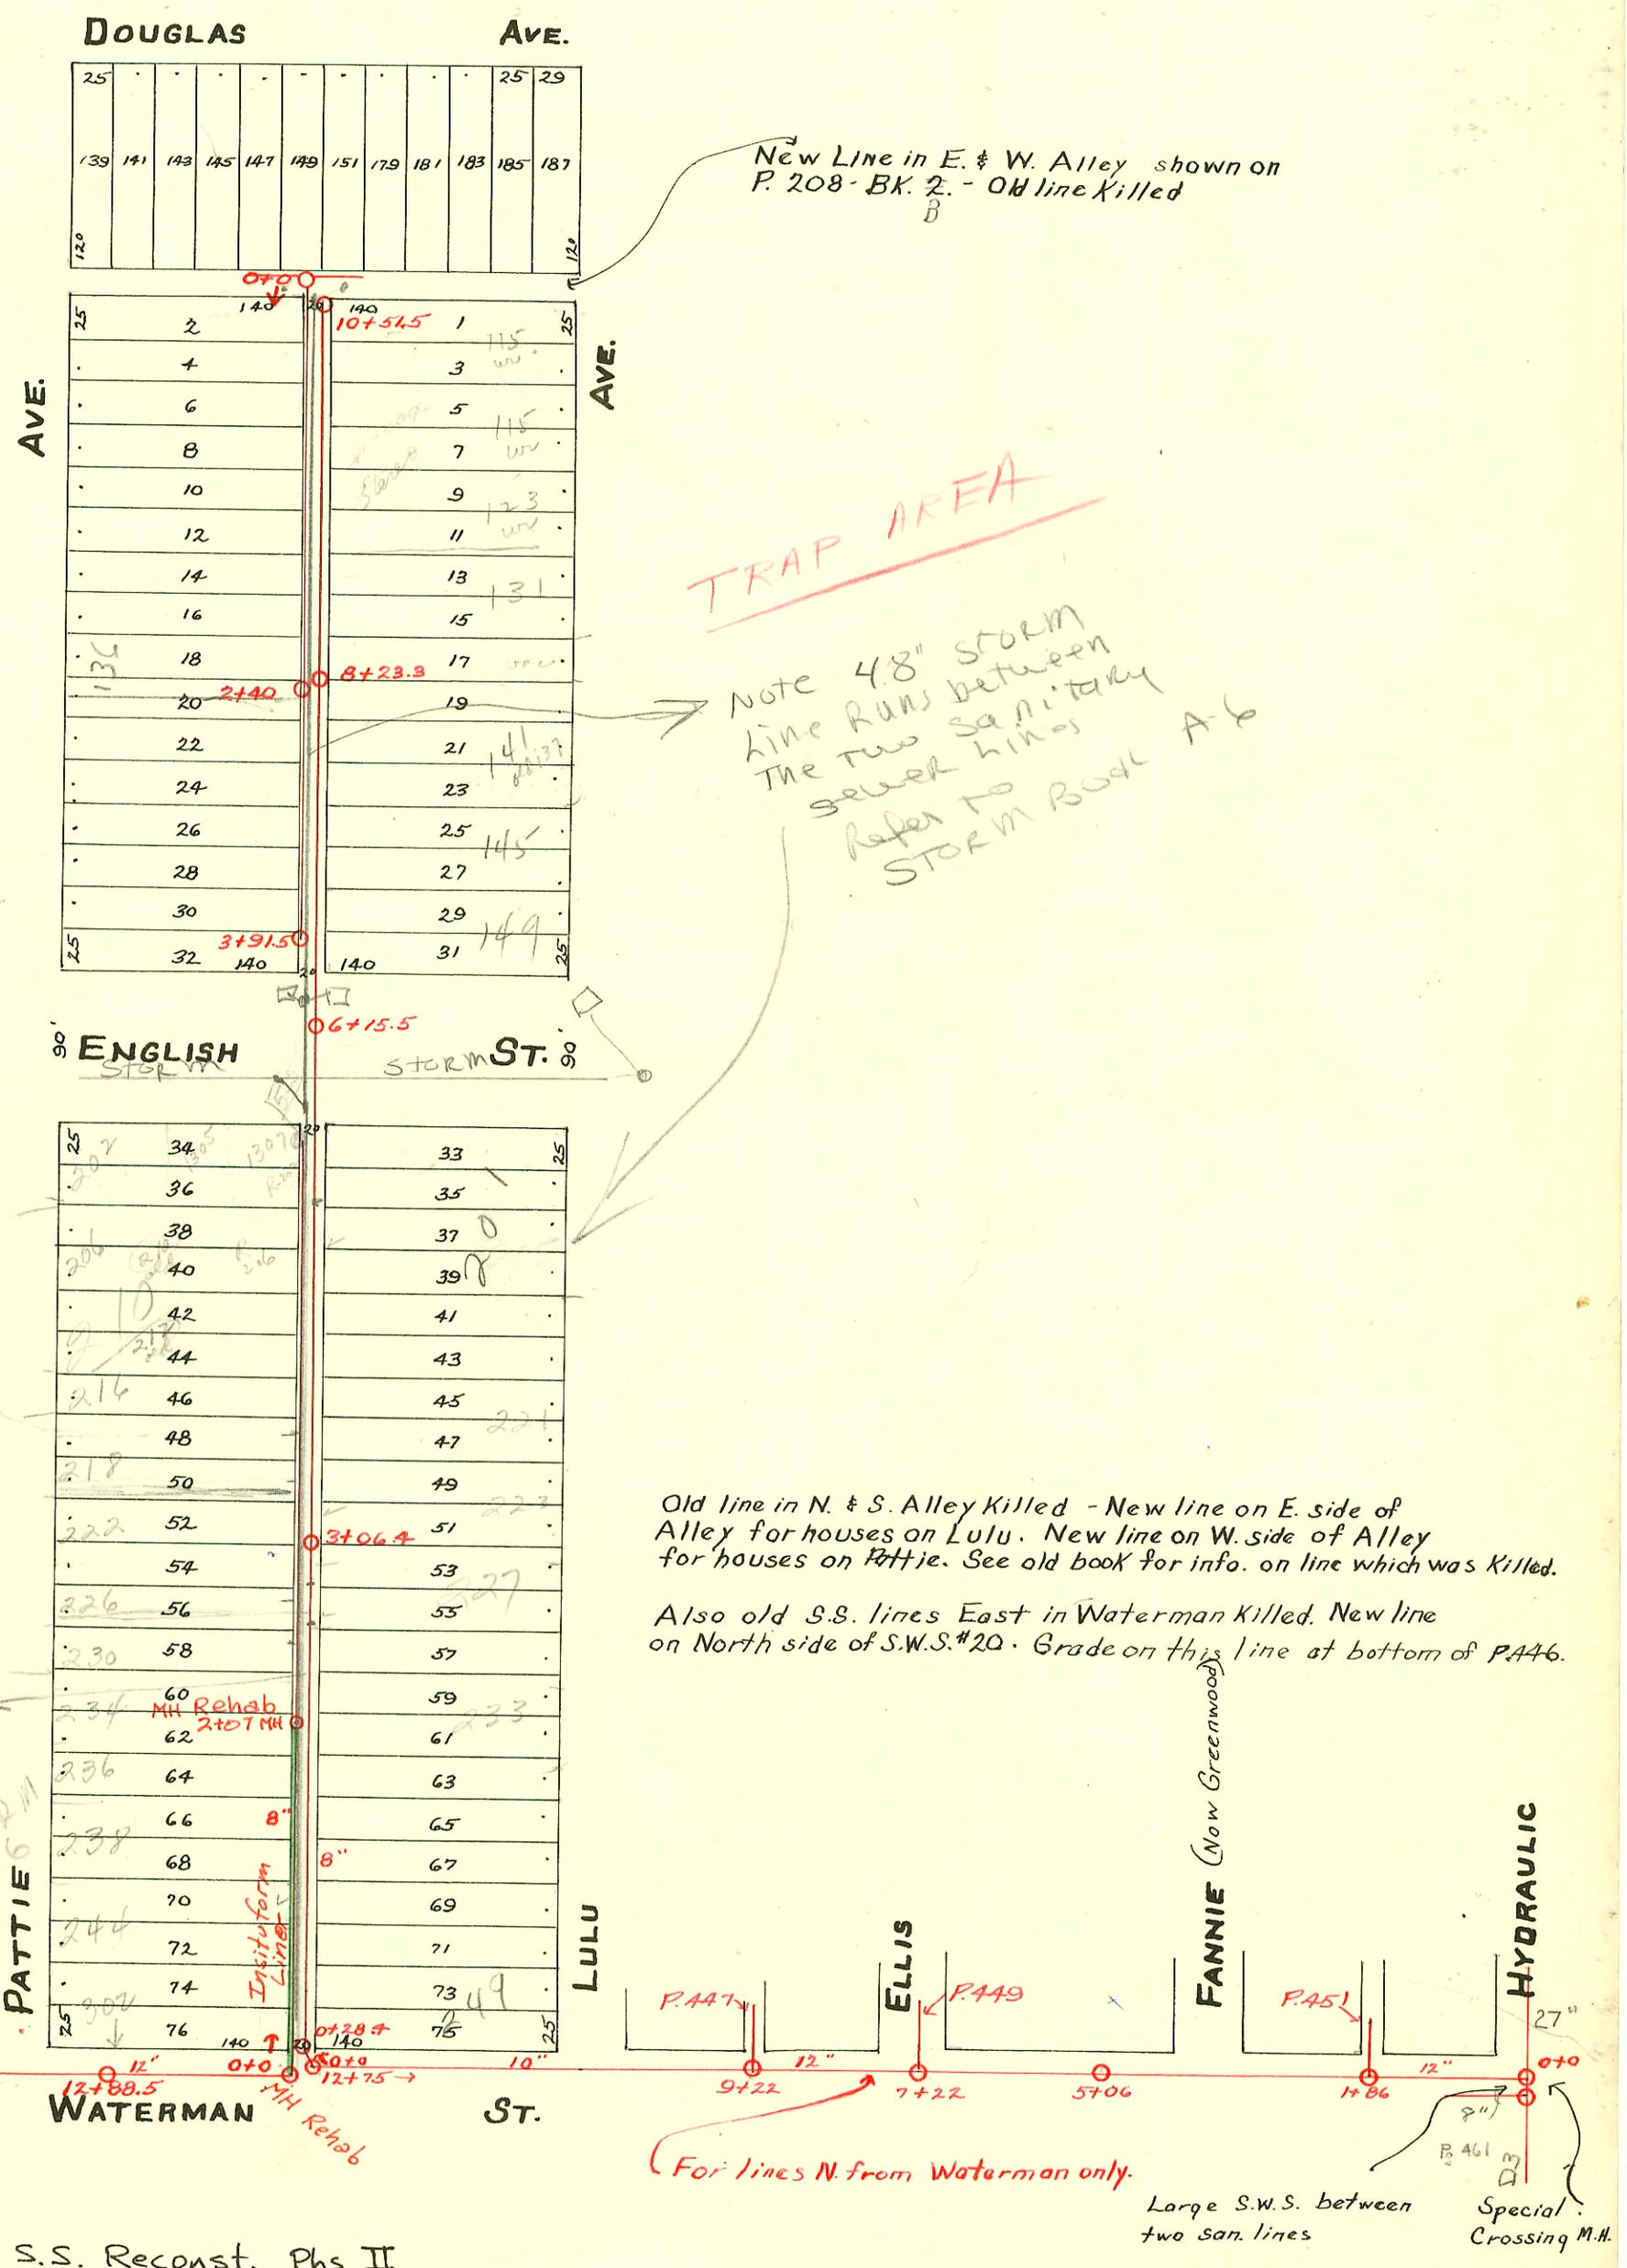

1989 S.S. Reconst. Phs II
468-82011 (725002)
Built By Insituform Plains
Booked 10-16-90 from Plan

98-16547 - 10-15-98
#93-3101-7 - 249 S. Lulu - Replace - 4" ABS 40 - Replaced upper 8' of sewer and 11' of line under west side of house, 14' of shallow

2000-01758 8/1/00 149 S. Lulu - Sempled San Plbg - 4" SCH 40 CO RISER ONLY, 1-16x4 Fernco

Form 41-(54) 6-56

CONSTRUCTION RECORD / SERVICE RECORD

	STATION	ELEVATION Ground	ELEVATION Grade	Depth	MANHOLE	4-INCH "Y" BRANCHES North West	4-INCH "Y" BRANCHES South East	No. of Permit North West	No. of Permit South East	House Number North West	House Number South East	DATE OF PERMITS North West	DATE OF PERMITS South East
Line bet. Pattie & Lulu from Waterman North. On E. Side of Alley for houses facing Lulu.	0+0	106.69	99.56	7.13	0+0.		0+61.3		93-31017 connected		249 Lulu		2-17-93
					0+28.4		0+85.5			Wye's marked "connected" were hooked up as sewer was built.			
	1+0	107.41	99.66	7.75			1+00		connected				
							1+31		connected				
							1+53.6						
							1+74.2		connected				
							1+94.5						
	2+0	107.45	99.76	7.69			2+07.2		#B3648 connected		233 Lulu		6-23-65
							2+33						
							2+60.5		12975 dead off connected		227 Lulu		7-8-60
							2+86.3						
	3+0	106.63	99.86	6.77	3+06.4		3+10		13747 connected		223 Lulu		1-9-61
							3+35						
							3+63.5						
							3+83		dead B3807 Connected		221 Lulu		7-16-65
	4+0	106.16	99.96	6.20			4+08.5						
							4+32						
							4+57.6		Connected				
							4+85.7		dead B3801 Connected		205 Lulu		7-16-65
	5+0	105.94	100.06	5.88			5+09.8		Connected				
							3+42.0 tee ~~5+32~~ 4 PROS		22109		201 S. Lulu		11-30-88
					6+15.5		~~6+68.5~~		?		149 LuLu		?
							~~6+96~~						
	6+0	106.10	100.16				7+18.5						
							7+44.3		dead #C14809 Connected #C15122		145 Lulu 145 Lulu		7-8-69 7-30-69
	7+0	107.14	100.26				7+69.8						
							7+96						
	8+0	109.07	100.36				8+16.6		connected				
					8+23.3		8+42.7						
							8+72.7						
	9+0	109.24	100.46				8+94		connected		131 Lulu		
							9+19						
							9+44.7		Connected		123 Lulu		
							9+45.5 ~~9+69.5~~		C70010		121 Lulu		12-29-98
							9+97.6		Connected		115 Lulu		
	10+0	108.96	100.56				10+27.2						
	10+51.5	108.72	100.61		10+51.5		10+48.5		Connected		115 Lulu		
Line bet. Pattie & Lulu. Alley S. of Douglas to English. On W. S. Alley for houses facing Pattie	0+0	107.91	99.87	8.04	0+0	0+15		connected					
						0+31		connected - trap					
						0+70							
	1+0	109.23	99.97	9.26		1+01							
						1+23							
						1+49							
						1+72		#2456		122 Pattie		4-8-49	
						1+99		96-17460-7		136 Pattie		10-24-96	
	2+0	108.64	100.07	8.57	2+40	2+29.5		#2356				5-4-48	
						2+54							
						2+72.5							
						2+95.5							
	3+0	107.50	100.17	7.33		3+21							
						3+47							
						3+61		Connected					
	3+91.5	106.05	100.26	5.79	3+91.5	3+76		Connected					
Line bet. Pattie & Lulu, Waterman No. On W.S. Alley for houses facing Pattie.					0+0	0+31.6	4"Y						
						0+53.6	6"Y	Connected					
						0+78.4	4"Y						
						0+99	6"Y	Connected					
						1+22	4"Y	#149		240 Pattie		5-14-36	
						1+31	6"Y	12872 Connected		238 Pattie		1-4-85	
						1+57	4"Y						
						1+77.4	6"Y	13091 connected		236 Pattie		1-4-85	
					2+07 Alt	2+02.5 1+96.0 Alt	4"Y	13020		236 Pattie		2-1-85	
						2+29	6"Y	91-35767-7 connected		234 S/O Pattie		10-22-91	
						2+55.4 S/O edge of alley	6"Y	96-1987		230 S/O Pattie		1-29-96	
						2+81	4"Y						
						3+04 S/O edge of alley	6"Y	96-1997 connected		226 S/O Pattie		1-29-96	
						3+27.5	6"Y	91-313067 connected		222 S/O Pattie		8/28/91	
						3+52	4"Y	91-313077					
						3+79	6"Y	connected		218 S/O Pattie		8/28/91	
						4+02	6"Y	connected					
						4+27.5	4"Y						
						4+41	6"Y	connected					
						4+66	4"Y		8907		210 Pattie		2-20-64
						5+04.5	6"Y	connected					
						5+29	6"Y	connected					
						5+50	4"Y						

Connected at 53' N. of M.H. 6+15.5 Field verified 10/9/00

#256 - Tap - 12' S. of M.H. 10+64 - 3-30-22
#7450 - Used old conn. - 250 Pattie - 2-7-52 - Davidson Plbg.
#2406 - Private line - Trailer - 1307 E. Waterman - 9-6-52 - Frederick Plbg.
#3363 - Tap - 202 Pattie - 12-2-52 - Coleman Plbg. Co.
#551 - Tap - 1229 E. Douglas - 5-22-28
#98 - Tap - 144 Pattie - 5-15-46 - Burgan Plbg. Co.

6203 6" Y 244 Pattie Pulley Plbg 2-4-58 (1+15)
#C651 - Seal off - R+ Robertson - 244 Pattie - 10-31-66 (1+15)
#B273 Seal off 202 Pattie - Dean Lee 10-14-63 Sealed at E.P.L.
B684 - Seal off - 206 Pattie - Vern Lappold 1-16-64
B675 - Seal off - 212 Pattie - Vern Lappold 1-16-64
B686 Seal off 216 Pattie - Vern Lappold 1-16-64