


PART OF LAT. 15 FROM DOUGLAS AVE. NO. TO FIRST ST.
SPURR EAST AND WEST IN ALLEYS NO. OF DOUGLAS AVE.

Plat 9-51

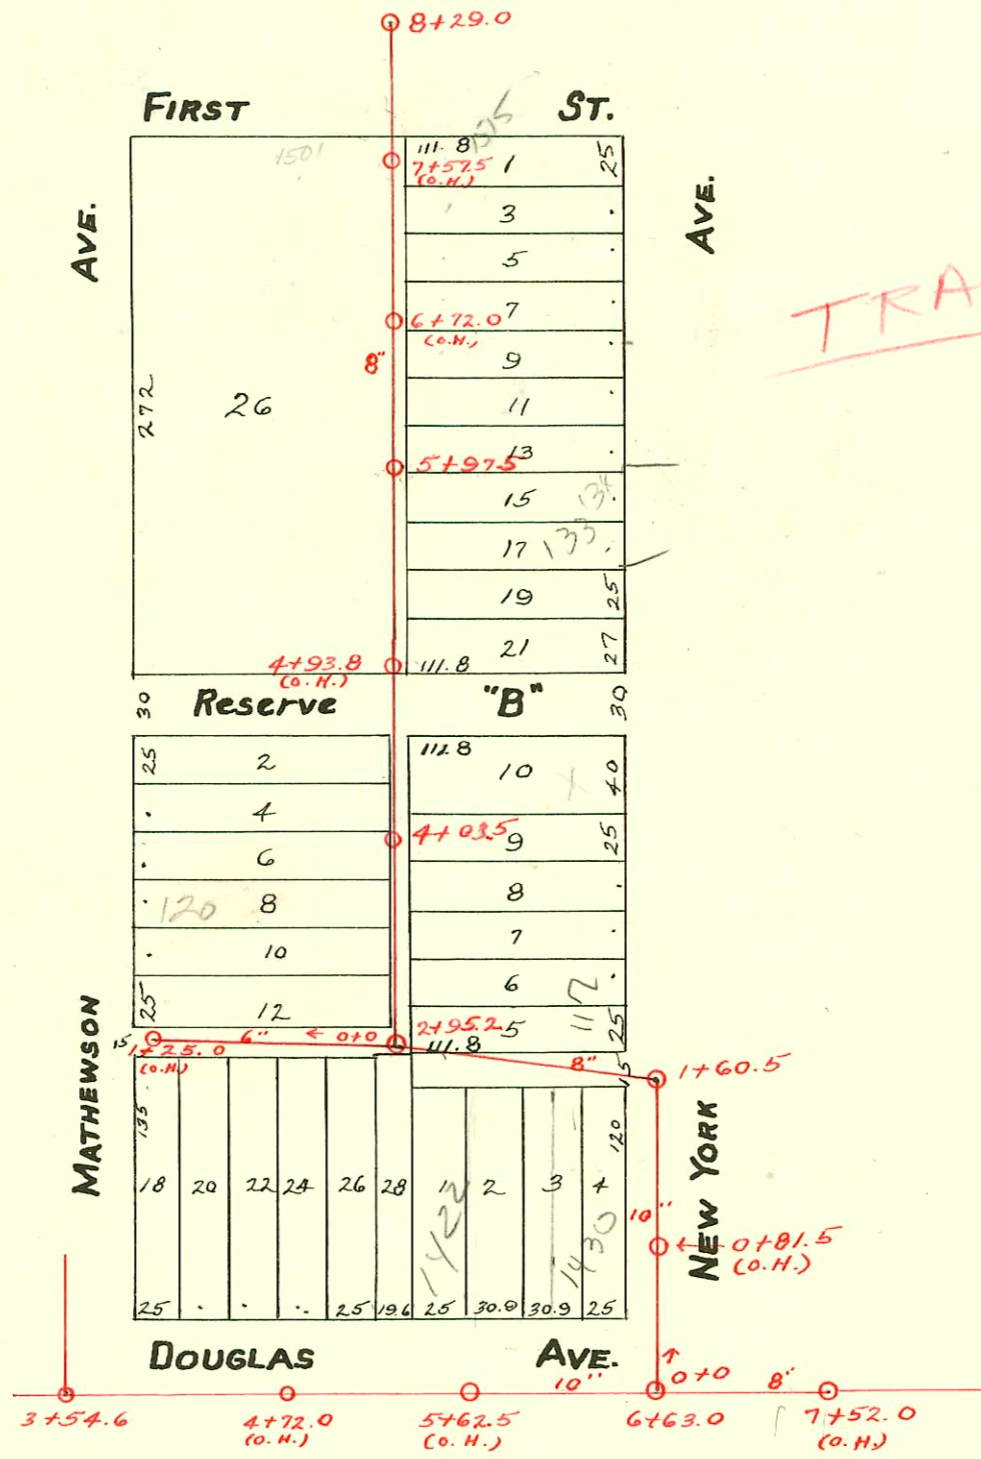

S.S. No. 4 - 1904
Dist. Y - S.S. No. 20 - 1920.

