PART OF LAT. 18 FROM DOUGLAS AVE. TO 1ST ST. BET. PENNSYLVANIA & HYDRAULIC ALSO SRUR WEST IN ALLEY NO. OF DOUGLAS.

S.S. No. 4 - 1904 - S.S. No. 20 - Dist Y - 1920

Plat 9-51

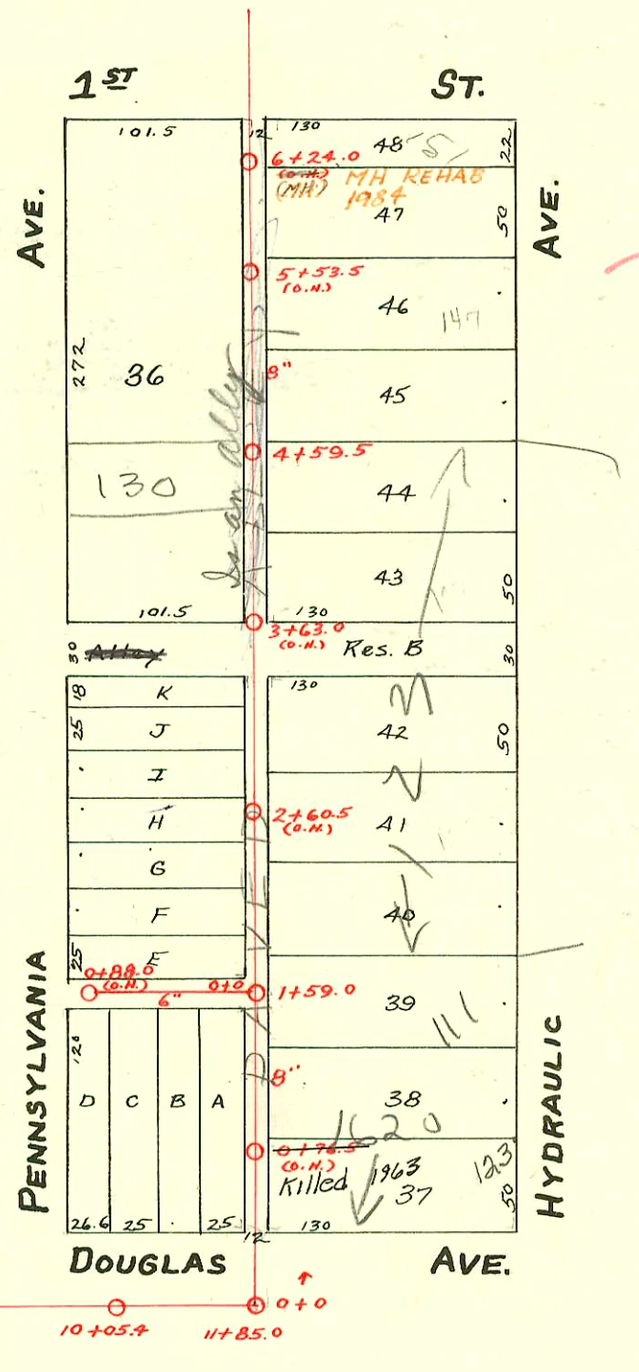

TRAP AREA

470

Form 41-(54) 6-56

CONSTRUCTION RECORD

STATION	ELEVATION Ground	ELEVATION Grade	Depth	MANHOLE	4-INCH "Y" BRANCHES North West	4-INCH "Y" BRANCHES South East
0				0+0		0+32.5
						0+59.0
					0+75	0+84.5
1						1+10.0
						1+37.0
				1+59.0		1+64.5
					1+66.5	1+82.0
					1+84.0	
2					2+09.5	2+07.5
					2+37.0	2+35.0
					2+65.0	2+63.0
					2+90.3	2+88.3
3					3+12.5	3+10.5
					3+38.0	3+36.8
					3+61.0	3+59.0
					3+85.0	3+83.5
					Seal off 4+10.8	4+08.8
4					4+35.5	4+33.5
				4+59.5		
					4+67.8	4+65.8
					4+93.0	4+91.0
5					5+17.8	5+15.8
					5+43.2	5+41.2
					5+68.5	5+66.5
					5+94.0	5+92.0
6					6+18.6	6+16.6
			5.0	6+24.0 (O.H.) MH		

Spur West in Alley No. of Douglas.

0	0+0		
		0+07.0	
		0+31.5	
		0+58.0	
		0+86.0	
	0+88.0 (O.H.)		

SERVICE RECORD

No. of Permit North West	No. of Permit South East	House Number North West	House Number South East	DATE OF PERMITS North West	DATE OF PERMITS South East
			1650 E Douglas		4-3-63
	#240		1705 N.		12-4-07
#286	#261	1650 E Douglas 107 N	Hydraulic	5-12-17	3-29-29
#721	#16884 Sidney	Hydraulic	1650 E Douglas	9-29-17	4-3-63
			111 N. Hydraulic		5-28-19
	#954				
			1157 N. Hydraulic		7-3-17
#722	#450	120 Pennsylvania	80	9-29-17	
	C4098 #451	123	125 N. Hydraulic		8-30-73 7-3-17
#789	C40980	124 Pennsylvania	80	3-24-19	
B4837 #593	#547	124 Pennsylvania	127 N. Hydraulic	10-13-65 12-19-12	8-30-73 4-17-23
	#427	128	1314		7-15-18
	#392	Pennsylvania 130 N. 50 Pennsylvania	Hydraulic	2-15-13 7-2-79 2-15-24	7-2-18
C72669 #210			139 N Hydraulic		7-21-17
	#516				
	#409		145 N. Hydraulic		6-18-17
	#516 66		141 N. Hydraulic		7-28-47 2-23-15
	C3 8338		1477 N. Hydraulic	Seal off	4-18-73
	#29				3-22-05
B1200	?	1641 E. 124		5-4-64	7-20-11
	8860	1641 E. First	151-153-155 Hydraulic	2-13-47	8-1-83
#1427		S.W. Corner 1st & Pennsylvania	Can. Ind.		
#228	?			5-13-15	7-17-10
			1602 E Douglas		5-28-04
#1578			1712 E. Douglas		11-22-22

N/C 2002-01708 - 123 N Hydraulic - 6/18/02 - Boardman Ent - 4" PVC, ITW IN CO, 1045, New trap, City WYE REPAIR - 6" Predco 96' N of MH 0+0 (0+96)

13489 - (1624 S. Ivy St.) - Al Nenning - 4-17-85 6+24.0 S. (5+46 3/8)

2001-00532 C12670 - (130 N. Pennsylvania S/O Tap) (4+05.3) 3/13/01 AE Henning 5.0.

U69947 (134 N Pennsylvania) - Henning - 12-22-78 (6+12)

B5851 - 137 N Hydraulic - Seal off - Bradford Smith 6-20-66

B5852 - 139 N Hydraulic

Tap - #261 - 107 N. Hydraulic - 3-29-29 - J.C. Hendrick
#1188 - Private line - 1608 E. Douglas - 11-24-47 - C.G. Leidy
#6947 - Tap - 134½ Pennsylvania - 1-2-52 - Joe McDonald.
Tap - 1+0 - 1604 E. Douglas - 8-18-38.

#16884 - 1650 E. DOUGLAS - MOORE ROBERTSON CORRECTION

B 958 - 1645 E. Inc - Al Henning - Seal off 3-3-64

B-W336 - 124 N. Pennsylvania, Moore - Robertson - Seal off - 10-13-65