

LAT. No. 2
SUB-LAT. No. 1
S.S. No. 8-1908

TRAP AREA

175	111	28
175	109	25
175	107	
175	105	
175	103	
175	101	
175	99	1001
175	97	25

15+31 (O.H.)

GLENN AVE.

14+02

12+98.8 (O.H.)

11+92

VINE AVE.

10+55.5 (O.H.)

9+21.2 (O.H.)

8+05

MILLWOOD AVE.

6+98.3 (O.H.)

6+16.5 (O.H.)

4+90.8


4+00.3 (O.H.)

FERN AVE.

630	25	28	25									
95	93	91	89	87	85	83	81	79	77	175	23	25
96	94	92	90	88	86	84	82	80	78	175	21	25

ELIZABETH AVE.

UNIVERSITY

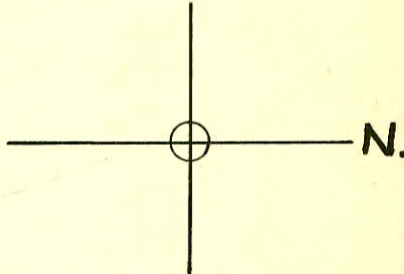

See page 61 for record of this sewer

as per dy
test 3-22-82
JB

CONSTRUCTION RECORD						SERVICE RECORD						
STATION	ELEVATION		Depth	MANHOLE	4-INCH "Y" BRANCHES		No. of Permit		House Number		DATE OF PERMITS	
	Ground	Grade			North West	South East	North West	South East	North West	South East	North West	South East
				17+34.4 F.T.								
17	107.98	105.15	2.8		17+22							
					16+96.5							
					16+71		#894				9-27-21	
					16+59		#652				11-18-18	
					16+45		#1079				11-4-21	
16	108.58	105.00	3.6		16+19							
					15+93		#508		?		11-21-16	
					15+67.5		#6763		615 S. Glenn		10-23-53	
15	107.75	104.85	2.9	15+31 O.H.	14+59		#42				2-9-15	
					14+38.5							
14	108.15	104.70	3.5	14+02	14+08							
					13+82	13+96		#811				11-7-17
					13+56							
					13+29.5		#513				9-9-10	
13	108.24	104.55			13+01.5							
					12+78.5							
					12+49.5		#304				5-24-09	
12	107.69	104.40			12+24		#299				5-21-09	
11	107.94	104.25		11+92	11+98.5							
					10+79							
					10+53		#220		? mar		2-18-24	
					10+27.5		#807		1417 University		5-28-23	
10	108.50	104.10	3.69		10+01.5							
					9+52		#79		1715 University		3-7-09	
					9+77.5							
9	109.01	103.95			9+01		#1650		1707 University		12-4-22	
					8+67.5		#1626		611 So. Millwood		11-28-22	
					8+39							
8	108.81	103.80		8+05	8+13.5		#1218		1703 R University		9-19-22	
7	109.16	103.65			7+01.5							
					6+76		#209				4-21-09	
					6+50.5		#226				4-27-09	
					6+27.5							
6	108.46	103.50			6+01.5							
					5+78		#893				4-21-24	
					5+59.5							
					5+52		#1128				5-16-24	
					5+28.5							
5	108.86	103.35			5+00.5							
				4+90.8	4+78.5							
					4+54.5		#237				5-1-09	
4	108.42	103.20			4+29							
					3+96.8		#453				5-16-11	
					3+32.5							
3	109.64	103.05			3+00		#266		1421 Univ		5-9-10	
					2+86.5							
					2+60.5		#525		1417 University		4-22-69	
					2+34	2+38.5	#460	#509	1415 University	6205 Fern	5-22-11	8-12-09
2	107.67	102.90	4.77		2+08							
				1+88.5	1+80							
					1+54.5		#100		1413 University		5-28-48	
					1+28.5							
1	108.47	102.75			1+02.5		#182				12-13-10	
					0+77		#17				2-4-09	
					0+51.5							
0	108.27	102.60		0+0								
2	108.79	103.78	5.01	2+18 (O.H.)	2+16	2+13.5						
					1+98	1+95.5	#25728		628 S. Fern		7-12-90	
					1+72	1+69.5	#396		629 S. Elizabeth		7-19-13	
					1+46	1+43.5	#157		626 S. Fern		3-22-10	
					1+20.5	1+18	#1367				10-17-22	
1	107.79	103.28	4.51		0+95	0+92.5	#179		624 S. Fern		4-12-73	
					0+69	0+66.5	#173				4-1-09	
					0+41						4-7-13	
					0+17	0+14.5	#371	#91	622 S. Fern	621 S. Elizabeth	5-22-81	3-15-09
0	106.79	102.78	4.01	0+0								

#1043 - Ep - 10-28-21 1625 S. Millwood
 Tap - 612 S. Fern - 12-17-41 - Kansas Pibq. - unable to locate
 #186 - Tap - 1403 University - 6-10-48 - Harley Riggs.
 #187 - Tap - 615 - 617 S. Elizabeth - 6-10-48 - Harley Riggs.
 #4695 - Tap - 1911 University - 5-19-51 - Simmons Pibq.
 #14171 - Tap - 629 S. Elizabeth Riggs Pibq. 5-10-61 (private line conn) - see above
 Tap C13904 - 1417 University - for sprinkling 4-22-69 (2+40.5)
 (Ranched easement on plot at Grand House - 1415 to 1417 University)
 #25729 - 7/2/90 - (630 S. Fern) - Henning (was HOR into Lind for 628 Fern)