S.S. No. 14 - 1909

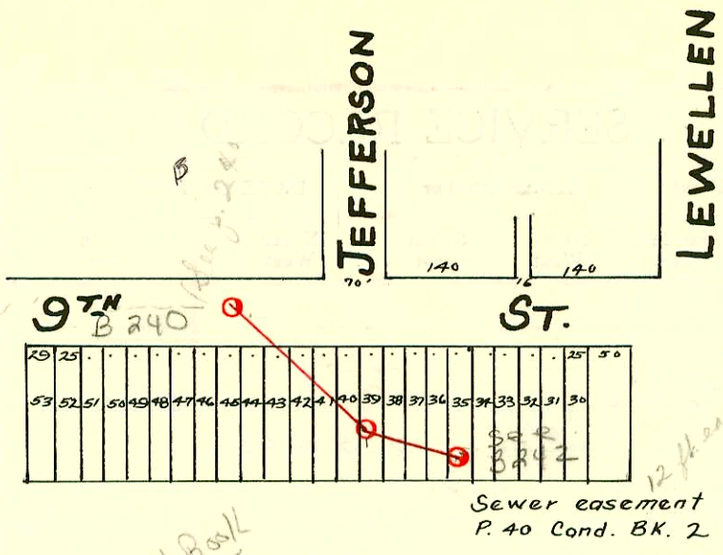

HUDSON PRIVATE SEWER

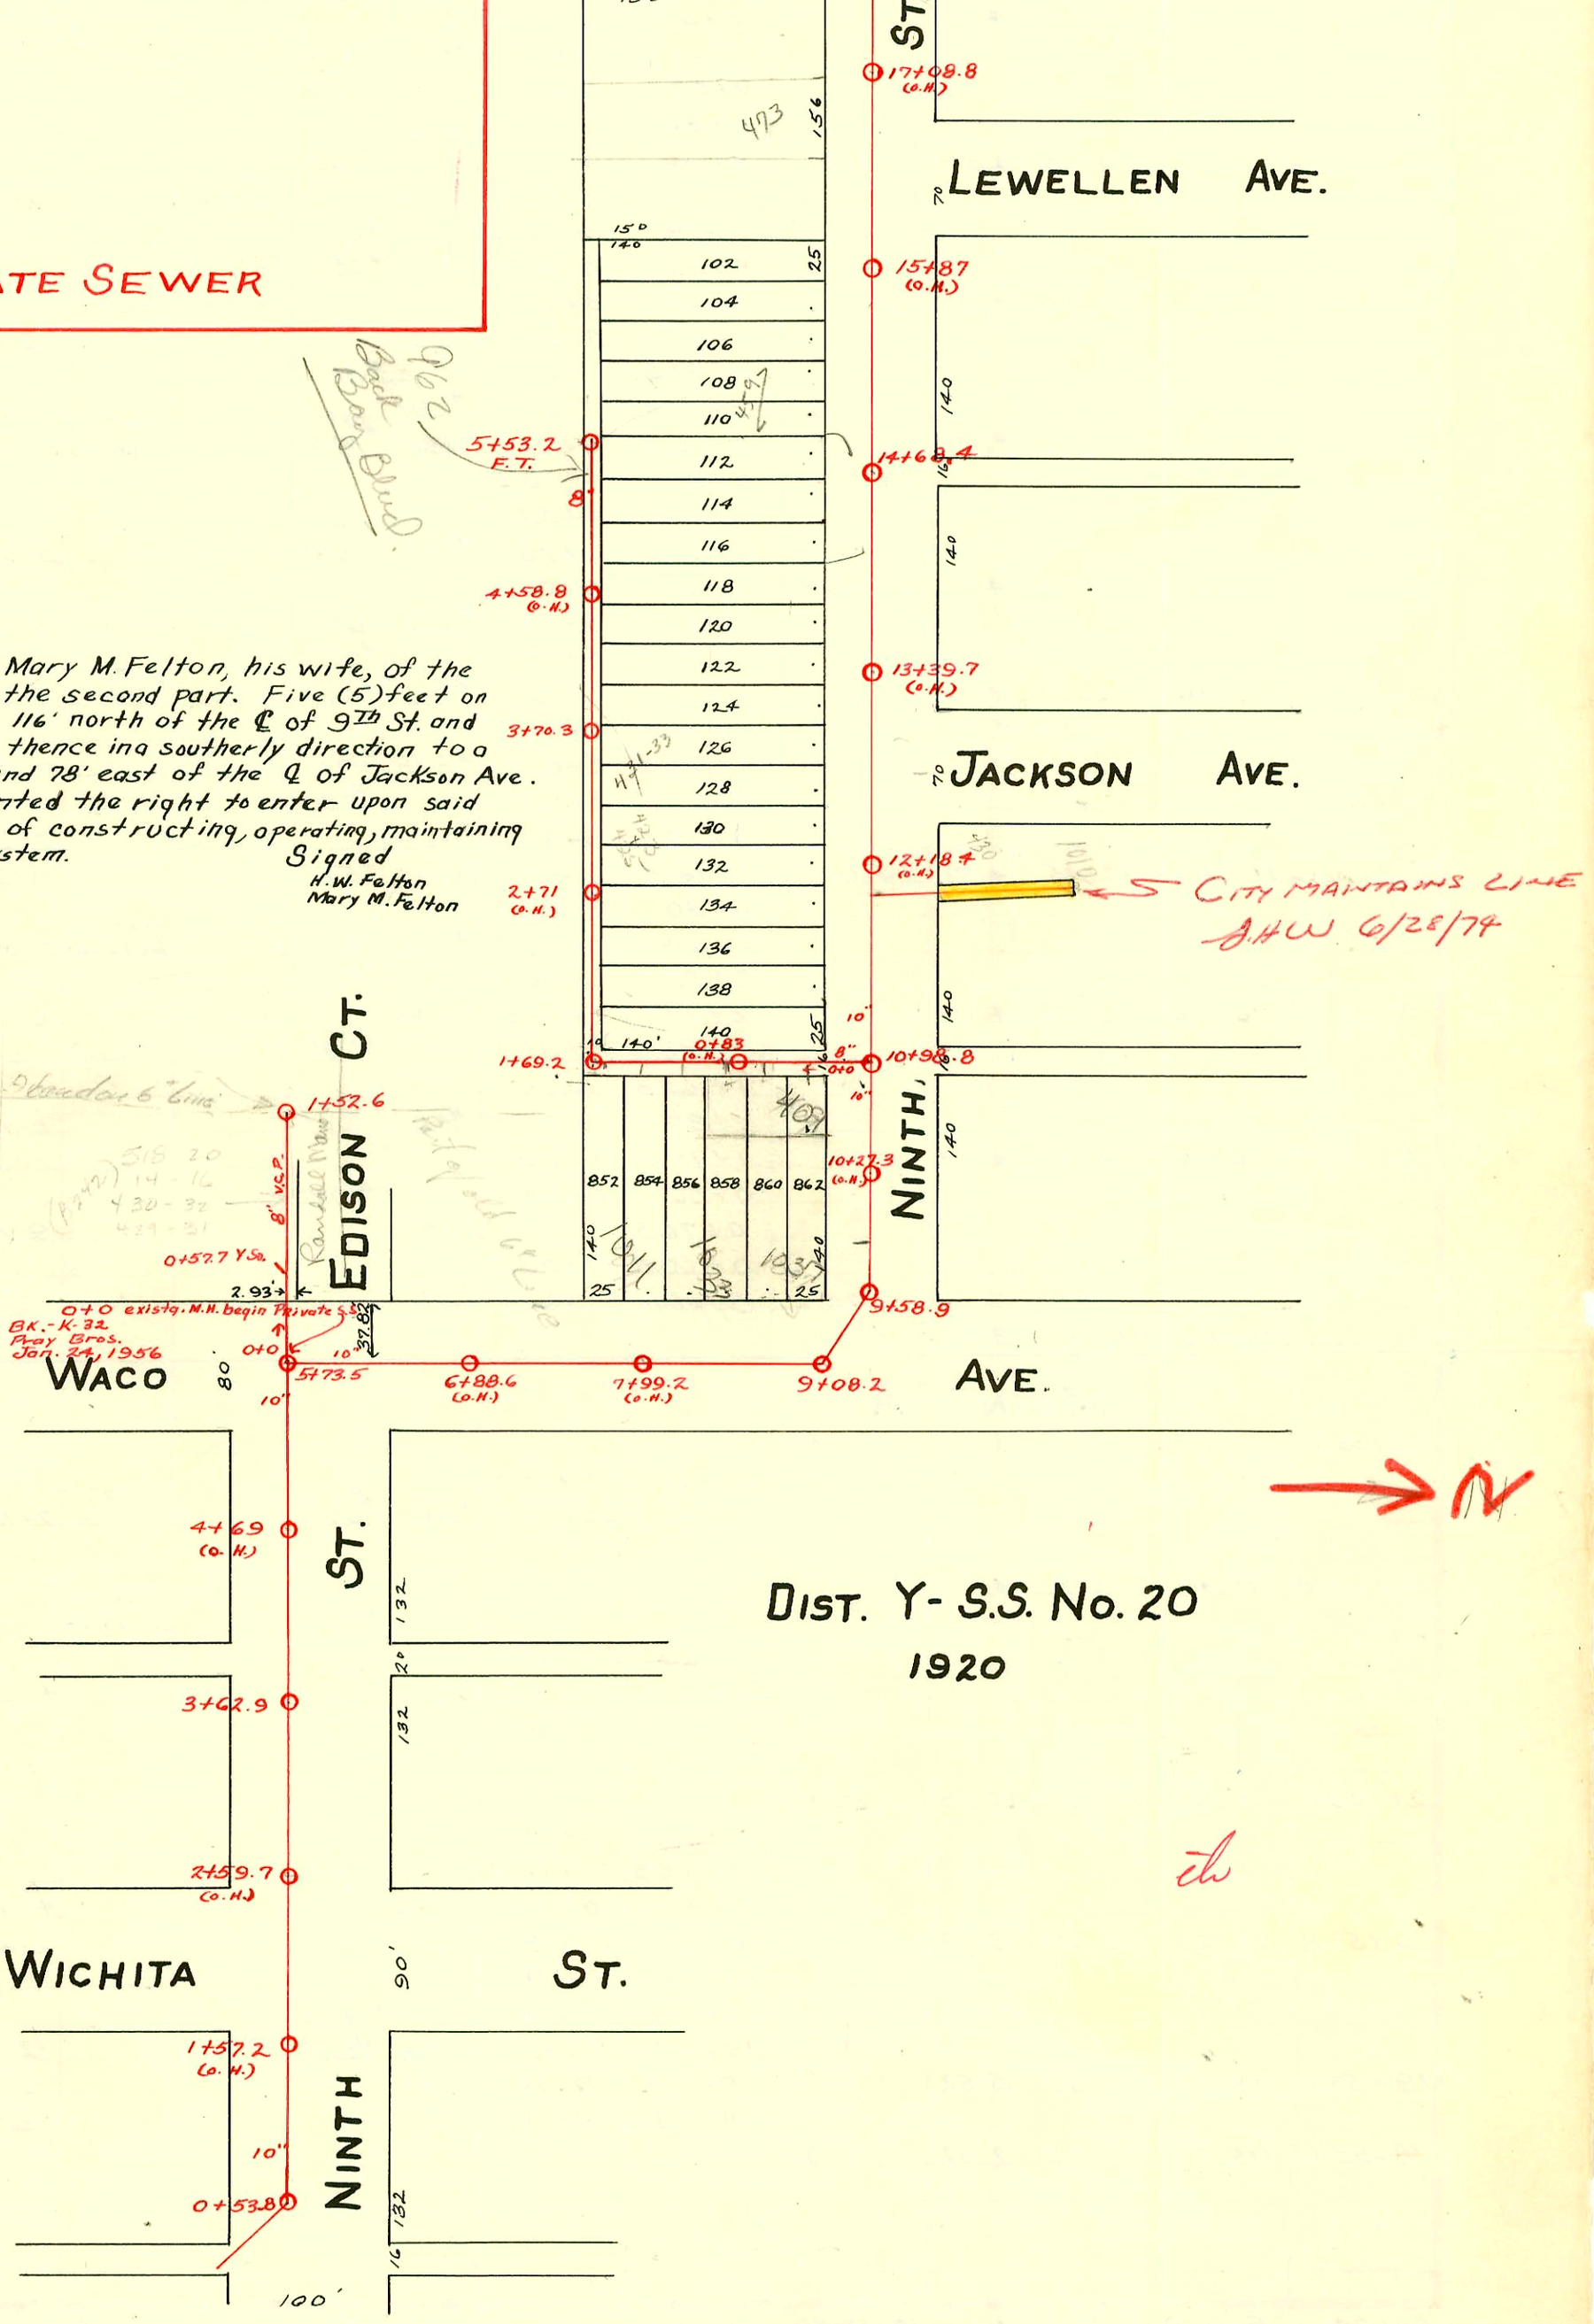

Easement dated Nov. 30, 1921

By and between H. W. Felton and Mary M. Felton, his wife, of the first part and the City of Wichita, of the second part. Five (5) feet on each side of a line beginning at a point 116' north of the ℄ of 9Th St. and 74' east of the ℄ of Jackson Ave.; thence in a southerly direction to a point on the north line of 9Th St. and 78' east of the ℄ of Jackson Ave.

Said second party is here by granted the right to enter upon said premises at any time for the purpose of constructing, operating, maintaining and repairing such sewer and sewer system.

Signed
H. W. Felton
Mary M. Felton

DIST. Y- S.S. No. 20
1920

81

Form 41-(54) 6-56

	CONSTRUCTION RECORD						SERVICE RECORD					
	STATION	ELEVATION		Depth	MANHOLE	4-INCH "Y" BRANCHES		No. of Permit		House Number		DATE OF PERMITS	
		Ground	Grade			North West	South East	North West	South East	North West	South East	North West	South East
Lat. #1					5+53.2 FT.								
						5+33.5	5+39.3 Tap	#78	6058	439 W. 9th	962 Beck Bay	2-15-57	6-25-82
						5+18		#1016				7-12-23	
	5	117.07	112.36	4.71									
						4+92							
						4+66.5							
						4+41		#137				11-13-19	
						4+15.5		#438		429 W. 9th		4-30-30	
	4	117.27	112.26	5.01									
						3+90							
					3+70.3								
						3+39.5		#269		427 W 9th		5-10-09	
	3	117.17	112.16	5.01		3+14.5							
						2+98.2 Tap							
						2+89		#1428 #600		423 W 9th		10-6-80 7-1-11	
						2+63		#477				10-17-12	
						2+37.5							
						2+12							
	2	117.07	112.06	5.01									
					1+69.2								
							1+59.5						
							1+39						
	1	117.37	111.96	5.41		1+03.5	4" Sch 40 PVC 1+13.5	#268	95 28287 95 28226 #435	419 W. 9th	1033 N.C. WACO 10 37510 WACO 413 W. 9th	5-10-09	3-3-95 3-3-95
							0+88						6-25-17
							0+62.5		#402				9-28-16
							0+37.5						
	0	117.27	111.86	5.41	0+0 = M.H. 10+98.8 on Main "H"								
Main "A"	18+53.8	115.37	112.45	2.92	18+33.5								
							17+67		#650				6-12-22
	17+53.8	115.51	112.35	3.16			17+20.5		#576		509 W. 9th		12-4-12
							16+73						
	16+53.8	115.41	112.25	3.16			16+25		#363		535 W. 9th		4-20-22
							15+82.5		#2539		603 W. 9th (473)		8-1-40
	15+53.8	116.31	112.15	4.16									
					14+68.4		14+92						
	14+53.8	116.07	112.05	4.02									
	13+53.8	116.02	111.95	4.07									
	12+53.8	116.82	111.85	4.97									
	11+53.8	117.12	111.75	5.37									
					10+98.8								
	10+53.8	117.55	111.65	5.90									
					9+58.9		9+90.4 4" Se		1928		1037 N. WACO		11-21-80
	9+53.8	118.80	111.55	7.25	9+08.2								
	8+53.8	118.46	111.45	7.01									
	7+53.8	118.41	111.35	7.06									
	6+53.8	118.61	111.25	7.36									
	5+53.8	116.68	111.15	5.53	5+73.5								
	4+53.8	117.38	111.05	6.33									
	3+53.8	116.88	110.95	5.93	3+62.9								
	2+53.8	117.14	110.85	6.29									
	1+53.8	117.14	110.75	6.39									
	0+53.8	116.59	110.65	5.94	0+53.8								
	0		109.80		0+0								
Private S.S. So. of Edison Ct.	0	96.20	92.20	4.0	0+0								
							0+57.7 S.		#7275		933 No. WACO		1-24-56
	1	96.3	92.60	3.7									
		95.7	92.82	2.9	1+52.6								
Hudson Private Sewer.	0+0	115.83	110.13	5.70	0+0 - M.H. 135' W. ℄ Jefferson & 4' N. of ℄ of 9th								
							0+59 Y-S.W.						
							1+02.5 Y-S.W.						
							1+61.7 Y-S.W.						
		117.09	110.33	6.76	1+98 - M.H. 22' W. of E.L. Jefferson & 95' S. of S.L. 9th								
							2+26 Y-S.W.						
							2+96.5 Y-S.W.						
		116.38	110.44	5.94	3+02.8 - M.H. 74' E. of E.L. Jefferson & 138' So. of S.L. 9th								

95-94367 6-26-95 473 W 9th - McClungs - Install 4" C.O. Repl 5' of Line 4" Sch 40 Repl

#1062 - Tap - into M.H. - 8-23-22 619 W. 9th
#10 - Tap - 1-4-22 1002 Lewallen
#3184 - Tap - 711 W. 9th - 3-17-41 - Simmons Plbg. Co.

95-28277 3-3-95 1033 N Waco - Unlicensed D.L. illegally tapped MH sta 1+69.2 trying to replace Bldg Sewer. This situation corrected by Nelson Plbg 3-3-95 and MH tap sealed off. Refer to above noted permits.