


SKINNER		ST.	
AVE.	146	145	AVE.
	148	147	
	150	149	
	152	151	
	154	153	
	156	155	
	158	157	
	160	159	
	162	161	
	164	163	
	166	165	
	168	167	
	170	169	
	172	171	
	174	173	
WASHINGTON	176	175	IDA
	178	177	
	180	179	
	182	181	
	184	183	
	186	185	
	188	187	
	190	189	
	192	191	
	150	140	

Page 109

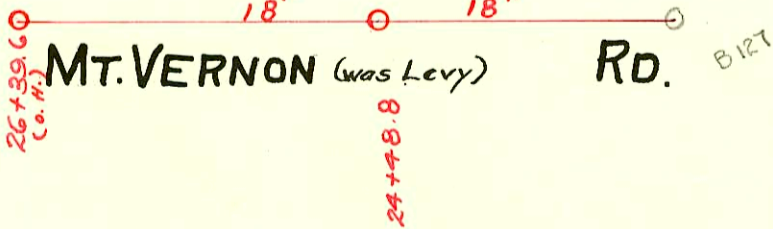

26+39.60
(Co. H)

24+48.8

B121

