


TRAP AREA

DOUGLAS AVE.

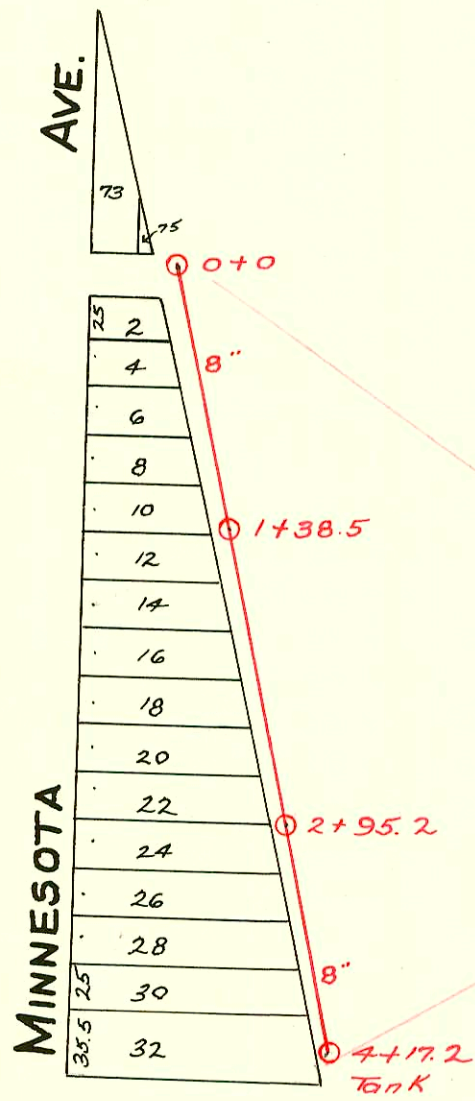

Abandoned
1-35-W

CONSTRUCTION RECORD

SERVICE RECORD

Line along West Line of Canal from alley South of Douglas to English.

STATION	ELEVATION		Depth	MANHOLE	4-INCH "Y" BRANCHES		No. of Permit		House Number		DATE OF PERMITS	
	Ground	Grade			North West	South East	North West	South East	North West	South East	North West	South East
0	106.40	102.12	4.28	0+0								
					0+11							
					0+31.5							
					0+56							
					0+81.5							
1	107.32	102.31	5.01		1+06.5							
					1+31							
					1+53.5		#326				4-15-22	
					1+79.5		#247				12-14-21	
2	106.97	102.51	4.46		2+05		#1248				12-14-21	
					2+34.5							
					2+63		#48				1-24-22	
					2+85.5							
3	107.64	102.71	4.93		3+00.5							
					3+28		#396				4-25-22	
					3+51							
					3+76		#272				6-30-16	
4	107.61	102.91	4.70		4+01							
	107.46	102.95	4.51	4+17.2	TOPK							