B-167 A

KELLOGG - K-42 TO SYCAMORE
(SANITARY SEWER CHANGES)
PROJ. NO. 700500
BUILT BY WILDCAT CONST. CO.
BOOKED 2-12-96 AS PER PLAN

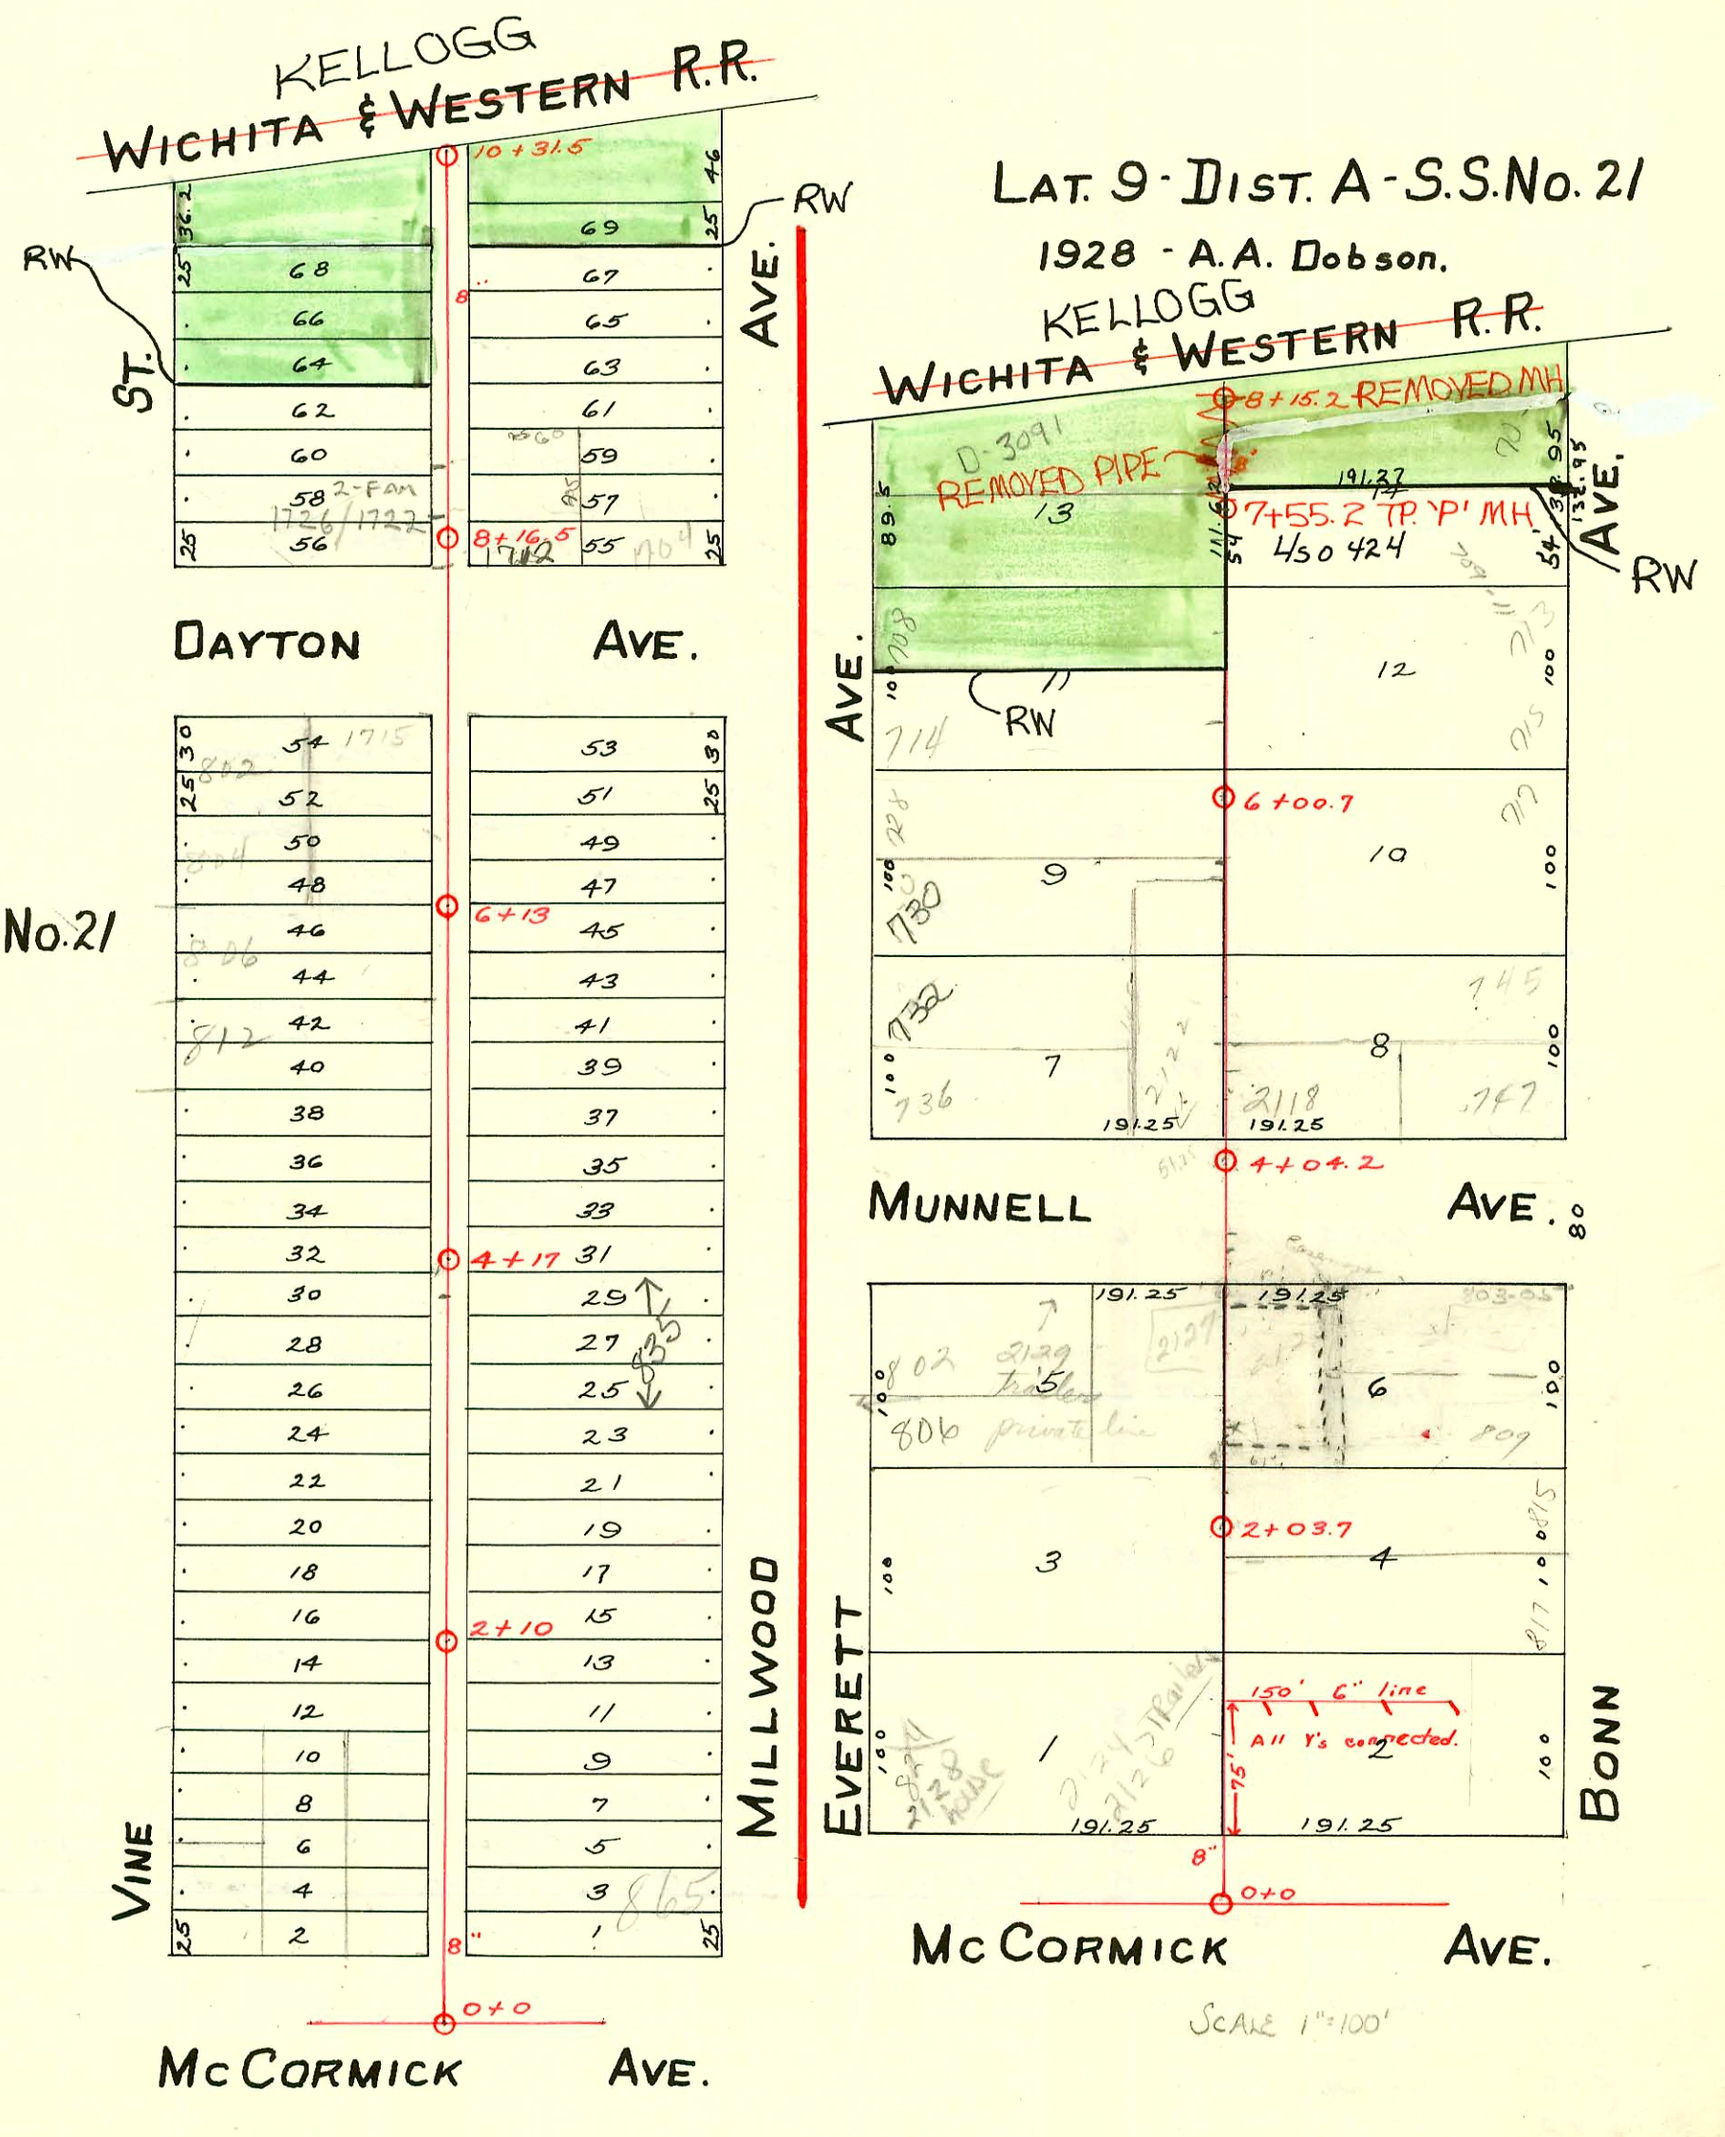

#10339 tap 2118 Munnell Larry Kelly 5-12-59 4+49.7
#12135 tap 2127 Munnell-Lininger Plbg 1-4-60 (2+91.2)

2000-02241- 10/13/00- 745 Bonn- Buck's Backhoe- 4" SCH40- Replace all but lower 1' - 1-1WAY CO, 1TWIN CO, 3H22, NO alley
2001-00602- 3/20/01- 817 Bonn- Wichita Exc- 4" SCH40 - 4" wye 33.7' S of MH 2+03.7 (1+70) Replaced entire line-
1TWIN CO, 1U22, No alley cut.

2002-00690 3/13/02 714 S Everett- Bucks Backhoe - wye Repair 38.5' N of MH 6+00.7 (6+39.2) CO @ 100' 2TWIN CO 1U45
2003-02514- 9/29/03 732 S Everett- Perrys Swr Svc- 4" 40 PVC - Replace upper 20' including + Win co
2003-03115- 12/1/03- 730 S. Everett- Mies Const- 4" 40 PVC - 4" wye repaired- 4' S of NPL (37' S of MH 6+00.7 [5+65.7])
Replaced entire line, 1/4" fall, Shallow, 4" twin co @ house, 4" 1-way co at 90' out, 1H45, 1H22

Form 41-(54) 6-57

CONSTRUCTION RECORD / SERVICE RECORD

	STATION	ELEVATION Ground	ELEVATION Grade	Depth	MANHOLE	4-INCH "Y" BRANCHES North West	4-INCH "Y" BRANCHES South East	No. of Permit North West	No. of Permit South East	House Number North West	House Number South East	DATE OF PERMITS North West	DATE OF PERMITS South East
Bet. Millwood & Vine, McCormick No.	0+0	107.10	103.0	4.1	0+0	0+45	0+47.5		12905 #59		865 S. Millwood		1-8-85 1-29-26
						0+69.5	0+72	#343	12906	1718 McCormick	865 Millwood	4-6-25	1-8-85
						0+94.7	0+97.2	#344	#1327	1720 McCormick	861 S. Millwood	4-7-25	12-10-25
	1+0	106.95	103.1	3.85		1+20.2	1+22.7						
						1+45.5	1+48						
						1+70.7	1+73.2						
						1+96	1+98.5	#141	#397	856 S. Vine	853 S. Millwood	3-7-27	7-14-31
	2+0	107.12	103.2	3.92	2+10	2+21.2	2+23.7						
						2+46.5	2+49	#1347	#22	846 S. Vine	851 S. Millwood	9-23-29	1-12-26
						2+72	2+74.5		#1492		857 S. Millwood		7-7-06 10-18-29
						2+96.7	2+99.2	#656		842 S. Vine		8-4-27	
	3+0	107.25	103.3	3.95		3+22.8	3+25.3		#1582		849 S. Millwood		11-4-29
						3+48	3+50.5	#508	#554	840 S. Vine	835 S. R Millwood	5-7-29	9-12-03 6-30-27
						3+72.8	3+75.3						
						3+98.2	4+00.7	#1679		834 S. Vine		11-29-29	
	4+0	107.44	103.4	4.04	4+17	4+24.6	4+27.1	#1603	#88	828 S. Vine	827 S. Millwood	2-10-48	2-8-26
						4+49.5	4+52						
						4+75.5	4+78	#982		828 S. Vine		10-30-30	
	5+0	107.39	103.5	3.89		5+00	5+02.5		#1298		819 S. Millwood		12-3-25
						5+26	5+28.5	#C1450		812 S. Vine		1-4-67	
						5+55.6	5+58.1		#1297		817 S. Millwood		12-3-25
						5+76.7	5+79.2		#1305		815 S. Millwood		12-7-25
	6+0	107.40	103.6	3.8	6+13	6+02	6+04.5	#198		806 S. Vine		3-23-27	
						6+27.4	6+29.9		#1337		803 S. Millwood		12-14-25
						6+53	6+55.5	#976		1721 Dayton		11-9-27	
						6+78	6+80.5		#1296		801 S. Millwood		12-3-25
	7+0	107.33	103.7	3.63		7+03.5	7+06						
	8+0	107.88	103.8	4.08		~~8+02~~ 8+06.5	8+04.5	51467 #74		~~718 S.~~ 1728 Vine		9-23-25 2-16-31	
					8+16.5	8+27.6	8+30.1		#1007	1722-26 Dayton	1712 Dayton	6-8-44	10-27-47
						8+55.3	8+57.8	#1977	#1008	716 S. Vine	719 S. Millwood	2-21-49	10-27-47
						8+80.5	8+83						
	9+0	108.21	103.9	4.31		9+05.5	9+08	#2116	#949	712 S. Vine	715 S. Millwood	3-7-49	11-3-27
						9+31	9+33.5		#1962		717 S. Millwood		3-30-45
						9+56.3	9+58.8						
	10+0	108.33	104.0	4.33		9+82	9+84.5	#75		702 S. Vine		2-7-27	
	10+31.5	107.70	104.03	3.67	10+31.5	10+07.4	10+09.9		#685		701 S. Millwood		6-11-29
Bet. Bonn & Everett McCormick No.	0+0	107.89	104.0	3.89	0+0	0+93.5	0+91	#1367		824 S. Everett		9-25-29	
						1+22	1+19.5						
						1+46.5	1+44	#5063		2120 McCormick		6-21-51	
	1+0	109.21	104.10	5.11		1+72.5	1+70		#368		817 S. R Bonn	see next pg	3-20-01 6-24-31
						1+97.5	1+95	#49	#5161	814 Everett	815 Bonn R	5-22-48	10-30-81 7-7-51
	2+0	109.32	104.20	5.12	2+03.7								
						2+37.2	2+34.7						
						2+62.4	2+59.9		#908		809 Bonn		9-13-48
	3+0	109.32	104.30	5.02		2+88.6	2+86.1		#2512		2123 Munnell		7-22-40
						3+14.4	3+11.9	#1608		802 Everett		4-28-42	
						3+39.9	3+37.4						
	4+0	109.52	104.40	5.12	4+04.2	4+32.5	4+30	#1330	#1676	736 Everett	747 Bonn	12-23-47	12-9-48
						4+58.2	4+55.7	#3004		2122 Munnell		1-9-50	5-5-83
						4+84.2	4+81.7	#1048		732 Everett		8-13-29	10-13-00 12-5-77
	5+0	109.72	104.50	5.22		5+10.2	5+07.7		#2203	R-see next pg	725 Bonn	9-29-03	8-4-45
						5+35.4	5+32.9						
						5+61.9	5+59.4	#3003		730 S. Everett	see next pg	1-9-50	12-2-03
						5+87.6	5+85.1	#2215	555	728 S. Everett	717 Bonn	10-26-49	11-6-05 5-23-28
	6+0	110.02	104.60	5.42	6+00.7	6+13.7	6+11.2			714	see next		
						6+39.2	6+36.7	#1713	#1199	722 R Everett	715 Bonn	3-13-02 9-19-49	11-14-28
						6+65.2	6+62.7						
						6+91.0	6+88.5	#1714		708 R Everett		10-25-91 9-19-49	
	7+0	109.22	104.70	4.52		7+16.6	7+14.1		#747		713 Bonn		
						7+42.5	7+40	#1600	C7437	704 S. Everett	709-11 Bonn	7-12-90 11-6-29	7-12-28 9-18-79
No info on new MH SKB 2-12-96					7+55.2	7+68.2	7+65.7						
	8+0	109.23	104.80	4.43		7+94.2	7+91.7	#229	775	702 S. Everett	705 S. Bonn	3-13-28	9-20-79 7-19-28
	8+15.2	109.33	104.82	4.51	8+15.2	8+08.7	8+06.2						

C74884 - 803-05 S. Bonn 10-15-77 Tap (2+67.5)
#228007 C74434 - 705 Bonn 5-29-91 - 9-20-79 (Tap 7+98.7) ✓
C6295 - 2112 McCormick seal off 12-29-67 Town & Country Rlty (see Page 149 for new conn)

#4679 - 6 on 8 wye - Trailer - 865 S. Millwood - 6-7-57 - Smith Plbg. (6 on 8 wye) (0+64)
#2300 - Setting wye - 2128 McCormick - 10-19-54 - C. Frank McCoy
#7345 - Tap - 806 Everett - 1-31-52 - Frederick Plbg. Co. (2+41.4)
Tap - 2118 McCormick - #639 - 6-3-29 - C. Frank McCoy.
Tap - 802 S. Vine - #1447 - 10-10-29 - C. Frank McCoy.
Private line - 804 S. Vine - #1448 - 10-10-29 - C. Frank McCoy.
#1527 - Private line - 2116 McCormick - 10-24-29 - C. Frank McCoy.
Private line - #496 - 2102 McCormick - 5-13-30 - C. Frank McCoy.
Private line - #579 - 858 S. Vine - 6-7-30 - Geo. Sargent.
9012 Trailer 2129 Munnell (802 Everett line) Emergency 1-12-59
#C62339 - 2118 Munnell - R. - no record of conn. (4+49.2)