DIST. A - S.S. No. 15

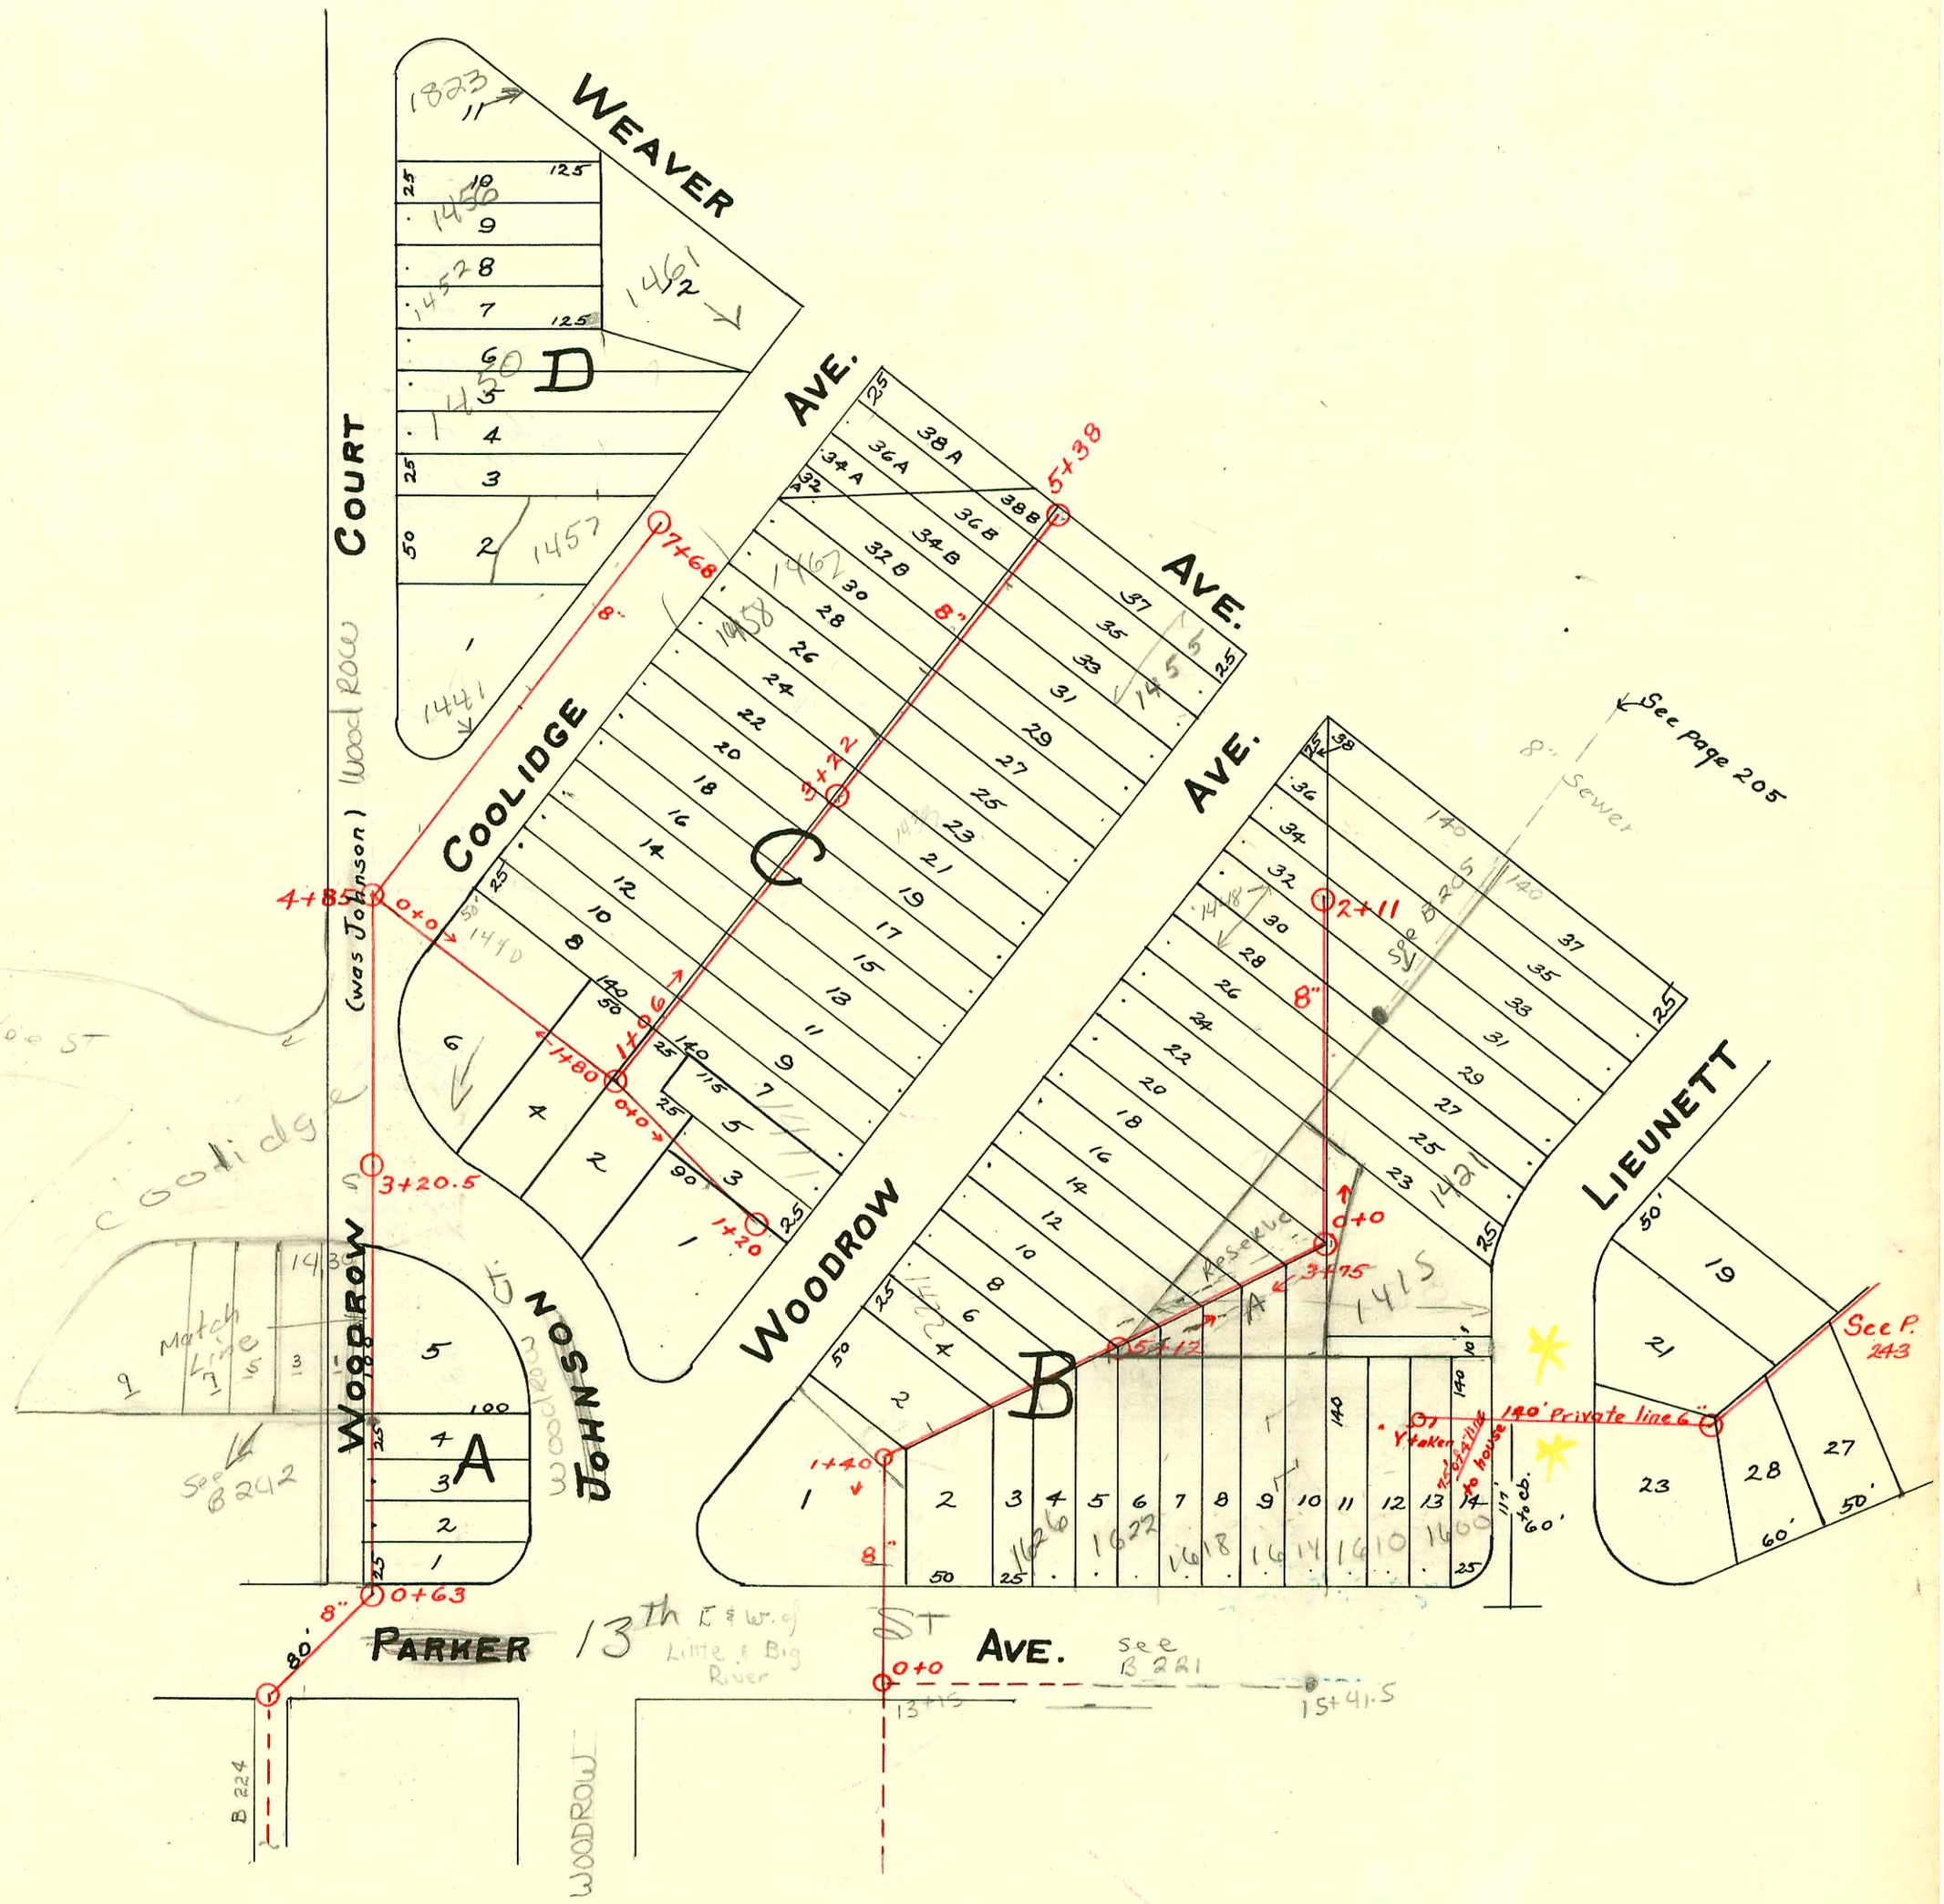

2001-00873-4/12/01 - 1614 W 13th St N- B+L EXC- 4" SCH40- 4" WYE, 2TWINCO, 4H22, 2H45
2001-01949-8/6/01 - 1409 N Woodrow- J-Hawk Plug- 4" SCH40 1TWINCO

2001-02119 8/24/01 1610 W 13th St B+L EXC: 4" SCH40 2H45, 2TWINCO stopped at Fence

241

Form 41-(54) 6-57

	CONSTRUCTION RECORD							SERVICE RECORD					
	STATION	ELEVATION Ground	ELEVATION Grade	Depth	MANHOLE	4-INCH "Y" BRANCHES North West	4-INCH "Y" BRANCHES South East	No. of Permit North West	No. of Permit South East	House Number North West	House Number South East	DATE OF PERMITS North West	DATE OF PERMITS South East
Line west side of Blk. "A"	0+0		116.92		0+63		0+92						
	0+63		117.00				1+16.5						
	1+63		117.10				1+42		#1802				8-6-24
	2+63		117.20				1+67.5						
	3+63		117.30				1+94						
	4+63		117.40		3+20		2+18.5						
Line in West Side of Coolidge	5+63		117.50		4+85	6+09.7							
	6+63		117.60			6+40.7		#1357		1441 Coolidge		12-28-25	
	7+68		117.70			6+73							
					7+68	7+05		#82		1455 Coolidge		2-5-26	
Line thru Lots 4 & 6, Blk. "C"	0+0		117.45		0+0		0+47						
							0+72		#1514		1418 Coolidge		10-22-29
	1+0	126.71	117.55	9.16			0+96		#586		1408 Johnson		5-31-28
							1+25.5						
	1+80	124.88	117.63	7.25	1+80		1+47.5		#322				3-5-23
Line S.E. Thru Lots 1 & 2 - Blk. "C"	0+0	124.88	117.63	7.25	0+0		0+07.5		#218		1404 Johnson		3-16-25
	1+0	124.89	117.73	7.16	1+20		0+33.5						
	1+20	124.82	117.75	7.07		0+86.5	0+84						
Line N.E. Thru Blk. "C"					106' N.E. of cb. on Johnson in line with sewer								
	1+06	124.88	117.75	7.13	1+06	1+31.5	1+29						
						1+57.5	1+55		#175		1415 Woodrow		12-29-32
	2+0	126.03	117.85	8.18		1+84.0	1+81.5	#429		1428 Coolidge		4-25-28	
						2+09.5	2+07		#382				3-16-22
						2+34.5	2+32						
						2+60	2+57.5		#1027		1425 Woodrow		9-17-25
						2+85.5	2+83	#187		1432 Coolidge		3-18-29	
	3+0	125.92	117.95	7.97	3+22	3+11.5	3+09		#414				3-23-23
						3+37.5	3+35	#664		1436 Coolidge		6-7-29	
						3+62.5	3+60	#277	#321	1438 Coolidge		6-4-37	3-5-23
						3+88.5	3+86						
	4+0	126.15	118.05	8.10		4+14.5	4+12	#228	#152	1442 Coolidge	1435 Woodrow	5-15-37	3-5-30
						4+39.5	4+37						
						4+65.5	4+63	#1131	#134	1442 Coolidge		12-23-27	1-25-23
	5+0	124.80	118.15	6.65		4+955	4+93		#319		1455 Woodrow		6-1-31
	5+38	123.85	118.18	5.67	5+38	5+17	5+14.5	#489		1448 Coolidge		9-24-37	
Line up East Side of Blk. "B"	0+0	122.51	117.27	5.24	0+0	0+29							
						0+59							
						0+89		#155		1432 Woodrow		7-18-35	
	1+0	123.0	117.37	5.63		1+19.5		#388				3-20-23	
	2+0	122.80	117.47	5.33		1+50	1+12 Tap		#256		1421 Lieunett		7-3-36
	2+11		117.48		2+11	1+79.5							
Line in E. Side of Lot 1, Blk. "B"	0+0	122.59	116.83	5.76	0+0	0+46							
	0+90	124.51	116.92	7.59		0+72		#540				4-20-23	
	1+40	124.51	116.97	7.54	1+40								
Line N.E. from M.H. in Lot 1, Blk. "B"	0+0	124.51	116.97	7.54	3+75	4+07	4"SC 4+04.5	#1162	#2497		1614 Parker	11-7-24	11-7-24
						4+31.5	4+29						
	1+0	123.61	117.07	6.54		4+57	4+54.5	#165		1428 Woodrow		3-14-29	
						4+82	4+79.5	#34		1438 Woodrow		1-17-27	
					5+12	5+07	5+04.5 New tap 4" NE MH 4" SDR 35		#2445		1618 Parker		10-30-24
						5+32.5	5+30	#467	#2315		1622 Parker	4-3-23	10-15-24
	2+0	122.26	117.17	5.09		5+57.5	5+55						
						5+82.5	5+80						
						6+08.5	6+06						
						6+33	6+30.5						
	3+0	122.51	117.27	5.24									

Station # ruyes do not make sense

Corner 14th & Johnson - West side of street - Special fee - #25.00 #268 - 6-2-24
1502 Woodrow - Tap into M.H. 5+38 - Permit 1278 - 6-12-24
" 2644 - 12-3-24
1420 Woodrow - Tap 5' E. of M.H. "B" 4-25-25
Tap - 1600 Parker - #839 - 10-5-27
Tap - 1447 Coolidge - #679 - 6-26-27 Dunaway
#170 - Tap - 1427 Lieunett - 3-14-29 - Long Plbg. Co.
#427 - 1604 Parker - Geo. Sargent - Private line.
#107 - Tap - 1415 Lieunett - 6-29-32 - Creed - Plummer - Skinnell.
#314 - Tap - 1422 Coolidge - 6-23-37 - L. A. Creed.