

B265

Form 42-020


CONSTRUCTION RECORD

SERVICE RECORD

STATION	ELEVATION		Depth	MANHOLE	4-INCH "Y" BRANCHES		No. of Permit		House Number		DATE OF PERMITS	
	Ground	Grade			North West	South East	North West	South East	North West	South East	North West	South East
COLONIAL PARK III LINE F	0+00	131.3	124.18	7.1	0+00 EXISTING							
	1+00	132.5	124.64	7.9			1+10 S					
	2+00	133.7	125.11	8.6								
	3+00	137.0	125.57	11.4								
		138.9	126.40	12.5	3+15.0							
	4+00	138.7	126.74	12.0								
	5+00	139.6	127.14	12.5			4+65 S					
	6+00	141.6	127.54	14.1			5+15 S					
		142.0	127.90	14.1	6+65.5		5+77 S					
	7+00	142.3	128.04	14.3		7+03 N						
	8+00	144.7	128.44	16.3		7+66 N						
	9+00	145.9	128.83	17.1			8+22 S					
	10+00	146.2	129.24	17.0		8+84 N						
		147.5	129.30	18.2	10+14.5	9+39 N						
LINE E	0+00	138.9	125.74	13.2	0+00=3+15.0 LINE F							
	1+00	138.5	126.14	12.4								
	2+00	137.9	126.54	11.4								
	3+00	137.3	126.93	10.4								
		137.3	127.15	10.2	3+03.7		3+33.7 E					
	4+00	136.5	127.50	9.0			3+94.7 E					
	5+00	135.8	127.86	7.9			4+51.7 E					
		135.5	128.15	7.4	5+11.7 W							
	6+00	135.2	128.34	6.9			5+70.7 E					
	7+00	134.5	128.74	5.8								
	8+00	133.9	129.14	4.8			6+86.7 E					
		133.5	129.35	4.2	8+52.4							
LINE D	0+00	138.9	129.87	9.0	0+00=3+15.0 LINE F							
	1+00	139.2	132.45	6.8								
	2+00	141.1	135.02	6.1								
	3+00	142.8	137.60	5.2								
		142.9	137.90	5.0	3+11.6		3+38 N	3+54 S				
	4+00	144.3	139.16	5.1			3+87 N					
	5+00	145.8	140.46	5.3			4+33 N	4+13 S				
	6+00	147.2	141.77	5.4			4+86 N	4+74 S				
		147.5	142.20	5.3	6+32.8		5+38 N	5+30 S				
	7+00	147.6	142.57	5.0			5+94 N	5+88 S				
	8+00	147.8	142.97	4.8								
	9+00	147.9	143.36	4.5			7+02 N	7+08 S				
		148.0	143.70	4.3	9+84.2		7+99 N	7+56 S				
			143.80	4.2			8+51 N	8+07 S				
							8+61 S					
							9+00 S					

C55274-

94-20371-7 12-21-74 3232 S. Clifton Lot 573 - Redd. Root R. 4" sch 40

 

CONSTRUCTION RECORD

SERVICE RECORD

COLONIAL PARK III (CONT)
LINE D
(CONT)

LINE A

LINE B

CONSTRUCTION RECORD							SERVICE RECORD					
STATION	ELEVATION		Depth	MANHOLE	4-INCH "Y" BRANCHES		No. of Permit		House Number		DATE OF PERMITS	
	Ground	Grade			North West	South East	North West	South East	North West	South East	North West	South East
NIAL PARK III (CONT)												
10+00	148.2	143.87	4.3		10+26 N	10+49 S						
					10+73 N							
11+00	148.9	144.33	4.6		11+23 N	11+62 S						
					11+74 N							
12+00	149.7	144.79	4.9		12+24 N							
						12+80 S						
13+00	150.5	145.24	5.3									
	OUT 145.40	5.3										
	150.7	IN 145.50	5.2	13+34.2	13+84 W							
						13+91 E						
14+00	151.2	146.31	4.9		14+30 W							
					14+97 W							
15+00	152.0	147.55	4.5			15+04 E						
	152.3	148.10	4.2	15+44.7	6" STUB W							
					8" STUB N							
0+00	138.9	129.64	9.3	0+00=3+15.0 LINE F								
1+00	140.0	130.13	9.9									
2+00	140.5	130.61	9.9									
	OUT 130.97	9.0										
	140.0	IN 131.07	8.9	2+74.5								
3+00	139.9	131.17	8.7			3+27 E						
						3+88 E						
4+00	139.4	131.59	7.8									
	OUT 131.90	6.9										
	138.8	IN 132.00	6.8	4+76.5		4+49 E						
5+00	138.7	132.09	6.6			5+10 E						
						5+66 E						
6+00	138.2	132.49	5.7			6+27 E						
	137.6	132.83	4.8									
		132.93	4.7	6+86.2	8" STUB N							
7+00	137.5	133.07	4.4									
8+00	137.4	134.10	3.3		8+15 N	8+44 S						
					8+61 N	8+95 S						
9+00	138.5	135.13	3.4		9+13 N							
	OUT 135.50	4.7				9+43 S						
	140.2	IN 135.60	4.6	9+35.6								
					9+66 N	9+94 S						
10+00	141.5	137.14	4.4		10+12 N	10+42 S						
					10+64 N	10+93 S						
11+00	143.5	139.53	4.0		11+10 N	11+44 S						
	OUT 141.58	3.6			11+62 N							
	145.2	IN 141.68	3.5	11+85.9								
12+00	145.6	141.99	3.6			11+91 S						
					12+14 N	12+43 S						
					12+60 N	12+89 S						
13+00	147.6	144.17	3.4		13+12 N	13+40 S						
					13+58 N	13+92 S						
14+00	149.7	146.36	3.3		14+09 N	14+38 S						
	151.4	148.23	3.2	14+85.8	4" STUB N							
0+00	138.8	132.00	6.8	0+00=4+76.5 LINE A								
1+00	138.3	134.09	4.2		1+32 N							
					1+84 N	1+61 S						
2+00	140.2	136.17	4.0		2+30 N	2+13 S						
	OUT 137.22	4.1				2+59 S						
	141.3	IN 137.32	4.0	2+50.1								
3+00	142.3	138.28	4.0		2+82 N							
					3+29 N	3+11 S						
					3+80 N	3+63 S						
4+00	144.2	140.19	4.0		4+31 N	4+09 S						
					4+78 N	4+60 S						
5+00	146.2	142.12	4.1		5+31 N	5+08 S						
	OUT 142.22	4.0			5+77 N	5+59 S						
	146.2	IN 142.22	4.0	5+00.7	6+28 N	6+05 S						
6+00	148.2	144.39	3.8		6+81 N	6+57 S						
					7+26 N	7+08 S						
7+00	150.1	146.57	3.5		7+76 N	7+55 S						
	151.8	148.50	3.2	7+88.7								

B267

Form 42-020

CONSTRUCTION RECORD

SERVICE RECORD

STATION	ELEVATION		Depth	MANHOLE	4-INCH "Y" BRANCHES		No. of Permit		House Number		DATE OF PERMITS	
	Ground	Grade			North West	South East	North West	South East	North West	South East	North West	South East
COLONIAL PARK III (CONT)												
LINE C 0+00	140.0	134.25	5.8	0+00=2+74.5 LINE A								
1+00	139.5	136.05	3.5		1+32 N	1+50 S						
2+00	141.3	137.85	3.5		1+78 N	1+99 S						
3+00	143.1	139.65	3.5		2+30 N	2+48 S						
	144.0	140.57	3.4	3+50.9	2+81 N	2+99 S						
					3+27 N							
						6" STUB E						
LATERAL 10 MAIN 18 WAR INDUSTRIES SEWER												
LINE A 0+00	163.8	146.02	17.8	0+00 EXISTING	0+41	0+66.6	C60271	C60227	904 Dalton	919 Buckenridge	3-8-77	5-15-78
1+00	162.8	146.50	16.3		1+21	1+99	C60272	C60228	908 Dalton	923 Buckenridge	3-8-77	5-11-78
2+00	163.8	146.98	16.8		1+98	2+40	C60273	C60229	910 Dalton	927 Buckenridge	3-8-77	5-15-78
	164.2	147.22	17.0		2+84.0		C60274		918 Dalton		3-8-77	
		147.32	16.9	2+51.0								
3+00	165.0	147.52	17.5		3+49.6		C60275		919 Dalton		3-8-77	
					4+25.0		C60276		924 Dalton		3-8-77	
4+00	166.2	147.92	18.3		4+72.0	3+61	C60277	C60226	925 Dalton	933 Buckenridge	3-8-77	5-4-78
	166.2	148.27	17.9									
		152.07	14.1	4+89.4	5+64.0		C60278		922 Dalton		3-8-77	
5+00	166.2	152.13	14.1		6+25	6+10.4	C60279	C60234	938 Dalton	963 Buckenridge	3-8-77	5-16-78
6+00	166.8	152.63	14.2		7+06.4		C60262		944 Dalton		3-8-77	
7+00	168.7	153.13	15.6		7+57.4		C60263	C60234	952 Dalton	963 Buckenridge	3-8-77	5-4-78
	168.8	153.53	15.3	7+83.0	8+40.0		C60264		954 Dalton		3-8-77	
		156.55	12.3		8+08.0		C60265		958 Dalton		3-8-77	
8+00	168.8	156.62	12.2		8+70.0	8+71.6	C60266	C60235	959 Dalton	1017 Buckenridge	3-8-77	6-26-79
9+00	168.4	157.02	11.4		10+24		C60267		959 Dalton		3-8-77	
10+00	168.2	157.42	10.8		11+21	4" SCH 40 CITY TAP 9+90.1 Predco	C60268	99-065th	1022 Dalton	1025 Buckenridge	3-8-77	9-2-79
	168.2	157.58	10.6	10+40.0	11+97.0	11+59.0	C60269	13160	1028 Dalton	1029 Buckenridge	3-8-77	3-7-85
12+00	167.9	158.22	9.7		12+96.4	12+39.5	C60270	7866	1034 Dalton	1033 Buckenridge	3-8-77	4-18-83
	168.0	158.60	9.4	12+96.0		4" STUB SE		1143	1035 Dalton	1035 Buckenridge		9-5-80
LINE B 0+00	166.2	148.35	17.9	0+00=4+89.4 LINE A	0+75		C60237		959 Dalton		5-4-78	
1+00	164.7	148.62	16.1		1+12		C60238		937 Dalton		5-4-78	
2+00	161.0	148.87	12.1		2+02.2	1+90.3	C60239	C60232	941 Dalton	953 Buckenridge	4-25-78	5-4-78
	160.2	148.90	11.3	2+14.2		4" STUB SE		C60231	949 Dalton		5-4-78	
LINE C 0+00	168.8	153.65	15.2	0+00=7+83.0 LINE A	0+12		C60235		960 Dalton		5-4-78	
1+00	167.2	154.05	13.2		1+58		C60235		973 Dalton		6-15-78	
