B276 A

ST FRANCIS of ASSISI PARK SANITARY SEWER
BUILT BY: MID STATES CONST. CO.
PROJ. Nº DBKW 705031
BOOKED 11-19-76 FROM DCD46

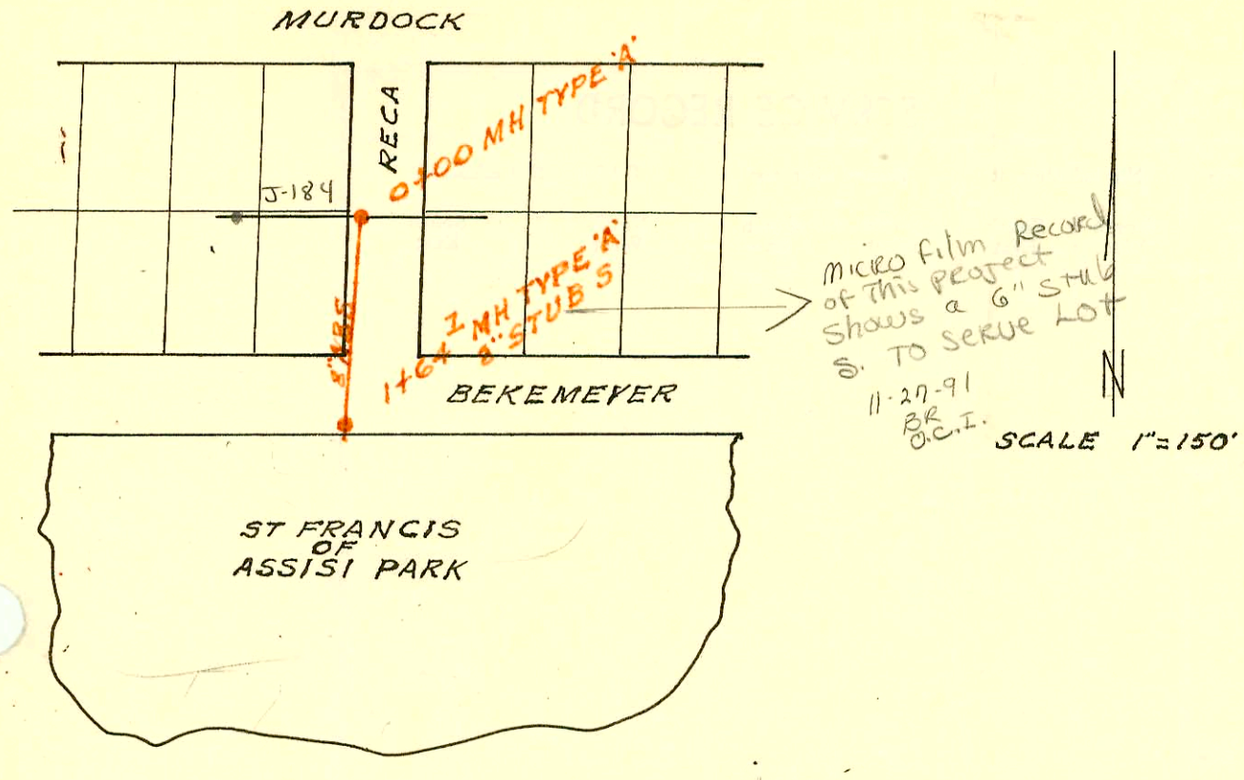

LATERAL 18 SUB 1 SWI
BUILT BY: UTILITY CONT. INC.
PROJ. Nº DBKL570041
BOOKED 11-24-76 FROM IH7

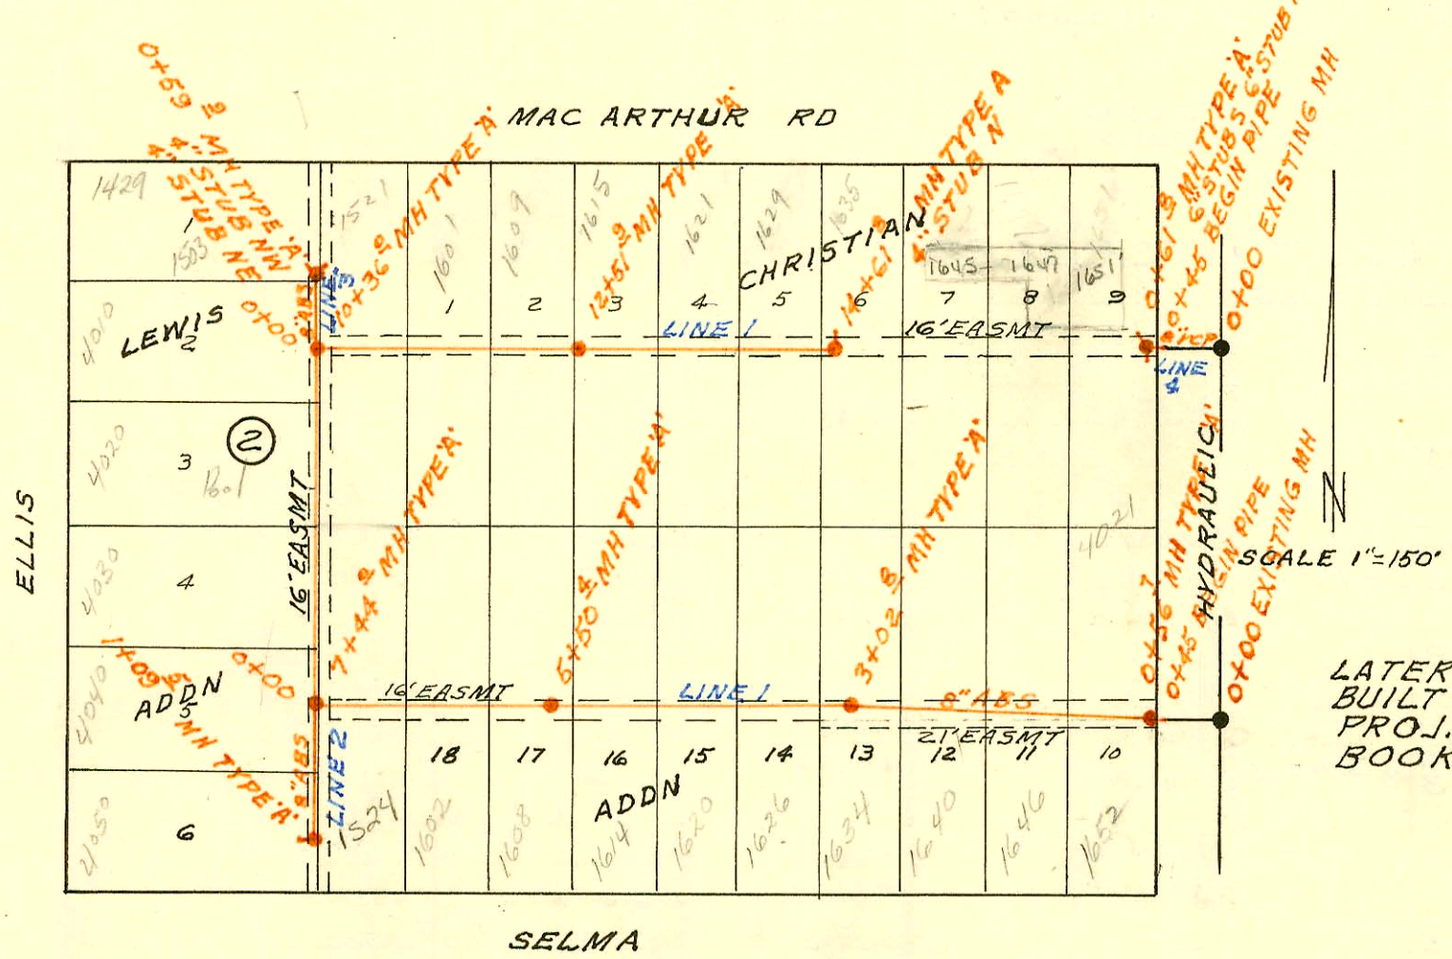

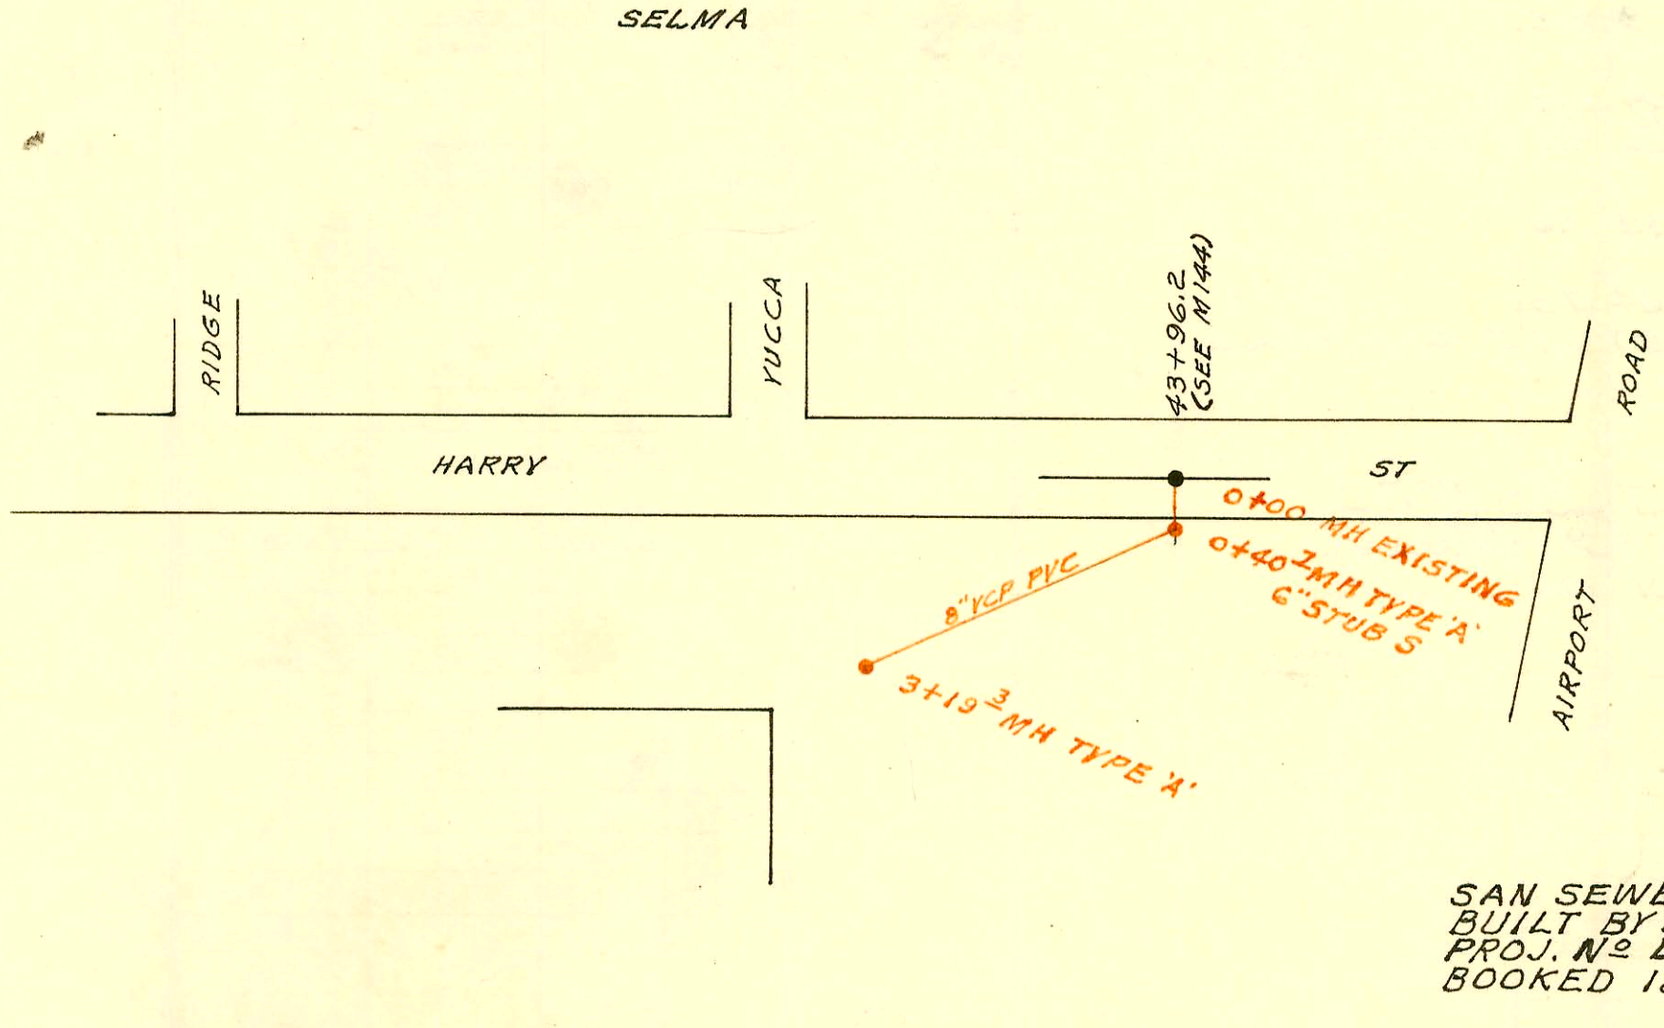

SAN SEWER TO USPS FACILITY
BUILT BY: COONROD & WALZ CONST.
PROJ. Nº DBKW705062
BOOKED 12-10-76 FROM DCD 37

B276

Form 42-020

CONSTRUCTION RECORD

SERVICE RECORD

	STATION	ELEVATION Ground	ELEVATION Grade	Depth	MANHOLE	4-INCH "Y" BRANCHES North West	4-INCH "Y" BRANCHES South East	No. of Permit North West	No. of Permit South East	House Number North West	House Number South East	DATE OF PERMITS North West	DATE OF PERMITS South East
ST FRANCIS of ASSISI PARK SANITARY SEWER													
	0+00	153.3	145.79	7.5	0+00								
	1+00	153.4	146.04	7.4									
		153.5	146.21	7.3	1+64.7		6" 8" STUB S						
LATERAL 18 SUBMAIN 1 SOUTHWEST INTERCEPTOR													
LINE 1	0+00	87.0	74.08	12.9	0+00 EXISTING								
	0+45	86.2	77.20	9.0									
		86.2	77.22	9.0	0+56.7		0+74.3		C59215		1652 Selma		12-21-76
	1+00	86.4	77.31	9.1			Tap 1+50.2		59182		1646 Selma		12-15-76
	2+00	86.6	77.51	9.1			Tap 2+27.8		C72609		1640 Selma 1634		6-27-79
							2+75.8 to		2425		Selma		1-20-81
		85.4	OUT 77.72 IN 77.80	7.7 7.6	3+02.8								
	4+00	85.0	78.01	7.0			Tap 3+684		C63416		1626 Selma		10-7-77
	5+00	86.4	78.21	8.2			Tap 4+20.4		59075		1620 Selma		12-13-76
		85.7	78.31	7.4	5+50.4		Tap 5+00.8		59114		1614 Selma		12-15-76
							Tap 5+58.8		59094		1608 Selma		12-13-76
	6+00	85.1	78.41	6.7			6+42.2 tap 4" Sch 40 to 0+91.0 tap		8080		1602 Selma		5-5-83
									91-38267		1524 Selma		11-26-91
	7+00	86.0	78.61	7.4									
		85.4	OUT 78.70 IN 78.78	6.7 6.6	7+44.0								
	8+00	85.4	78.89	6.5		8+28 tap			16315		4030 Ellis		5-21-86
	9+00	85.5	79.09	6.4		9+21.0 tap			8004		4020 Ellis		5-2-83
	10+00	86.3	79.29	7.0									
		86.7	OUT 79.36 IN 79.46	7.3 7.2	10+36.0	10+28.4			C73872		4010 So Ellis		8-23-79
						10+81 6			C60029		1521 E. MacArthur		2-22-77
	11+00	87.2	79.59	7.6									
						11+43.			C60030		1601 E. MacArthur		2-22-77
	12+00	86.8	79.79	7.0		12+09 3			C60031		1609 E. MacArthur		2-22-77
		86.5	79.89	6.6	12+51.9	12+77.5			C65510		1615 E. MacArthur		3-23-78
						13+43.9			C59015		1621 E. MacArthur		12-9-76
	13+00	86.3	79.99	6.3									
	14+00	85.8	80.19	5.6		14+21			C59736		1629 E. MacArthur		2-4-76
		85.9	80.31	5.6	14+61.8	4" STUB N			C59735		1635 E. MacArthur		2-4-76
LINE 2	0+00	85.4	78.77	6.6	0+00=7+44 LINE 1								
	1+00	85.2	79.17	6.0			0+30		C59441		4040 S. Ellis		1-12-77
		85.2	79.21	6.0	1+09.5	4" STUB W			C59760		4050 S Ellis		2-4-77
LINE 3	0+00	86.7	79.46	7.2	0+00=10+36 LINE 1								
		87.5	80.06	7.4	0+59.9	4" STUB NW	4" STUB NE		C60101		1503 E. MacArthur		2-28-77
LINE 4	0+00	86.2	74.47	11.7	0+00= EXISTING	tied into existing wye?			3946		1645 E McArthur Rd		3-24-95
	0+45	85.2	74.56	10.6		MH Tap MH Tap			FS 3946-7 01311		1647 E. MacArthur & car wash		3-24-95 & 4-22-80
		85.4	OUT 74.59 IN 78.59	10.8 6.8	0+61.8	6" STUB NW	6" STUB S		C64051	C61946	1651 E. MacArthur 4021 S. Wyoming	11-16-77	7-8-77
SS TO USPS FACILITY													
	0+00	130.3	120.90	9.4	0+00 EXISTING								
		130.3	OUT 121.06 IN 121.16	9.2 9.1	0+40.7		6" STUB S		C73900		1601 Airport Rd.		8-24-79
	1+00	131.2	121.40	9.8									
	2+00	132.2	121.80	10.4									
	3+00	132.6	122.20	10.4									
		132.4	122.28	10.1	3+19.3								