


B281A

SCALE 1"=150'

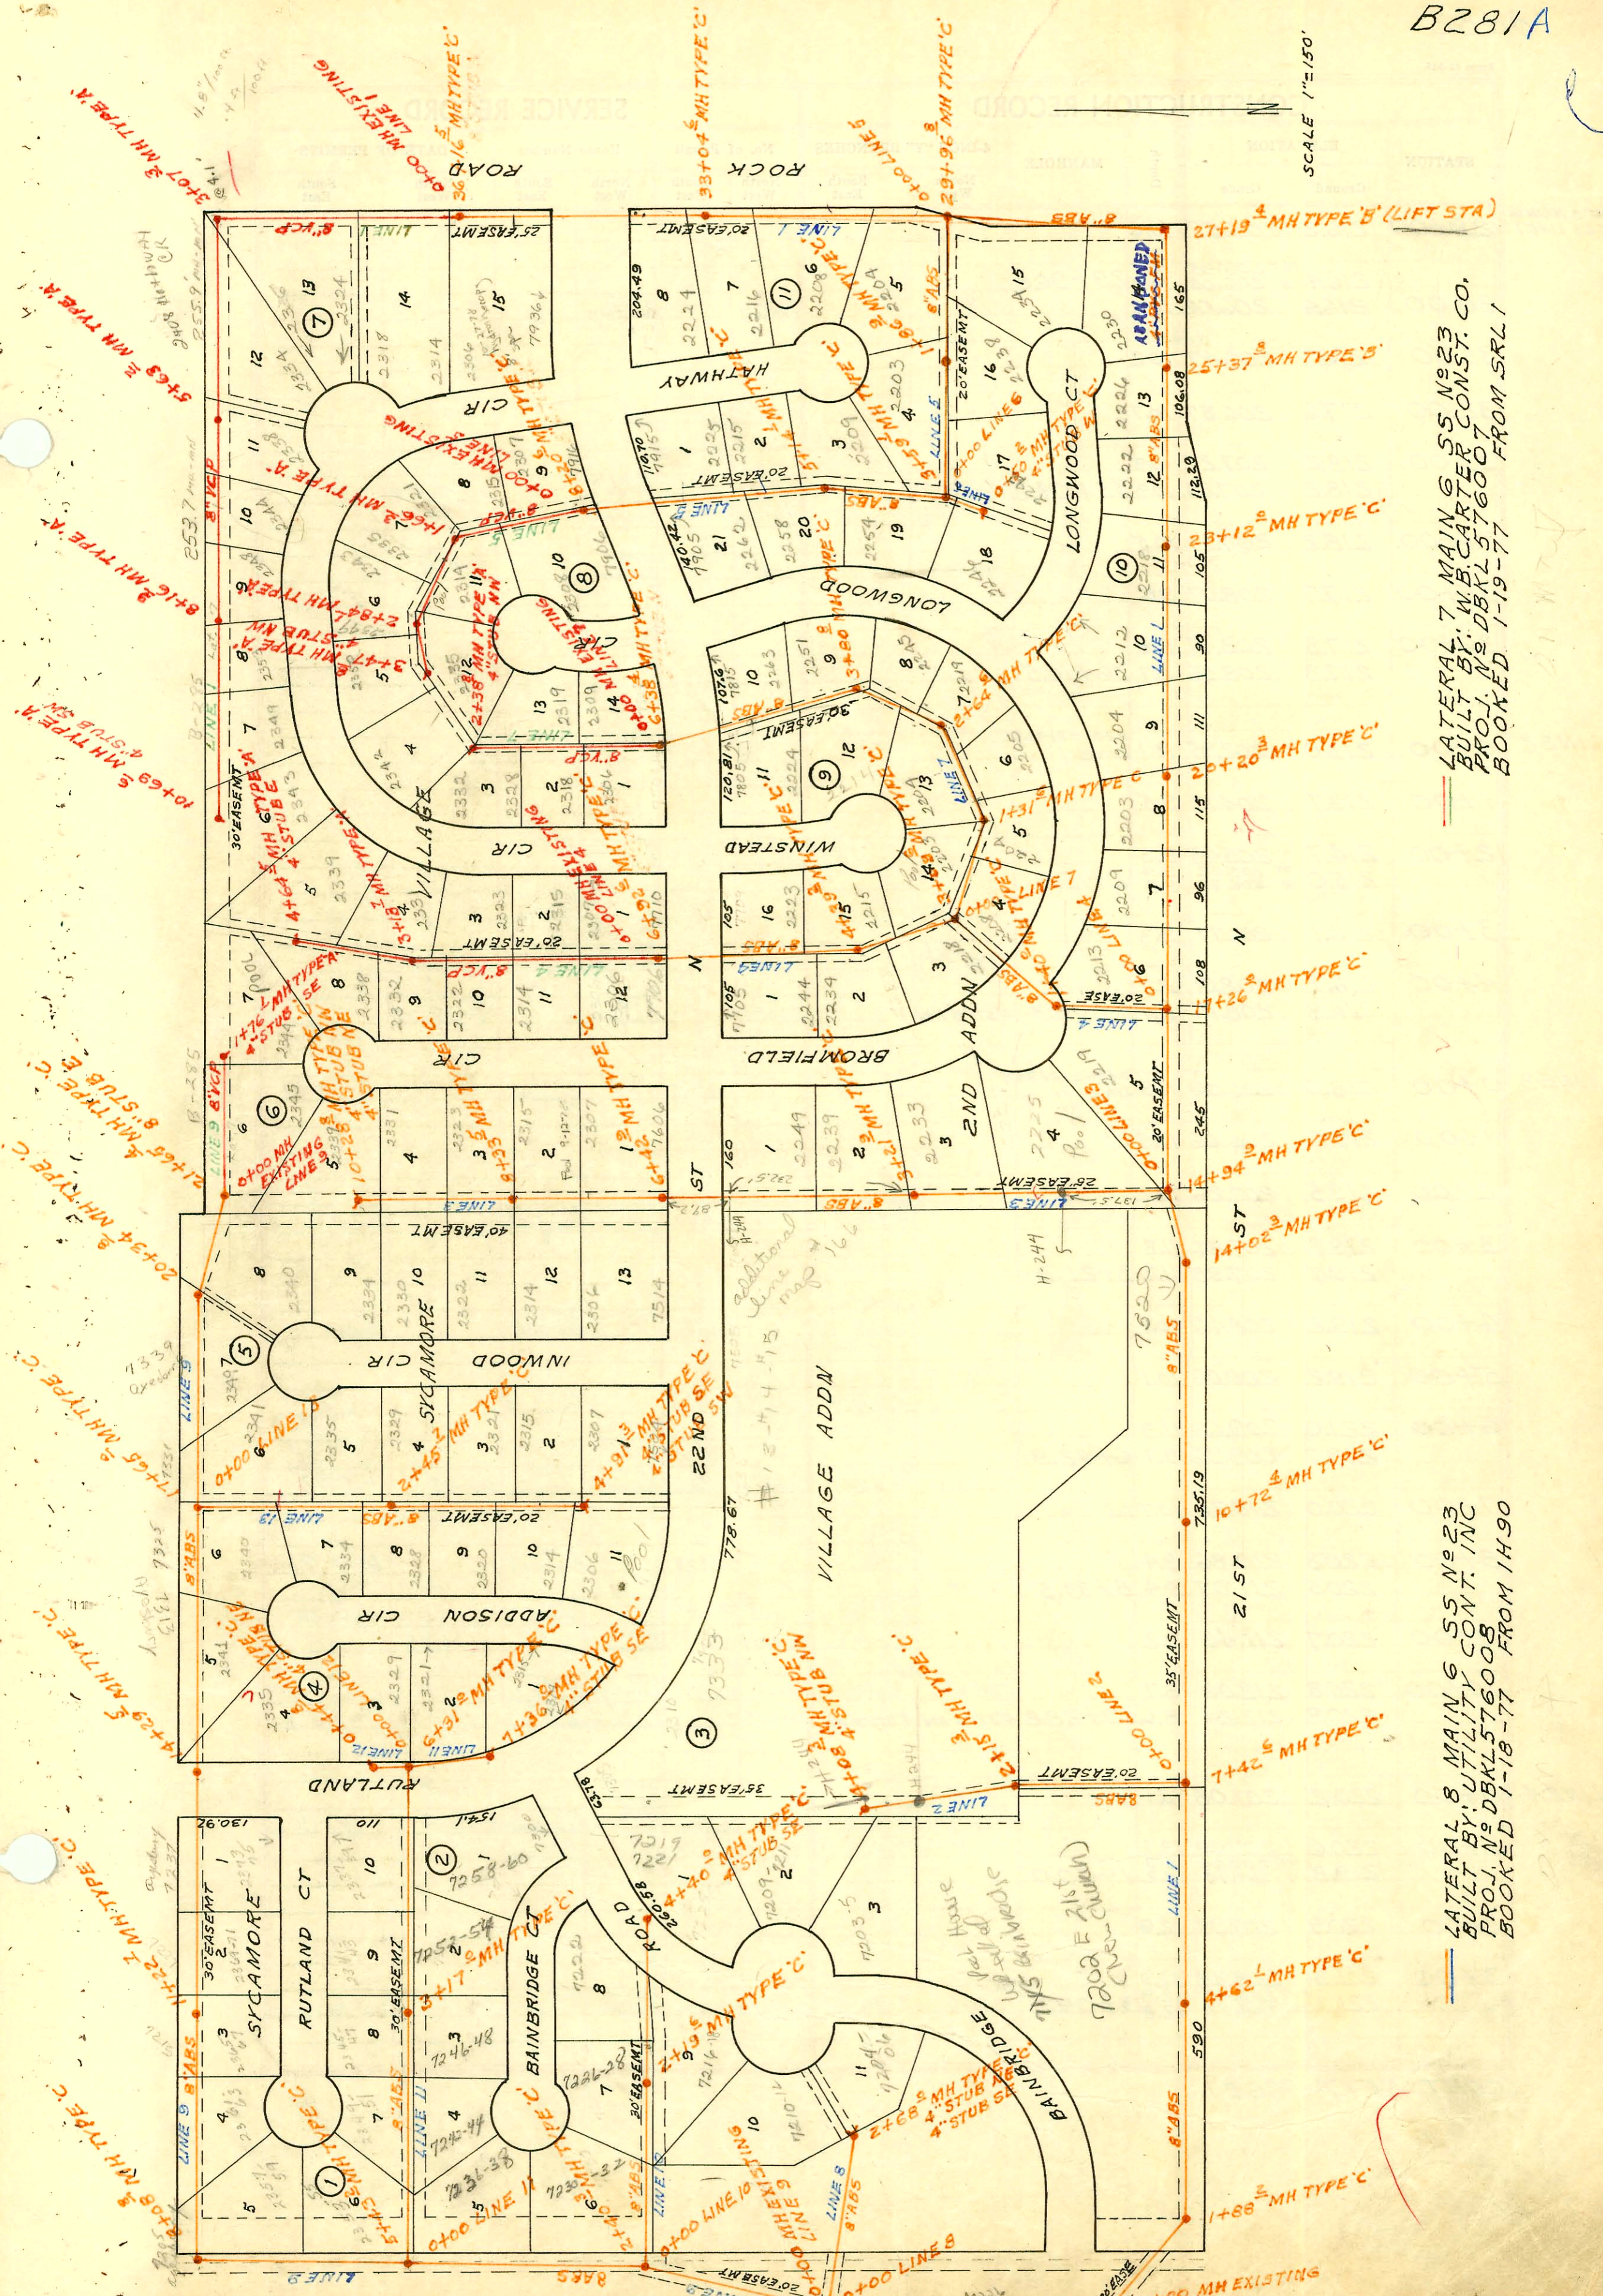

LATERAL 7 MAIN 6 SS N^o23
 BUILT BY: W.B. CARTER CONST. CO.
 PROJ. N^o DBKL576007
 BOOKED 1-19-77 FROM SRL1


LATERAL 8 MAIN 6 SS N^o23
 BUILT BY: UTILITY CONT. INC
 PROJ. N^o DBKL576008
 BOOKED 1-18-77 FROM 1H90

CONSTRUCTION RECORD

SERVICE RECORD

STATION	ELEVATION		Depth	MANHOLE	4-INCH "Y" BRANCHES		No. of Permit		House Number		DATE OF PERMITS	
	Ground	Grade			North West	South East	North West	South East	North West	South East	North West	South East
LATERAL 8 LINE 1 0+00	209.4	199.78	9.6	0+00 EXISTING								
1+00	208.0	200.18	7.8		1+26.6		C71193		2219 Branford		4-11-79	
2+00	208.0 OUT 200.53 IN 200.63	200.68	7.5 7.4	1+88.2								
3+00	209.0	200.68	8.3									
4+00	210.8	201.08	9.7									
5+00	212.1	201.48	10.6									
6+00	212.5 OUT 201.68 IN 201.73	201.88	10.8 10.8	4+62.1								
7+00	213.0	201.88	11.1									
8+00	213.6	202.28	11.3		6+44.0		C57549		7115 Branford		9-3-76	
9+00	213.5	202.68	10.8									
10+00	213.0	202.85	10.2	7+42.6								
11+00	212.8	203.08	9.7									
12+00	212.8	203.48	9.3									
13+00	213.0	203.88	9.1									
14+00	210.2	204.17	6.0	10+72.4								
15+00	214.2	204.28	9.9									
16+00	215.7	204.68	11.0									
17+00	216.8	205.08	11.7									
18+00	213.5	205.48	8.0									
19+00	213.5	205.49	8.0	14+02.3								
20+00	213.5	205.59	7.9									
21+00	218.0 OUT 205.96 IN 206.06	206.08	12.0 11.9	14+94.9								
22+00	218.0	206.08	11.9									
23+00	219.6	206.48	13.1									
24+00	220.1	206.88	13.2									
25+00	220.2	206.98	13.2	17+26.0					2213 Branford		4-26-78	
26+00	220.6	207.28	13.3	18+64.3			C65614 C64722		2220 Branford		11-29-77	
27+00	221.0	207.68	13.3									
28+00	221.6	208.08	13.5		19+83.4		C66455		2223 Branford		5-17-78	
29+00	221.7 OUT 208.16 IN 208.26	208.26	13.5 13.4	20+20.3					2224 Branford		8-15-77	
30+00	221.8	208.58	13.2		21+03.3		C62563					
31+00	221.3	208.98	12.3									
32+00	220.8	209.38	11.4		21+97.3		C64221		3212 Branford		11-29-77	
33+00	220.7	209.42	11.3	23+12.0	22+37.5		C63881		2218 Branford		11-4-77	
34+00	220.2	209.78	10.4		23+78.8		C63882		2228 Branford		11-4-77	
35+00	219.4	210.18	9.2									
36+00	219.0 OUT 210.32 IN 210.65	209.91	8.7 8.4	25+37.8								
37+00	218.0	209.91	8.1									
38+00	216.2	209.26	6.9		24+47.8		C64371		2226 Branford		7-4-78	
39+00	216.5 OUT 209.13 IN 209.84	209.84	7.4 11.7	27+19.4 WET WELL								
40+00	216.0	205.17	10.8		27+47.4		C66460		2230 Branford		6-1-78	

(CONT. NEXT PAGE)

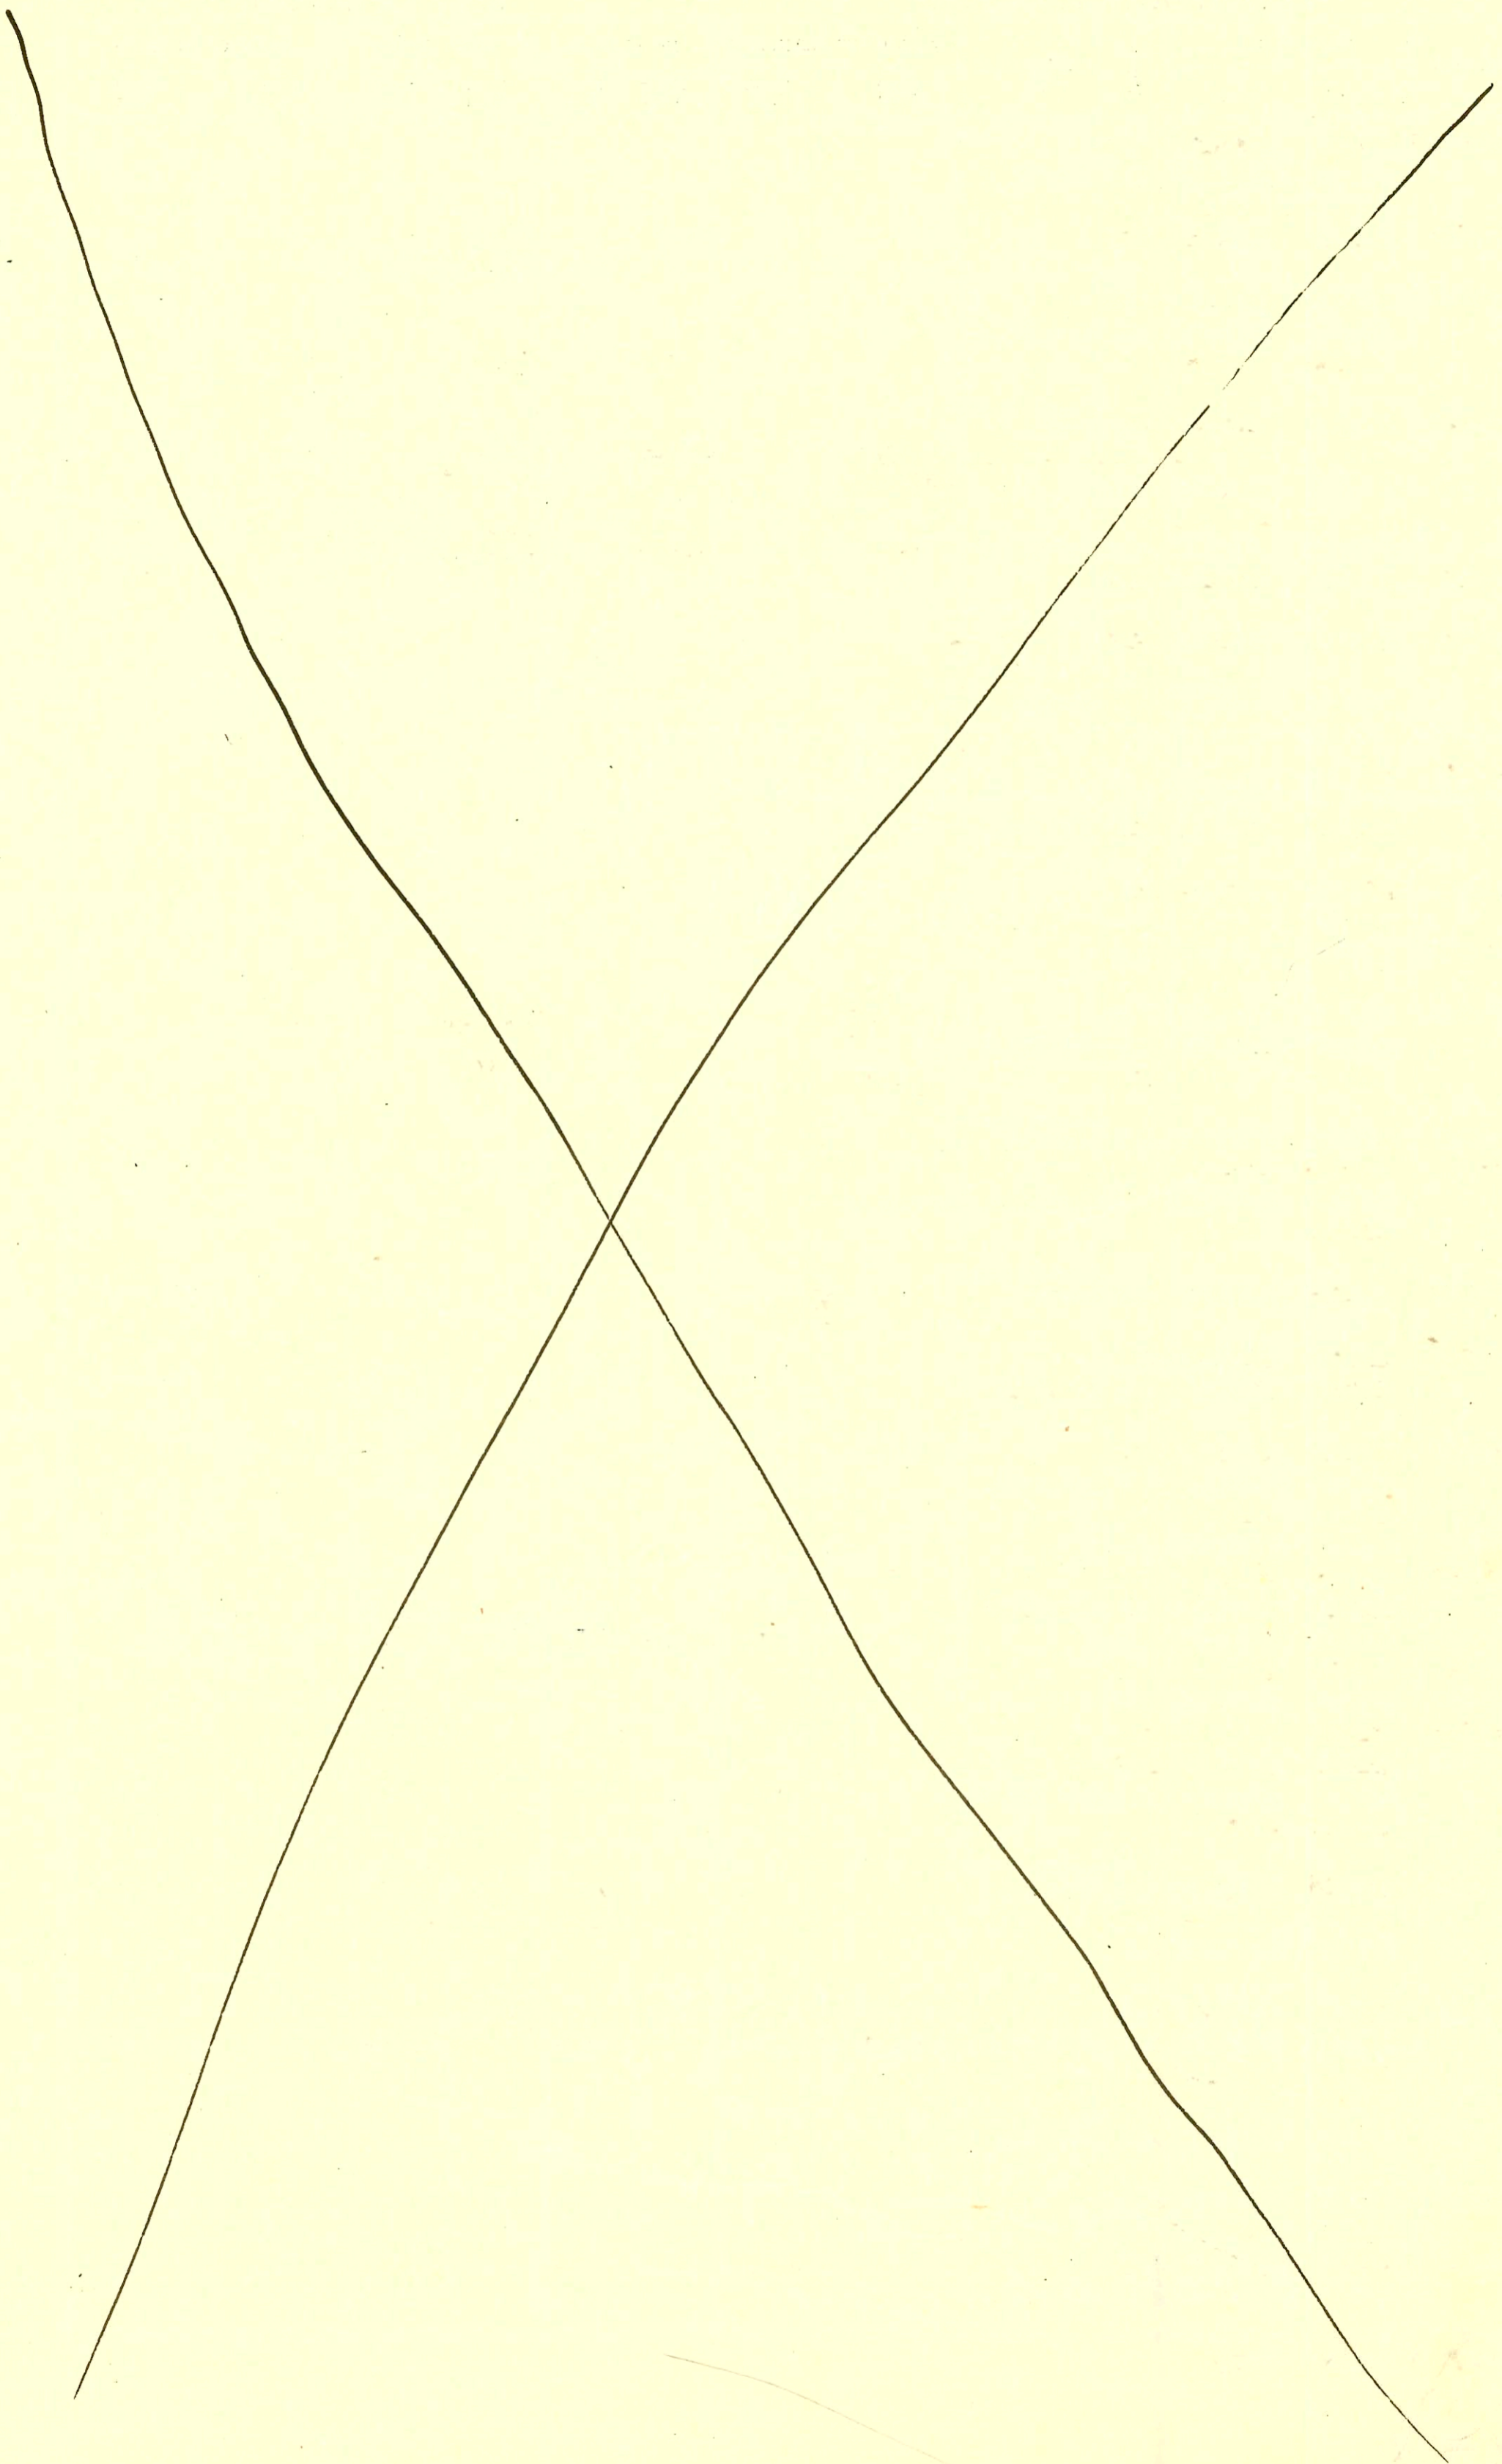


CONSTRUCTION RECORD

SERVICE RECORD

LAT B MAIN G
5523 LINE 1

STATION	ELEVATION		Depth	MANHOLE	4-INCH "Y" BRANCHES		No. of Permit		House Number		DATE OF PERMITS	
	Ground	Grade			North West	South East	North West	South East	North West	South East	North West	South East
29+00	216.2	205.57	10.6									
30.00	216.4	206.06	10.3	29+96.8			C62751		2204 Hathway		8-26-77	
31.00	216.7	206.47	10.2									
32.00	217.6	206.87	10.7		31+93.0		C63160		2208 Hathway		9-21-77	
33.00	218.2	207.27	10.9	33+04.6	33+43.2 33+93.6		C68875 C711583		2216 Hathway 2224 Hathway		10-12-78 1-26-79 5-27-79	
34+00	218.2	207.67	10.5						2506 Hathway		7-14-78	
35+00	217.7	208.07	9.6									
36+00	217.3	208.47	8.8	36+16.5								
LINE 2 0+00	213.0	202.95	10.1	0+00=7+42.6 LINE 1								
1+00	213.7	204.19	9.5									
2+00	214.7	205.43	9.3	2+15.3								
3+00	216.1	206.77	9.3									
4+00	216.7	208.01	8.7	4+08.3	4" STUB NW		C66911		7209-11 Cambridge		6-19-78	
LINE 3 0+00	218.0	206.06	11.9	0+00=14+94.9 LINE 1								
1+00	219.2	206.66	12.5									
2+00	219.5	207.26	12.2									
3+00	219.7	207.86	11.8	3+21.9								
4+00	219.2	208.46	10.7									
5+00	219.2	209.06	10.1									
6+00	221.0	209.66	11.3	6+42.9								
7+00	220.0	210.26	10.7									
8+00	220.3	210.86	9.4	8+33.5								
9+00	220.7	211.46	9.2									
10+00	220.8	212.06	8.7	10+28.8	4" STUB NW	4" STUB NE	C66925	C62381	2306 Newwood Co 2307 Bromfield	2301 Bromfield	4-10-78	9-8-78
LINE 4 0+00	220.2	207.08	13.1	0+00=17+26 LINE 1								
1+00	220.6	207.48	13.1	1+40.0								
2+00	220.9	207.98	12.9									
3+00	221.3	208.38	12.9	3+09.6								

(CONT. NEXT PAGE)

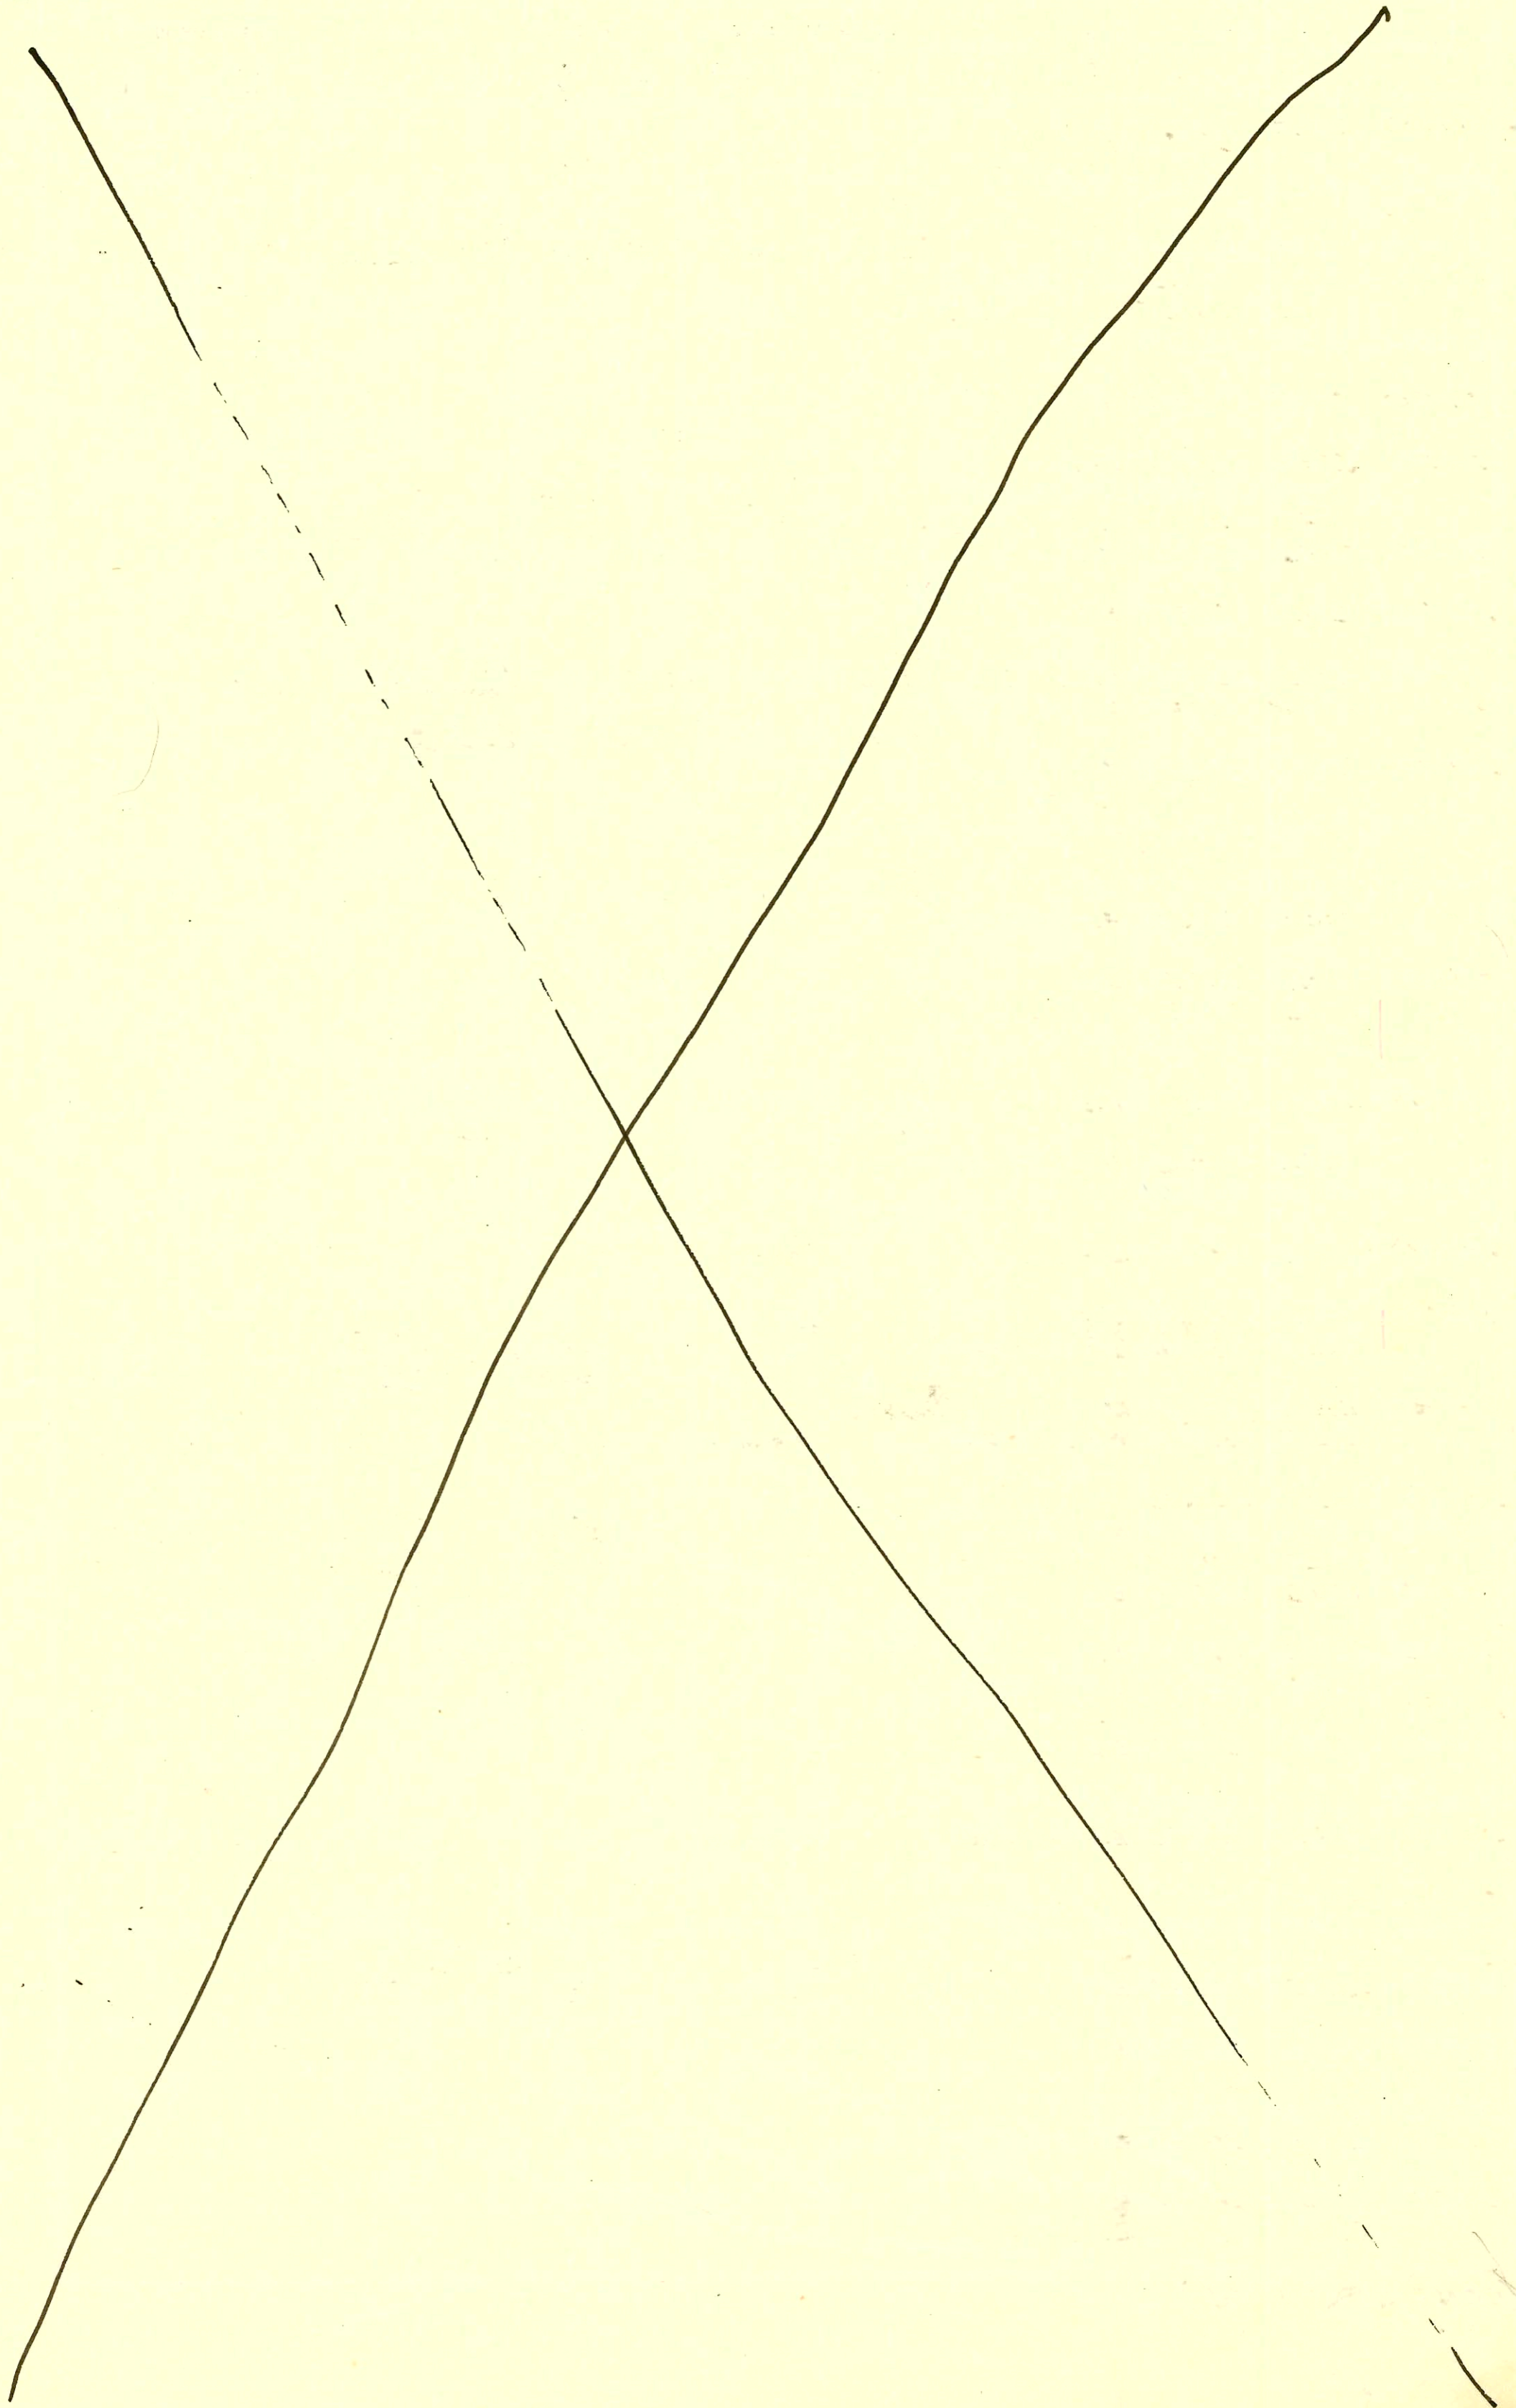


CONSTRUCTION RECORD

SERVICE RECORD

STATION	ELEVATION		Depth	MANHOLE	4-INCH "Y" BRANCHES		No. of Permit		House Number		DATE OF PERMITS			
	Ground	Grade			North West	South East	North West	South East	North West	South East	North West	South East	North West	South East
LATS MARK 5523 LINE 4														
4+00	221.3	209.32	12.0											
	221.8	209.68	12.1	4+39.2	4+49.2			C68166		2215	Winstead Cr.	8-31-78		
5+00	221.5	210.28	11.2					C66510		2234	Brownfield	6-14-78		
				4+61.9	5+71.7			C67369	C71584	2233	Winstead	7-14-78		
6+00	221.6	211.15	10.5											
	221.6	211.98	9.6	6+92.6										
LINE 5														
0+00	216.4	206.05	10.4	0+00=29+96.8 LINE 1										
								C62751		2204	Hathway	10-10-77		
1+00	217.3	206.85	10.5											
				1+13.9										
	218.0	207.55	10.5	1+86.9				C66792		2234	Kongwood Ct	6-13-78		
2+00	218.2	207.65	10.6					C67975		2238	Kongwood Ct	8-22-78		
				2+33.9				C62562		2203	Hathway	8-15-77		
3+00	219.6	208.45	11.2											
				3+59.1				C64548		2242	Kongwood Ct	3-17-78		
	220.3	208.90	11.4					C65561		2254	Kongwood Ct	7-28-78		
4+00	220.2	209.17	11.0											
				4+16.7				C65746		2258	Kongwood Ct	4-6-78		
5+00	219.3	209.57	9.7											
	219.0	209.63	9.4	5+14.1				C62943		2209	Hathway	9-21-77		
		209.73	9.3					C62945		2215	Hathway	9-8-77		
6+00	219.2	210.07	9.1											
				6+91.1	6+97.9			C66512	C63161	2262	Kongwood	5-22-78		
7+00	218.8	210.47	8.3											
8+00	218.7	210.87	7.8											
	218.5	210.95	7.6	8+20.6										
LINE 6														
0+00	220.3	209.00	11.3	0+00=3+59.1 LINE 5										
								C65411		2246	Kongwood	5-10-78		
	220.3	209.20	11.1	0+50.2	4" STUB W									
LINE 7														
0+00	221.3	208.52	12.8	0+00=3+09.6 LINE 4										
										2205	Brownfield Cr.	5-17-78		
1+00	221.6	208.92	12.7											
	221.7	209.04	12.7	1+31.6				C68382		2204	Brownfield	9-15-78		
		209.14	12.6					C66690		2205	Kongwood Cr.	6-5-78		
2+00	221.6	209.42	12.2					C70753		2204	Winstead	3-20-79		
	221.5	209.68	11.8	2+64.6				C69150		2219	Kongwood	10-30-78		
		209.78	11.7											
3+00	221.5	209.92	11.6											
				3+80.8				C66088		2245	Kongwood Cr.	4-26-78		
	221.5	210.24	11.3					C66089		2251	Kongwood Cr.	4-26-78		
4+00	221.5	210.32	11.2					C68383	C67289	2214	Winstead	9-15-78		
				4+19.0	5+12.3					2263	Kongwood Cr.	7-11-78		
5+00	222.5	210.72	11.8					C67971		2204	Winstead	8-22-78		
				5+22.9										
6+00	222.3	211.12	11.2											
	221.5	211.27	10.2	6+38.4										
LINE 8														
0+00	210.0	201.42	8.6	0+00= EXISTING										
1+00	211.0	201.82	9.2											
2+00	211.6	202.22	9.4					10026		7210-12	Bainbridge			
	212.0	202.50	9.5	2+68.0	4" STUB NE 4" STUB SE			C75008		7204-06	Bainbridge	10-22-79		
LINE 9														
0+00	210.0	201.42	8.6	0+00= EXISTING										
1+00	210.2	201.80	8.4											
2+00	210.9	202.18	8.7											
	211.1	202.32	8.8	2+40.3										
		202.42	8.7											

(CONT. NEXT PAGE)

B284A

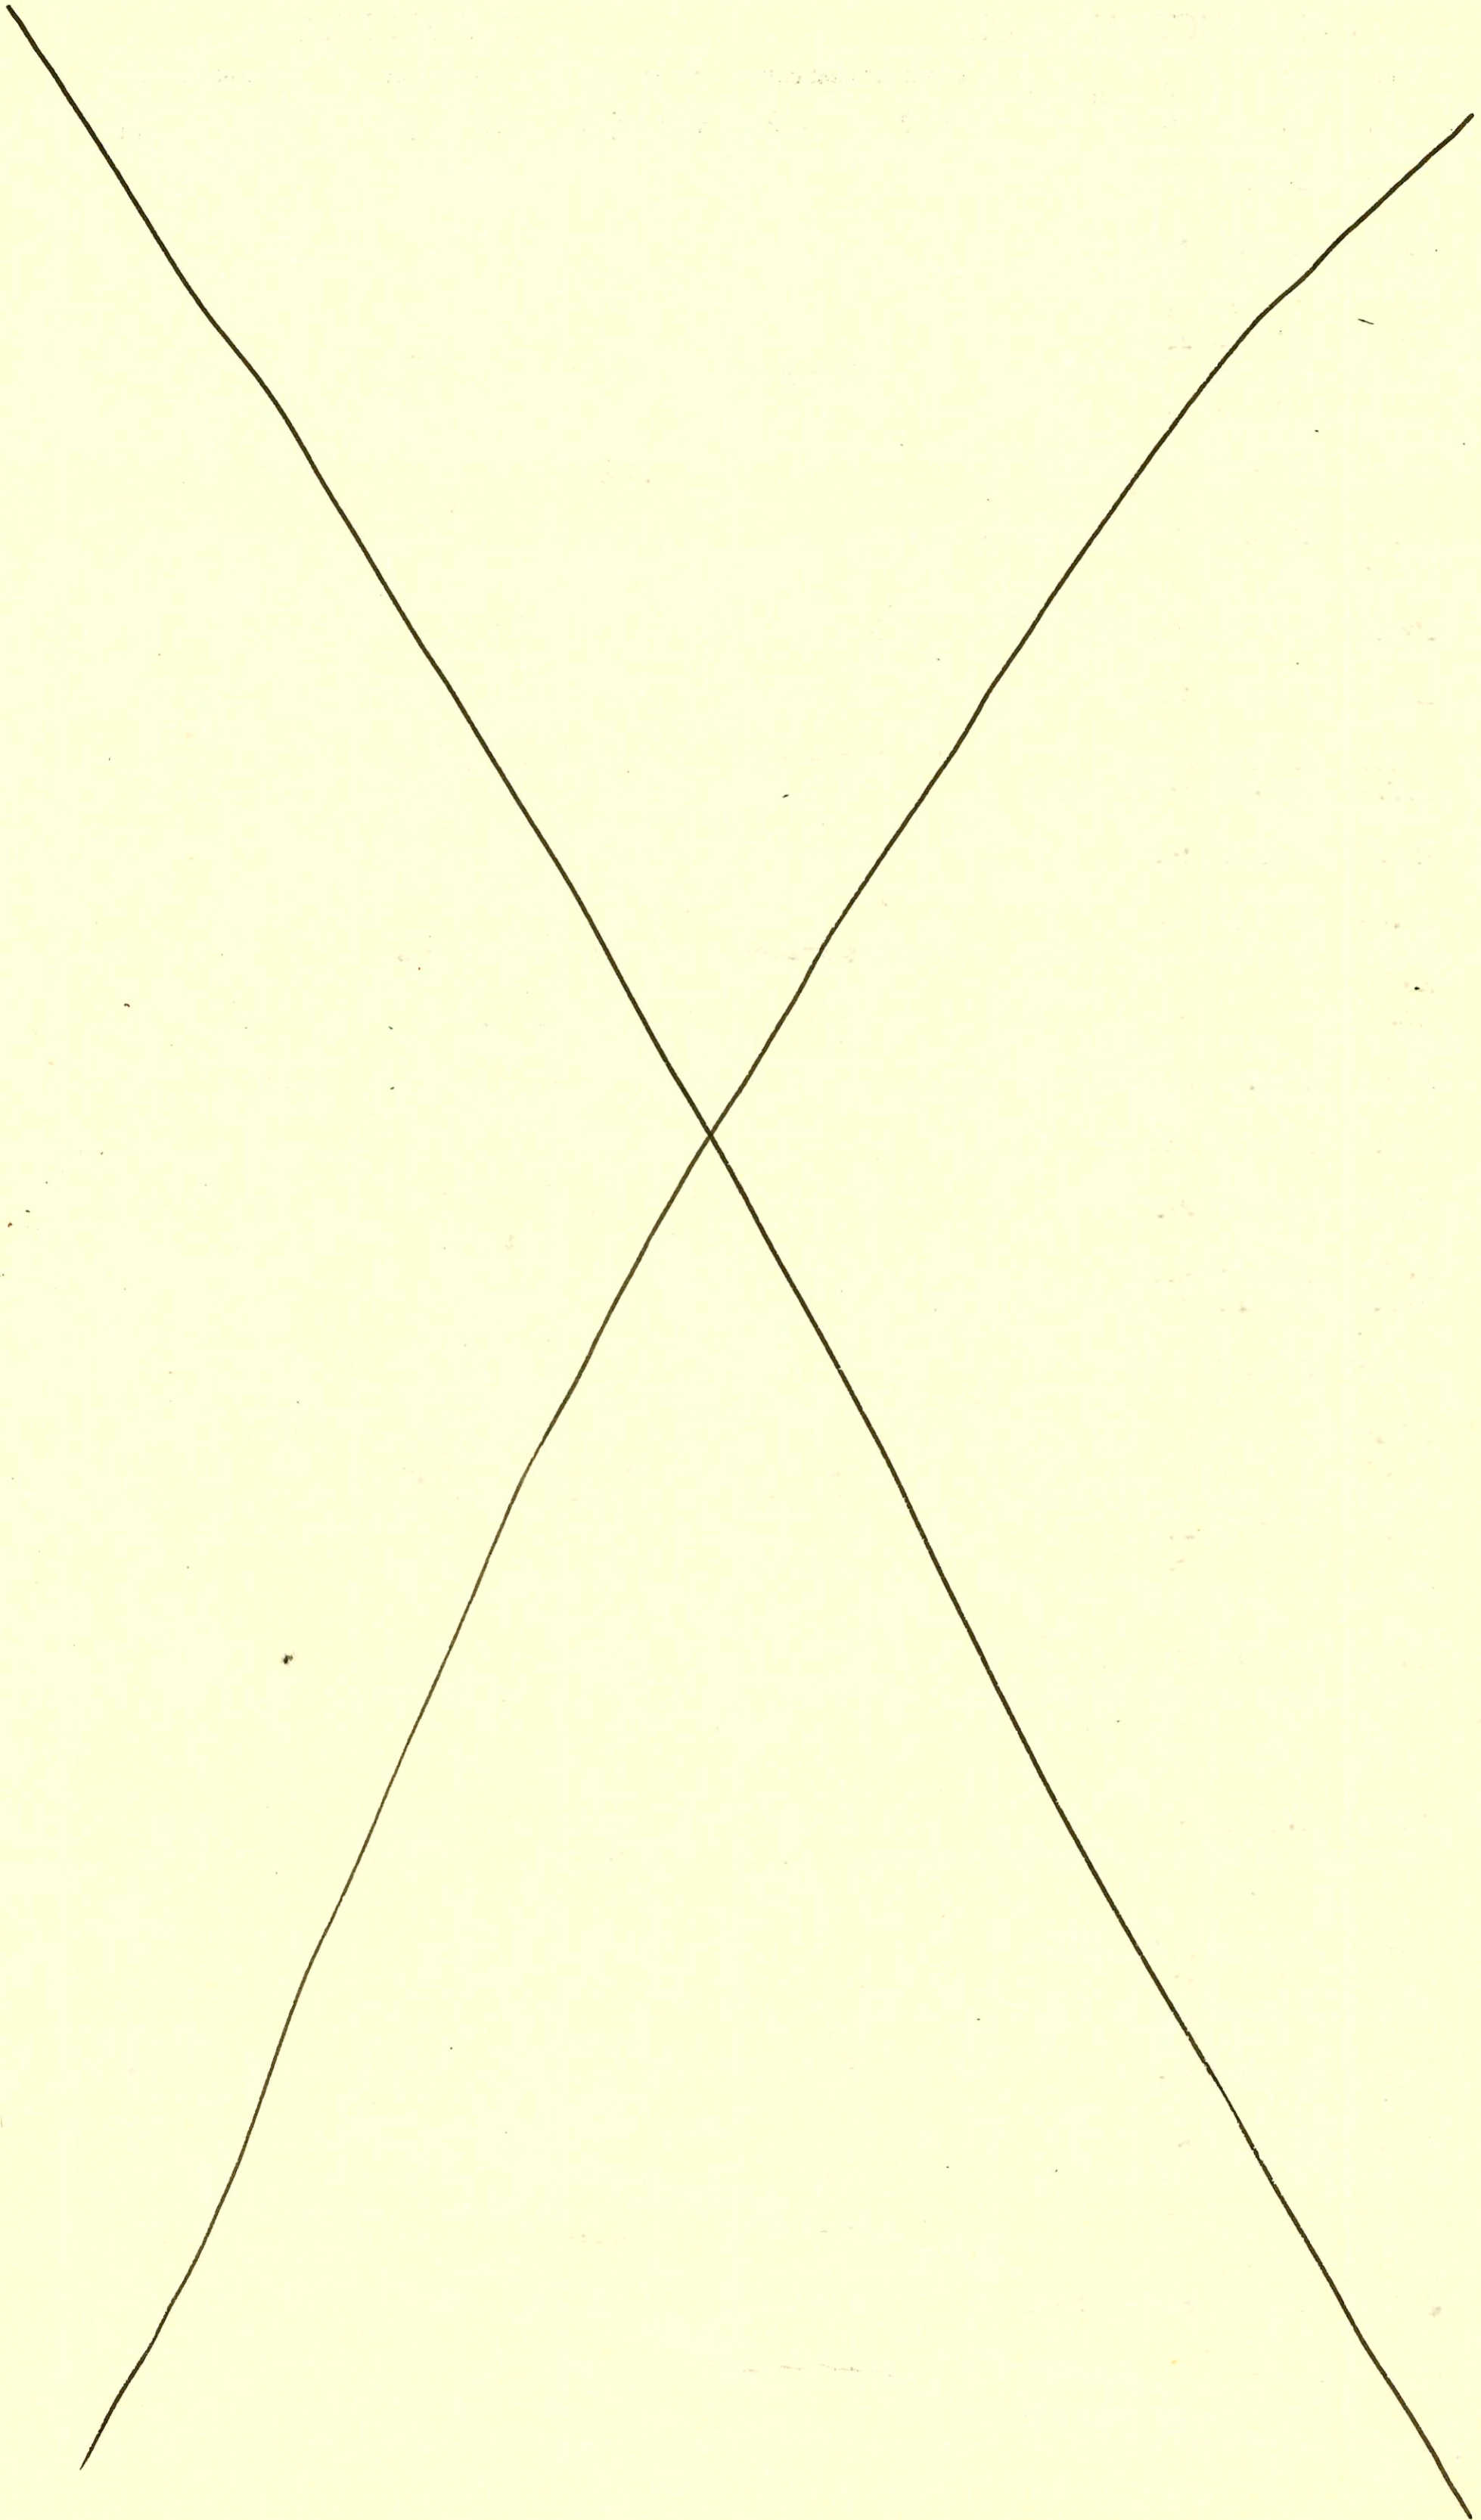

CONSTRUCTION RECORD

SERVICE RECORD

LAT 8 MAIN 6
SS 23 LINE 9

STATION	ELEVATION		Depth	MANHOLE	4-INCH "Y" BRANCHES		No. of Permit		House Number		DATE OF PERMITS			
	Ground	Grade			North West	South East	North West	South East	North West	South East	North West	South East	North West	South East
3+00	211.8	202.67	9.1											
4+00	212.5	203.07	9.4											
5+00	213.2 213.5	203.47 203.64	9.7 9.9	5+43.2										
6+00	213.7	203.87	9.8		5+82.2			257646	2353-55 Rutland Ct.			9-10-76		
7+00	214.2	204.27	9.9					2000-026446 94-139967 257647	2357-57 Rutland Ct.	Repl 12' High End		12-4-00 8-31-94 9-10-76		
8+00	215.2 215.2	204.67 204.70 204.80	10.5 10.5 10.4	8+08.8										
9+00	214.6	205.17	9.4		9+26.8			4894	7205 Applbury		12-10-81			
10+00	214.9	205.57	9.3		9+90.1			657895	2361-63 Rutland Ct.			9-27-76		
11+00	215.2 215.4	205.97 206.08	9.2 9.3	11+22.7	11+06.5	11+05.5	3737	257648	7215 Applbury	2365-67 Rutland Ct.	7-21-81	11-9-76		
12+00	215.7	206.37	9.3		11+88.7	11+90.7	3738	257649	7227 Applbury	2369-71 Rutland Ct.	7-21-81	9-27-76		
13+00	216.4	206.77	9.6		13+19.5			4895	7237 Applbury		12-10-81			
14+00	217.2 215.6	207.17 207.32	10.0 8.3	14+29.5	12+98.5			657859	2373-75 Rutland Ct.			2-10-77		
15+00	218.0	207.57	10.4		14+62.5			2095	7305 Applbury	2335 Addison Cr.	12-12-80	10-16-78		
16+00	218.7	207.97	10.7		15+72.5			976	7313 Applbury	2341 Addison Cr.	8-12-80	12-18-78		
17+00	219.6	208.37	11.2		15+72.5			669861						
18+00	220.4 220.4	208.66 209.01	11.7 11.5	17+65.0	17+16.6	17+00.6	1948	269525	7325 Applbury	2340 Addison Cr.	11-21-80	11-22-78		
19+00	220.8	210.01	10.8		17+18		1949		7334 Applbury		11-21-80			
20+00	221.0 221.0	211.01 211.36 211.46	10.0 9.6 9.5	20+34.8	18+61.0		1068		7339 Applbury		8-22-80			
21+00	221.1 221.3	212.02 212.76	9.1 8.5	21+65.4	19+61.8			667175 665562	2349 Brimley Cr. 2340 Inwood Cr.			6-30-78 3-28-78		
													8" STUB E	
LINE 10 0+00	211.1	202.42	8.7	0+00=2+40.3 LINE 9										
1+00	211.7	203.66	8.0		tap 1+13.6			671572	7230-33 Brimley Cr.			5-2-79		
2+00	213.6 214.0	204.90 205.15	8.7 8.9	2+19.6	tap 2+14.2			671573	7226-33 Brimley Cr.			5-2-79		
3+00	214.7	206.14	8.6		tap 2+70.6	2+59.6	671571	10027	7227-34 Brimley Cr.	7216-18 Brimley Cr.	5-2-79	1-17-84		
4+00	215.7 216.2	207.38 207.88	8.3 8.3	4+40.0				676205	7219-21 Brimley Cr.			1-18-80		
LINE 11 0+00	213.5	203.74	9.8	0+00=5+43.2 LINE 9	tap 6+77			671574	7236-38 Brimley Cr.			5-2-79		
1+00	213.0	204.62	8.4		tap 1+07.2			671580	7259-60 Brimley Cr.			5-2-79		
2+00	213.6	205.50	8.1		tap 1+72.0	1+57.0	671645	669685	2349-51 Rutland Ct.	2242-44 Brimley Cr.	7-13-76	12-1-79		
3+00	214.3 214.5	206.38 206.51	7.9 8.0	3+17.0	2+85.0			669644	7246-48 Brimley Cr.			12-1-78		
4+00	215.0	207.26	7.7		3+26.8			657644	2345-47 Rutland Ct.		11-4-76			
					4+11.8	4+04.6	657643	669849	2341-43 Rutland Ct.	7252-54 Brimley Cr.	11-4-76	4-2-79		

(CONT NEXT PAGE)

SWR 2001-02985 4/26/01-2408 N HATHWAY CIR- Roto- installed Fernco clamp @ foundation wall
where Bid drain + sewer had seperated

CONSTRUCTION RECORD

SERVICE RECORD

STATION	ELEVATION		Depth	MANHOLE	4-INCH "Y" BRANCHES		No. of Permit		House Number		DATE OF PERMITS			
	Ground	Grade			North West	South East	North West	South East	North West	South East	North West	South East	North West	South East
LAT 8 MAIN 6 SS 23 LINE 11	5+00	216.0	208.14	7.9		5+19		C59858		2337-39 Rutland Ct.		2-10-77		
	6+00	217.0 216.5	209.02 OUT 209.36 IN 209.46	8.0 7.1 7.0	6+31.0	7+07		C68942		2321 Addison Cr.		10-16-78		
	7+00	217.7 216.8	209.66 209.80	8.0 7.0	7+36.0	4" STUB SE		C68943		2315 Addison Cr.		10-16-78		
LINE 12	0+00	216.5	209.38	7.1	0+00 = 6+31 LINE 11									
		216.3	209.56	6.7	0+44.8	4" STUB NE		C68941		2329 Addison Cr.		10-16-78		
LINE 13	0+00	220.4	208.76	11.6	0+00 = 17+65 LINE 9									
	1+00	220.0	209.16	10.8		1+49.8	1+05.2	C68215 C69154		2341 Addison Inwood Cr.		4-20-78 10-30-78		
	2+00	219.6 219.5	209.56 209.74	10.0 9.8	2+45.7	2+16.1 2+64.5		C67892 C69850		2335 Inwood Cr. 2327 Inwood		8-16-78 12-18-78		
	3+00	219.2	209.96	9.2		3+70.7 3+54.7 4+41.3	3+58.4 4+36.3	C68897 C67199 C69153	C68740 C68757	2320 Addison 2314 Addison	2321 Inwood 2315 Inwood	10-13-78 6-30-78 10-30-78		
	4+00	219.2 219.6	210.36 210.72	8.8 8.9	4+91.3	4" STUB SW	4" STUB SE	C68165 C67974		2306 Addison	2307 Inwood	8-31-78 8-22-78		
LATERAL 7 MAIN 6 SS N ^o 23 LINE 1	0+00	217.3	208.60	8.7	0+00 EXISTING	1+10		2555 C66692		2318 Hathway		8-20 6-5-78		
	1+00	216.0	209.00	7.0		1+99.3		C66459		2326 Hathway		5-17-78		
	2+00	215.3	209.40	5.9										
	3+00	214.0	209.79 OUT 209.82 IN 209.92	4.2 4.2 4.7	3+07.3									
	4+00	214.0	210.30	3.7										
	5+00	214.8	210.70	4.1		4+83.7 4+30.09		C67973		2334 Hathway 2308 Hathway		8-22-78 12-5-80		
	6+00	215.5 215.9	210.94 211.10	4.6 4.8	5+63.2	5+97.26 6+68.0		C69103 C67174		2338 Hathway 2344 Hathway		10-26-78 6-30-78		
	7+00	217.0	211.50	5.5		7+54.4		C68253 C68167		2348 Hathway 2353 Winsted Cr.		9-8-78 8-31-78		
	8+00	218.0 218.3	211.90 211.96	6.0 6.4	8+16.9	8+47.2								
	9+00	219.7	212.30	7.4										
	10+00	220.4 220.8	212.70 212.96	7.7 7.8	10+69.6	4" STUB SW		C6928 C64191		2342 Winsted 2343 Winsted		6-20-78 11-23-77		
LINE 4	0+00	221.6	212.08	9.5	0+00 EXISTING									
	1+00	222.0	212.48	9.5										
	2+00	222.1	212.88	9.2		2+29.7	2+32.2	C70829 C66935 C69810		2322 Bromfield	2315 Winsted Cr. 2323 Winsted Cr.	6-20-78 3-26-79 12-20-78		
	3+00	222.1 222.0	213.28 OUT 213.32 IN 213.42	8.8 8.7 8.6	3+13.7	3+93.1 3+62.7		C66939 C68252 C66939		2332 Bromfield 2332 Bromfield	2331 Winsted	6-20-78 9-8-78 6-20-78		
	4+00	222.0	213.78	8.2		4+35.5		C6930		2338 Bromfield	2339 Winsted	6-20-78 12-18-78		
		222.0	214.02	8.0	4+64.5	4" STUB E		C6951						

(CONT NEXT PAGE)

CONSTRUCTION RECORD

SERVICE RECORD

STATION	ELEVATION		Depth	MANHOLE	4-INCH "Y" BRANCHES		No. of Permit		House Number		DATE OF PERMITS	
	Ground	Grade			North West	South East	North West	South East	North West	South East	North West	South East
LAT 7 MAIN 6 5523 LINE 5 0+00	218.5	211.08	7.4	0+00 EXISTING								
1+00	218.2	211.48	6.7		0+7.6	0+71.6	C68380	C70830	2308 Longwood	2307 Hathway	9-15-78	3-26-79
2+00	218.0 OUT 211.74 IN 211.84	211.98	6.3 6.2	1+66.3		1+95.9	C70752		2314 Longwood			3-20-79
3+00	218.3	211.98	6.3			1+81.3	C67891		2335 Hathway			8-16-78
	219.0 OUT 212.30 IN 212.40	212.48	6.7 6.6	2+84.1		2+77.1	C66926		2343 Hathway			6-20-78
3+00	219.4	212.48	6.9									
	220.2	212.66	7.5	3+47.8	4" STUB NW	3+40.8	C67176	C67862	2350 Winstead	2335 Longwood	6-20-78	12-18-78
LINE 7 0+00	221.5	211.47	10.0	0+00 EXISTING	Tap 0+47		C70894		2306 Winstead		3-29-79	
1+00	220.9	211.87	9.0		Tap 1+30.1	0+77.2	C70845	C70893	2318 Winstead	2309 Longwood	3-27-79	5-15-79
2+00	221.9	212.27	9.6		Tap 1+49.8	1+26.8	C69390	C66503	2328 Winstead	2319 Longwood	7-14-78	5-22-78
	221.8	212.44	9.4	2+38.8	4" STUB NW		C66497		2342 Winstead		6-22-78	
LINE 9 0+00	221.3	212.86	8.4	0+00 EXISTING	Tap 1+24.1					2345 Bronfield		9-8-78
1+00	221.6	213.26	8.3				C68251					9-20-78
	221.5	213.56	7.9	1+76.1	4" STUB SE		C68457			2344 Bronfield		9-20-78
LATERAL 54 SOUTHWEST INTERCERTOR												
0+00	143.2	130.00	13.2	0+00								
1+00	143.4	130.19	13.2									
2+00	143.4 OUT 130.20 IN 130.30	130.50	13.2 13.1	1+03.8								
3+00	143.0	130.50	12.5				99-9437		545 S Asim		5-8-97	
3+00	143.3 OUT 130.70 IN 130.72	130.81	12.6 12.6	3+09.0			3126.07AD	12540	555 S Robin Rd		6-22-87	
4+00	143.4	130.99	12.4									
5+00	143.0	131.19	11.8									
6+01.2	143.0	131.39	11.6	6+01.2	5+72.8 5+83.8 6+21.1 6+42.0	5+50.2 6+21.9	C59497 C59496 C59495 C59494	C63514 C62619	528 S Robin Rd 526 S Robin Rd 522 S Robin Rd 520 S Robin Rd	543 Evergreen 533 Evergreen	2-10-77 2-11-77 2-10-77 2-9-77	10-13-77 9-20-77
7+00	143.2	131.59	11.6		7+125.5 7+35.4	7+04.1	C59493 C59492	C62620	516 S Robin Rd 514 S Robin Rd	525 Evergreen	2-9-77 2-4-77	8-18-77
8+00	142.9	131.79	11.1		7+95.7 8+48.2	7+22.9 8+64.4	C59491 C59490	C62209	510 S Robin Rd 508 S Robin Rd	517 Evergreen 509 Evergreen	1-25-77 1-25-77	7-22-77 2-11-77
9+00	142.8	131.97	10.8	8+89.9								
9+00	142.9	131.99	10.9		9+21.0 9+24.9	9+36.5	C59489 C59488		504 S Robin Rd 502 S Robin Rd	501 Evergreen	1-24-77 1-24-77	10-18-77
10+00	142.4	132.19	10.2		10+201.4 10+30.7	10+26.4 10+49.8	C59487 C59486	C59788 C59786	434 S Robin Rd 432 S Robin Rd	431 Evergreen 433 Evergreen	1-24-77 1-24-77	2-11-77 2-10-77
11+00	142.5	132.39	10.1		11+11.5 11+14.6		C59485 C59484		428 S Robin Rd 426 S Robin Rd		1-21-77 1-21-77	
12+00	142.5	132.55	10.0	11+79.3								
12+00	142.5	132.59	9.9		12+03.1 12+05.1 12+25.3	12+13.6	C59483 C59482 C59481	C59789	422 S Robin Rd 420 S Robin Rd 416 S Robin Rd	425 Evergreen	1-21-77 1-21-77 1-20-77	2-14-77
13+00	142.6	132.79	9.8		13+17.1 13+91.4	13+48.2 13+20.4	C59480 C59479	C61305 C59791	414 S Robin Rd 410 S Robin Rd	417 Evergreen 409 R Evergreen	1-20-77 1-20-77	5-26-77 11-16-00 2-14-77
14+00	142.2	132.99	9.2		14+02.6		C59478		408 S Robin Rd		1-20-77	
	142.5	133.10	9.4	14+54.6	4" STUB NW	14+49.0	C59787		8109 University			2-15-77

2000-02399- 1/2" 100 - Three R - 600 S. Tyler Rd #222 (side Pockets) 4" SCH 40 - installed 2-1000 grease interceptors
 25' from main "SCH 40 - 1-1/2" way CO, ITWIN CO, 1145, 4145 (Between with STN 4946-174 and 4946-173)
 (3+09) (1+03.8)