


HEADGEATH ADDN SANITARY SEWER  
BUILT BY: UTILITY CONTR INC.  
PROJ. N° DBKW 707004  
BOOKED 3-22-77 FROM AR555


SCALE 1"=150'

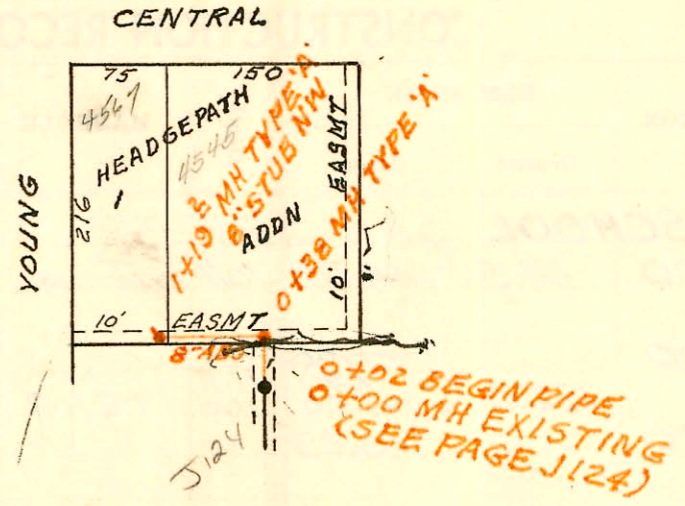


WHEATLAND PLACE 2ND ADDN SAN SEWER  
BUILT BY: UTILITY CONTR. INC.  
PROJ. N° DBKW 707003  
BOOKED 3-23-77 FROM AR555

SCALE 1"=150'

500<sup>00</sup>  
Spec fee  
Paid

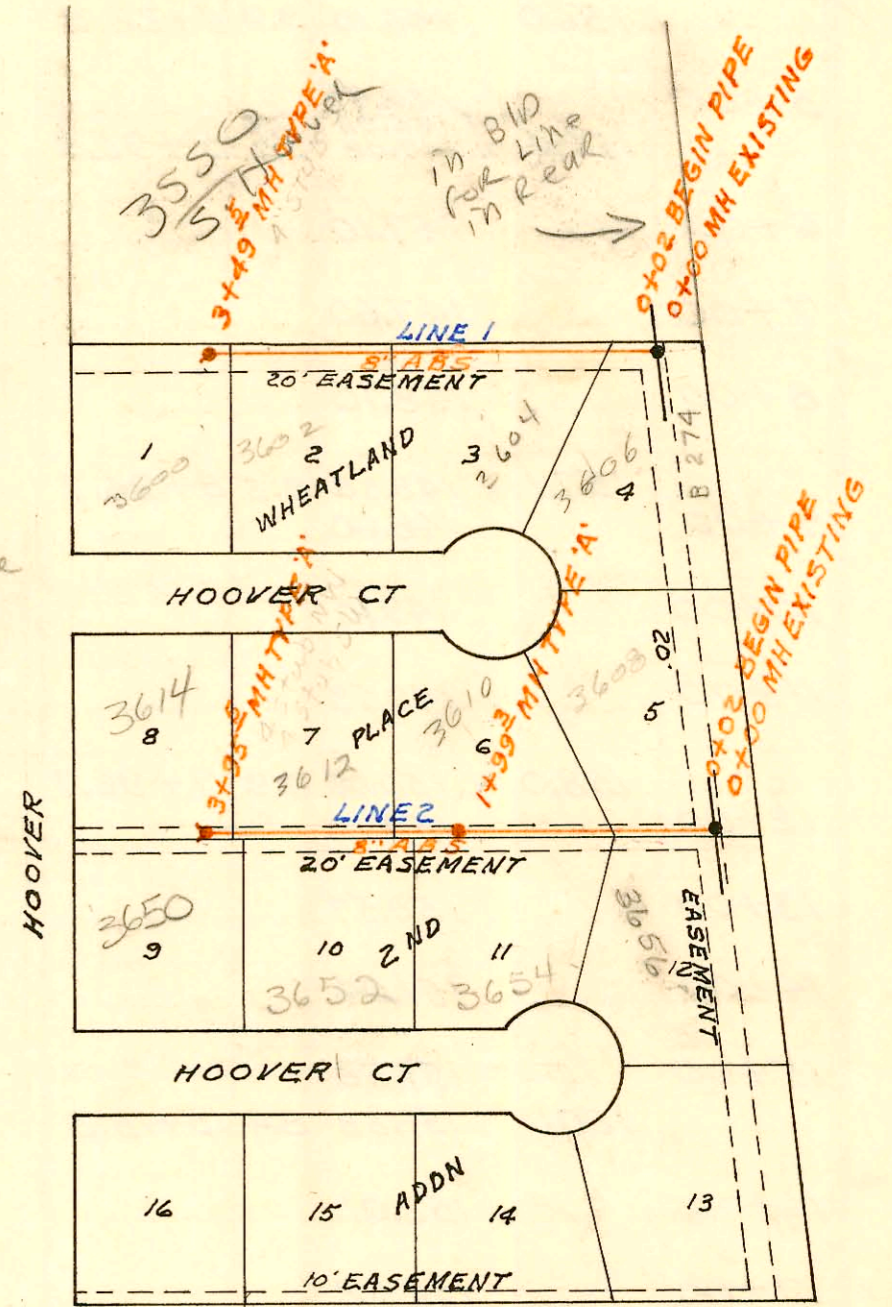

SCALE 1"=150'

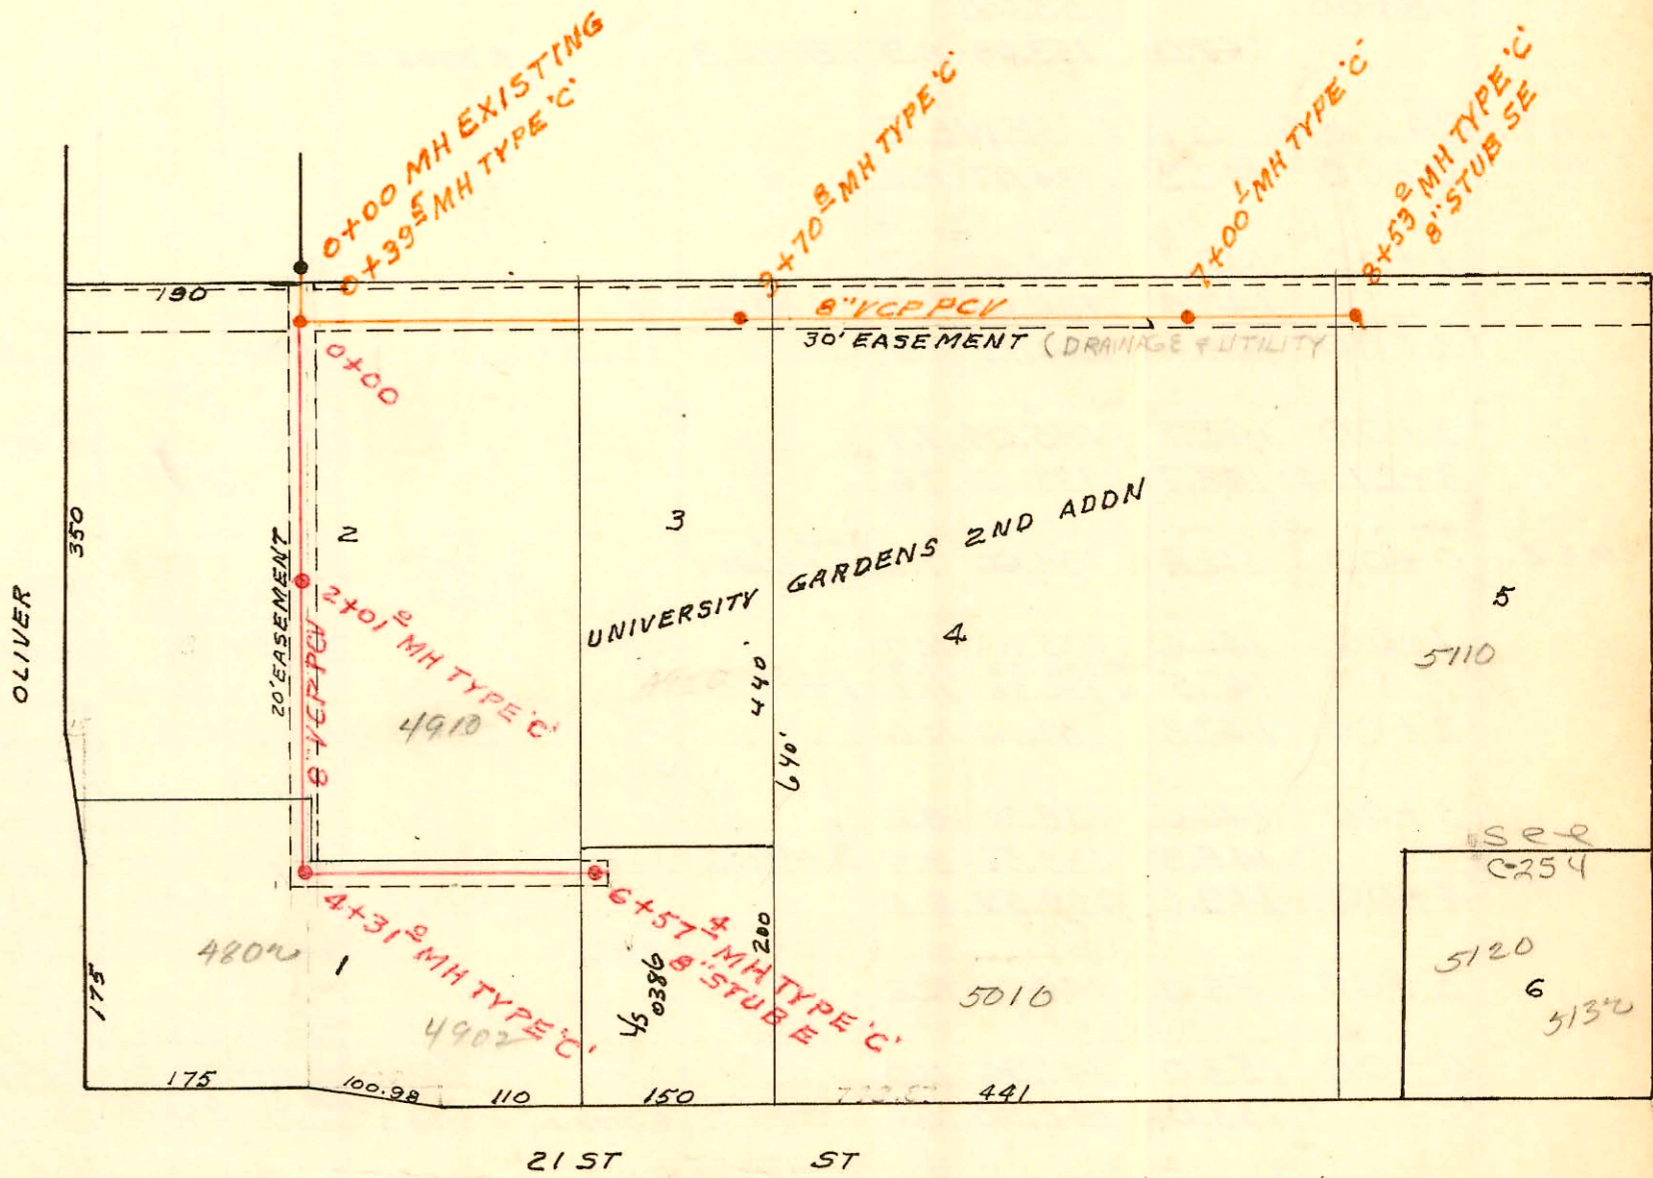

\* KRESGE SAN SEWER 21ST & OLIVER  
BUILT BY: UTILITY CONTR INC  
PROJ. N° DBKW 706062  
BOOKED 3-24-77 FROM IH80

\* UGLOT3 SAN SEWER 21ST & OLIVER  
BUILT BY: UTILITY CONTR INC  
PROJ. N° DBKW 707005  
BOOKED 3-24-77 FROM IH80

CONSTRUCTION RECORD

SERVICE RECORD

STATION	ELEVATION		Depth	MANHOLE	4-INCH "Y" BRANCHES		No. of Permit		House Number		DATE OF PERMITS	
	Ground	Grade			North West	South East	North West	South East	North West	South East	North West	South East
<b>HEADGEATH ADDN SANITARY SEWER</b>												
0+00	121.7	115.01	6.7	0+00 EXISTING								
0+02	120.2	115.26	4.9	0+38.0	0+42.4			C60084	4545 W Central		7-20-77	
1+00	119.9	115.51	4.4									
	119.7	115.58	4.1	1+19.2	8" STUB NW			C73639	4567 W Central		8-15-77	
<b>WHEATLAND PLACE 2ND ADDN SAN SEWER</b>												
LINE 1 0+00	105.3	102.29	3.0	0+00 EXISTING								
0+02												
1+00	105.6	102.49	3.1									
2+00	105.8	102.69	3.1									
3+00	105.9	102.89	3.0									
	106.0	102.99	3.0	3+49.5								
LINE 2 0+00	106.0	103.05	3.0	0+00 EXISTING								
0+02												
1+00	106.2	103.25	3.0									
	106.4	103.45	3.0	1+99.3								
2+00	106.4	103.45	3.0									
3+00	106.6	103.65	3.0									
	106.8	103.84	3.0	3+95.5	4" STUB NW	4" STUB SW						
<b>KRESGE SAN SEWER 21ST &amp; OLIVER</b>												
0+00	210.0	196.64	13.4	0+00 EXISTING								
	207.8	196.87	10.9	0+39.5								
1+00	208.5	197.07	11.4									
2+00	207.6	197.40	10.2									
3+00	207.7	197.73	10.0									
	208.6	197.96	10.6	3+70.8								
4+00	209.0	198.06	10.9									
5+00	209.0	198.39	10.6									
6+00	209.4	198.72	10.7									
7+00	209.4	199.05	10.4	7+00.1								
8+00	208.7	199.25	9.5									
	207.0	199.35	7.7	8+53.0	8" STUB SE							
<b>UGLOT 3 SAN SEWER 21ST &amp; OLIVER</b>												
0+00	207.8	196.77	11.0	0+00 EXISTING								
1+00	209.1	197.17	11.9									
2+00	209.7	197.57	12.1	2+01.0								
3+00	209.5	197.97	11.5									
4+00	213.2	198.37	14.8									
	214.4	198.59	15.8	4+31.0								
5+00	214.1	198.87	15.2									
6+00	212.9	199.26	13.6									
	212.2	199.49	12.7	6+57.4	8" STUB E							

99.7893-7-42799 4970 21st N - McCullough