DIST. 2 - S.S. No. 12
1924

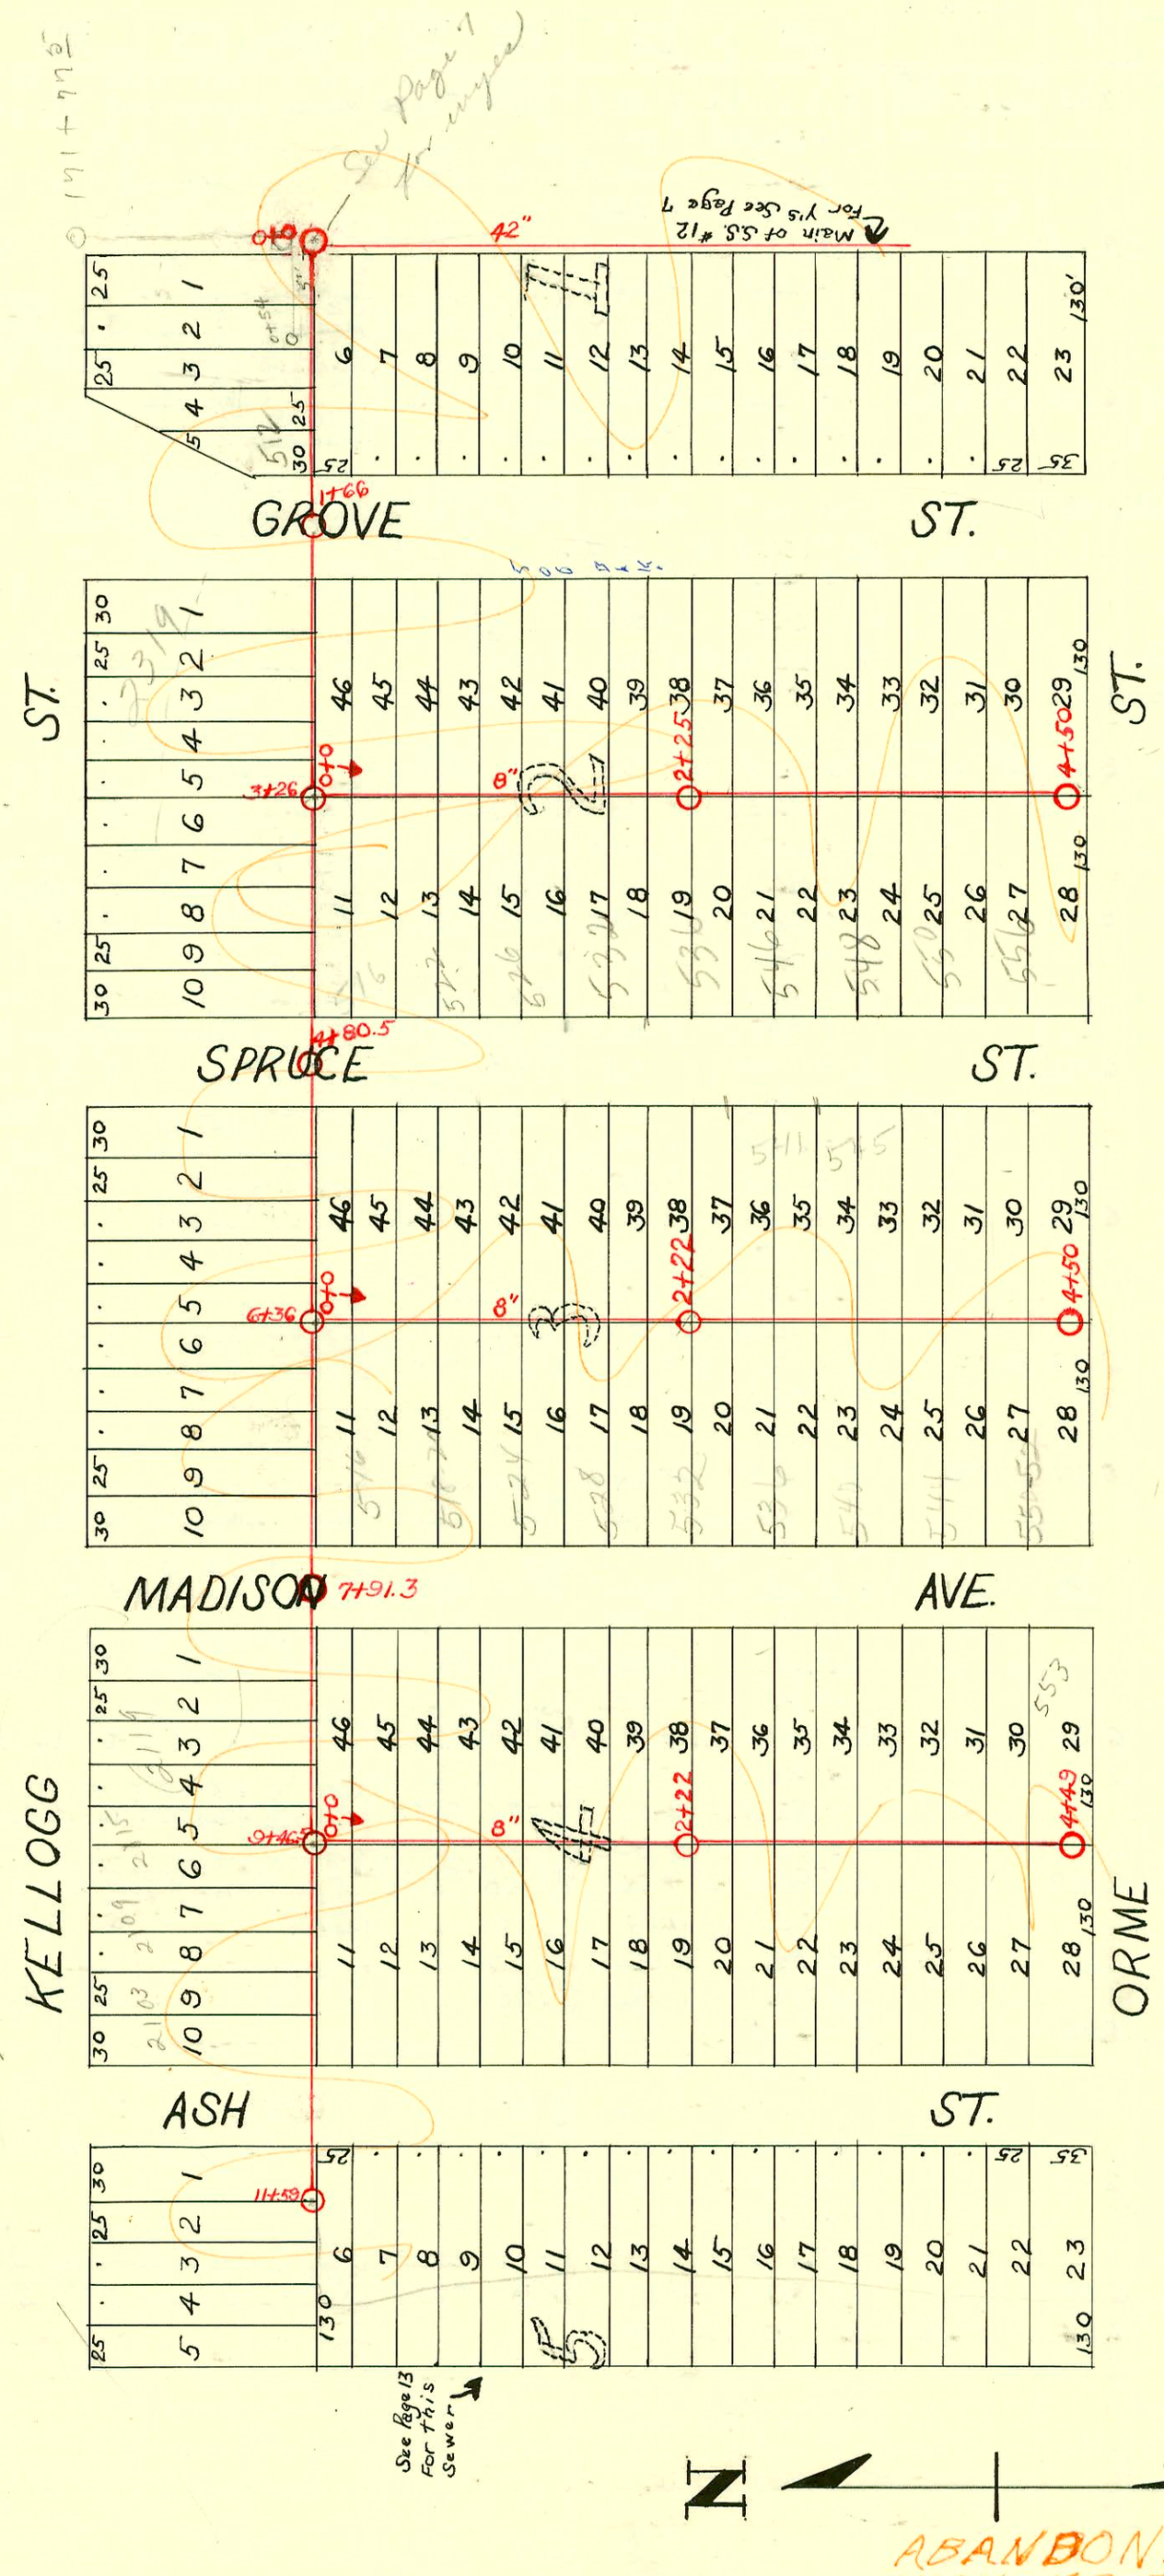

Form 41-(54) 8-58

CONSTRUCTION RECORD

STATION	ELEVATION Ground	ELEVATION Grade	Depth	MANHOLE	4-INCH "Y" BRANCHES North West	4-INCH "Y" BRANCHES South East
					North	South
Line South of Kellogg 0+0	106.60	98.0	8.6	0+0	0+10.3	
					+35.7	
					+60.8	
					+82 +83.3	
1+0	106.43	98.1	8.33		1+10.5	
				1+66	+36	
2+0	106.65	98.2	8.45		2+01.8	
					+26	
					+52.2	
					+77.3	
3+0	106.60	98.3	8.3		3+00.5	
				3+26	+20.5	
					+46.6	
					4+01.0 +71	
					3+95.5 +96.3	
4+0	106.41	98.4	8.01		4+22	
				4+80.5	+47.5	
5+0	105.89	98.5	7.39		5+09	
					+34.2	
					+59.6	
					+85	
6+0	105.97	98.6	7.37		6+07.2	6+09.8
					+28	
				6+36	+53	
					+78.7	
7+0	106.90	98.7	8.2		7+04.5	
					+29.5	
					+54.5	
8+0	106.40	98.8	7.6	7+91.3	8+20	
						8+24.8
					+44.8	
					+70.5	
					+96	
9+0	106.57	98.9	7.67		9+16	9+18.7
				9+46.5	+39	
					+64	
					+89.2	
10+0	106.55	99.0	5.55		10+14	
					+40	
					+59.5	
11+0	107.0	99.1	7.9		11+29	
+59	106.96	99.16	7.8	11+59	+47	11+49.6
				9+46.5 or 0+0 For line So.		
					WEST	EAST
Between Ash & Madison, Kellogg to Orme 0+0	106.44	98.94	7.5	0+0	0+11	0+08.5
					+36.5	+34
					+62	+59.5
					+87.1	+84.6
1+0	106.53	99.04	7.49		1+13	1+10.5
					+38	+35.5
					+64.1	+61.6
					+89.5	+87
2+0	106.31	99.14	7.17	2+22	2+14.5	2+12
					+41	+38.5
					+65.5	+63
					+91	+88.5
3+0	106.95	99.24	7.71		3+16.5	3+14
					+42.5	+40
					+68	+65.5
					+93.5	+91
4+0	105.98	99.34	6.64	4+49	4+18.5	4+16
+49	106.44	99.39	7.05		+42	+39.5

SERVICE RECORD

No. of Permit North West	No. of Permit South East	House Number North West	House Number South East	DATE OF PERMITS North West	DATE OF PERMITS South East
#C16463 #1286		514 S. Spruce		10-27-69 12-1-25	
#C22774 #455		2323 S. 2321 E. Kellogg		1-29-65 5-1-25	
#B2273 #914		2317 E. Kellogg		1-29-65 9-30-30	
B2988 C38467		2312 E. Kellogg		3-15-65 4-19-93	
#A2777 #778		2321 E. 2311 Kellogg		1-29-65 7-19-28	
C34142 #760		2305 E. Kellogg		5-6-71 9-16-28	
C21642 #152		2303 E. Kellogg		4-17-73 3-10-27	
C20858 #1001		510 S. Spruce		9-4-73 8-6-29	
C37209 #342		2223 E. Kellogg		2-15-73 5-3-27	
C23151 #777		2219 E. Kellogg		3-10-71 9-13-26	
#1074		2217 E. Kellogg		12-11-26	
C23150		2213 E. Kellogg		3-10-71	
#845		2205 E. Kellogg		8-1-25	
C23149 #2487		2303 E. Kellogg		3-10-71 11-6-24	
C23148		2203 E. Kellogg		3-10-71	
C34672 #130		2119 E. Kellogg		9-5-73 3-8-29	
C23147 #142		2113 E. Kellogg		3-8-71 3-1-26	
#C11581 #1051		2103 E. Kellogg		11-28-27	
C17829 #534	C17828 #679	516 S. Ash	515 S. Madison	2-2-70 5-18-28	2-2-70 8-6-26
C16477 #1887 #1289	C16476 #619	520 S. Madison 520 S. Ash	518 S. Madison	10-27-69 9-18-24 12-2-25	10-27-69 6-8-25
C18345 #380	C16471 #472	526 S. Ash	529 S. Madison	4-23-70 5-10-26	10-27-69 5-5-25
C16486 #792	C16475 #1515	528 S. Ash	529 S. Madison	10-27-69 7-26-28	10-27-69 7-2-24
C16479 #1112		538 S. Ash	533 S. Madison	8-21-69	10-27-69 10-16-28
C17004 #149	C16472 #1631	540 S. Ash	541 S. Madison	11-21-69 2-3-1926	10-27-69 7-15-24
C17679	#2062	546 S. Ash	545 S. Madison	1-16-70	10-27-69 9-10-24
#709	C16474 #109	546 S. Ash	547 S. Madison	7-11-28	10-27-69 2-15-26
#C17680 #C17681 #395		550 S. Ash 528 S. Ash		1-16-70 4-18-28	
	#C18054 #1021		553 S. Madison		2-19-70 11-26-26

Note: For Y's on lines between Madison and Spruce and Spruce and Grove see page 15.

#2465 - Tap - 552 S. Madison - 9-10-40 C31640 - Seal off 4-17-72 at Henning
#1697 - Tap - 2115 E. Kellogg.
#C22219 Seal off - 2115 E. Kellogg - 12-16-70 (9+57.5)
S.O C34676 - 512 S. Grove - at Henning - 9-5-72 (0+84)
S.O C34677 - 2409 E. Kellogg - at Henning - 9-5-72 (0+57 + 26' N.)