


DIST. 3 - S.S. No. 12
1924

ORME ST.

25	38	6+22.5	49	25
	40		51	
	42		53	
	44		55	
	46		57	
	48		59	
	50		61	
	52		63	
	54	4+04.5	65	
	56		67	
62.8	58		69	
	60		71	
	62		73	
	64		75	
	66		77	6.39
	68		79	
	70	2+01	81	6.43
	72		83	
	74		85	
	76		87	
	78		89	6.5
	80		91	6.5
30/125	82		93	30/125
	84		95	

AVE.

AVE.

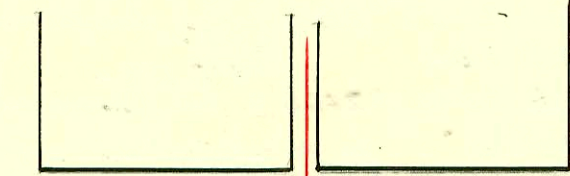

GILBERT

25	2	1	25
	4	3	
	6	5	
70.8	8	7	
	10	9	
	12	11	
	14	13	17.99
	16	15	
	18	17	
72	20	19	
	22	21	
73.0	24	23	
	26	25	72.5
	28	27	
	30	29	4+08
	32	31	
	34	33	
	36	35	
	38	37	
	40	39	
	42	41	
	44	43	
	46	45	
25	48	47	6+16.8

AVE.

ESTELLE

MORRIS

ST.

25	2	1	25
	4	3	70.1
	6	5	
	8	7	
	10	9	
	12	11	
	14	13	2+00
	16	15	71.7
	18	17	
	20	19	
	22	21	71.2
72.6	24	23	
	26	25	
	28	27	
	30	29	4+04.3
	32	31	
	34	33	
	36	35	
	38	37	
	40	39	
	42	41	
	44	43	
75.6	46	45	75.5
25	48	47	6+14

VOLUTSIA

ERIE

ST.

2403-00817 3/27/03 726 S Volutsia - Boardman - City Wye repair 72's of HH2120 (2+72) 6" Precoas
4" 40 PUC, 1 dir 20, 2V45

CONSTRUCTION RECORD

SERVICE RECORD

STATION	ELEVATION		Depth	MANHOLE	4-INCH "Y" BRANCHES		No. of Permit		House Number		DATE OF PERMITS			
	Ground	Grade			North West	South East	North West	South East	North West	South East	North West	South East	North West	South East
Between Estelle & Volutsia Gilbert to Morris	0+0	105.70	98.88	6.82	M.H. in Gilbert 0+0	0+36.5	0+34							
						+61.5	+59	#1655	#240	704 S. Estelle	703 S. Volutsia	11-21-24	4-6-27	
						+87	+84.5	#527	#530	708 S. Estelle	703 S. Volutsia	6-22-26	6-22-26	
	1+0	105.33	98.98	6.35		1+12.1	1+09.6				711 S. Volutsia		5-22-28	
						+37.5	+35		#260					
						+63.2	+60.7			716 S. Estelle	715 S. Volutsia	5-18-26	12-9-29	
	2+0	105.23	99.08	6.15	1+99	2+13.8	2+11.3	#417	#1715					
						+39.5	+37	#612	#944	722 S. Estelle	717 S. Volutsia	6-17-30	9-4-28	
						+65	+62.5	#611		726 S. Estelle		6-17-30		
						+90.5	+88		#240	721 S. Volutsia			3-24-26	
	3+0	105.65	99.18	6.47		3+15.5	3+13	#65		724 S. Estelle		1-26-28		
						+41.5	+39		#724		725 S. Volutsia		7-9-28	
						+66.5	+64							
						+91.8	+89.3	#589	#137	734 S. Estelle	734 S. Volutsia	7-9-26	4-7-37	
	4+0	106.01	99.28	6.73	4+08	4+17	4+14.5		#1078		735 S. Volutsia		12-5-27	
						+42	+39.5	#464		736 S. Estelle		10-21-41		
						+67.5	+65							
	5+0	106.10	99.38	6.72		5+17.7	5+15.2	#1055		738 S. Estelle		11-29-27		
						+42.8	+40.3	#658	#1702	744 S. Estelle	737 S. Volutsia	9-17-51	5-8-29	
						+68.5	+66			740 S. Estelle	747 S. Volutsia	8-2-26	12-5-29	
	6+0	106.15	99.48	6.67		6+16.8	6+16.8	#482		746 S. Estelle		6-10-26		
	6+16.8	106.15				+94.5	+92		#533	757 S. Volutsia		1-5-32	5-19-25	
Between Volutsia & Erie Gilbert to Morris	0+0	107.37	99.41	7.96	M.H. in Gilbert 0+0	0+38.5	0+36	#904		702 S. Volutsia	701 S. Erie	9-26-30	4-27-25	
						+63.1	+60.6	#421	#551	704 S. Volutsia	707 S. Erie	4-27-25	12-26-36	
						+88.5	+86		#407				4-23-30	
	1+0	105.90	99.51	6.39		1+13.9	1+11.4				711 S. Erie		11-18-40	
						+39.1	+36.6		#2877	710 S. Volutsia		7-20-29		
						+64	+61.5	#901						
						+89.5	+87				717 S. Erie		10-27-26	
	2+0	105.29	99.61	5.68	2+00	2+15	2+12.5		#919					
						+39.8	+37.3	#598	#188	714 S. Volutsia	735 S. Erie	6-12-30	3-18-27	
						+64.9	+62.4	#591	#445	726 S. Volutsia	721 S. Erie	7-10-26	5-31-27	
						+90.8	+88.3							
	3+0	105.49	99.71	5.78		3+16	3+13.5							
						+41.1	+38.6	#329		728 S. Volutsia		12-19-28		
						+66.5	+64	#914		725 S. Erie		10-27-26		
						+91.5	+89	#1178	#727	738 S. Volutsia	731 S. Erie	11-7-28	8-29-27	
	4+0	105.75	99.81	5.94	4+04.3	4+17.5	4+15	#514	#175	732 S. Volutsia	735 S. Erie	5-15-28	3-16-27	
						+42.5	+40	#105		738 S. Volutsia		2-21-27		
						+67.8	+65.3							
	5+0	105.77	99.91	5.86		5+17.9	5+15.4		#1763		747 S. Erie		12-27-29	
						+43.2	+40.7							
	6+0	105.56	100.01	5.55		6+14	6+14	#987	#77	736 S. Volutsia	755 S. Erie	11-17-26		
	6+22.5	105.56				+68.5	+66	#312		756 S. Volutsia	756 S. Erie	6-22-37	2-16-31	
	6+14	105.56				+93.5	+91	#379		756 S. Volutsia		4-16-29		
Between Volutsia & Erie Gilbert to Orme	0+0	107.84	99.22	8.62	M.H. in Gilbert 0+0	0+34	0+36.5	#986		656 S. Volutsia	657 S. Erie	11-3-30	9-12-41	
						+58.5	+61	#986	#66	650 S. Volutsia	655 S. Erie	11-3-30	9-11-41	
						+83.5	+86		#65					
	1+0	107.10	99.37	7.73		1+09.3	1+11.8	#314						
						+34	+36.5							
						+59.5	+62	#822	#832	646 S. Volutsia	647 S. Erie	10-3-27	4-25-38	
						+84	+86.5							
	2+0	107.77	99.52	8.25	2+01	2+09.3	2+11.8	#1039	#787	640 S. Volutsia	643 S. Erie	12-1-30	4-4-38	
						+34.2	+36.7	#387		636 S. Volutsia		4-17-29		
						+59.4	+61.9	#526	#670	624 S. Volutsia	639 S. Erie	5-17-28	12-31-37	
						+84.7	+87.2							
	3+0	106.72	99.67	7.05		3+10	3+12.5	#1846		632 S. Volutsia		9-19-39		
						+35	+37.5	#2682		624 S. Volutsia		8-23-40		
						+59.4	+61.4							
						+85	+87.5							
	4+0	107.29	99.82	7.47	4+04.5	4+10	4+12.5	#560		622 S. Volutsia		6-28-26		
						+34.7	+37.2							
						+60	+62.5	#489	#2814	616 S. Volutsia	611 S. Erie	5-7-28	12-1-54	
						+84.8	+87.3	#2540		612 S. Volutsia		10-2-50	11-13-79	
	5+0	106.99	99.97	7.02		5+10.4	5+12.9	#390		612 S. Volutsia		4-17-		
						+34.5	+37							
						+60.5	+63							
	6+0	107.91	100.12	7.79		6+22.5	6+22.5	#2364		601 S. Erie		5-31-40		
	6+22.5	108.14	100.16	7.98		+83.5	+86							
						+60.9	+61.5							

Tap - 4418 - 725 Volutsia - 9-7-82 - John M. Schlegel (4+38.0) (8' N of m) (4+38.0) (also relocated)
 Tap - 748 S. Volutsia - 6-21-28 - #661 - T.P. Hayes
 Tap - 606 S. Volutsia - 12-24-29 - #1520 - C.W. Burgen Deal off C 9195 - at Henning 6-20-68
 Tap - 745 S. Erie - 12-11-29 - #1745 - Tess Hanna
 Tap - 712 S. Volutsia - 5-19-30 - #512 - E.L. Stewart
 Tap - 734 S. Estelle - 4-27-37 - #179 - Frederick Pibg. Co.
 Tap - 2814 - 6435 Erie - 10-29-40 -
 Tap - 2822 E. Gilbert - 9-25-42 - Shellenberger (connected to house line)
 G on B wye - #2802 - 6118 Erie - 11-30-54 - Joe McDonald
 744 S. Estelle - 9-17-47 - #764 - Simmons Pbg. Co. (used old connection)
 8245 Tap 637 Erie by 10-11-58 2141
 B - 6012 Erie (anna) Bbg) 7-7-66 - Leo Buff - Tap (6+05.0)
 Tap # C37300 - 725 - 27 S. Erie - 2/20/73 - Gerald Thompson - Tap (3+36.3)