C284 A

LEAR JET SEWER
BUILT BY: WB CARTER CONST. CO.
PROJ. Nº 468-76-245-80507-000-000-008
BOOKED 5-4-78 FROM AR 7SS

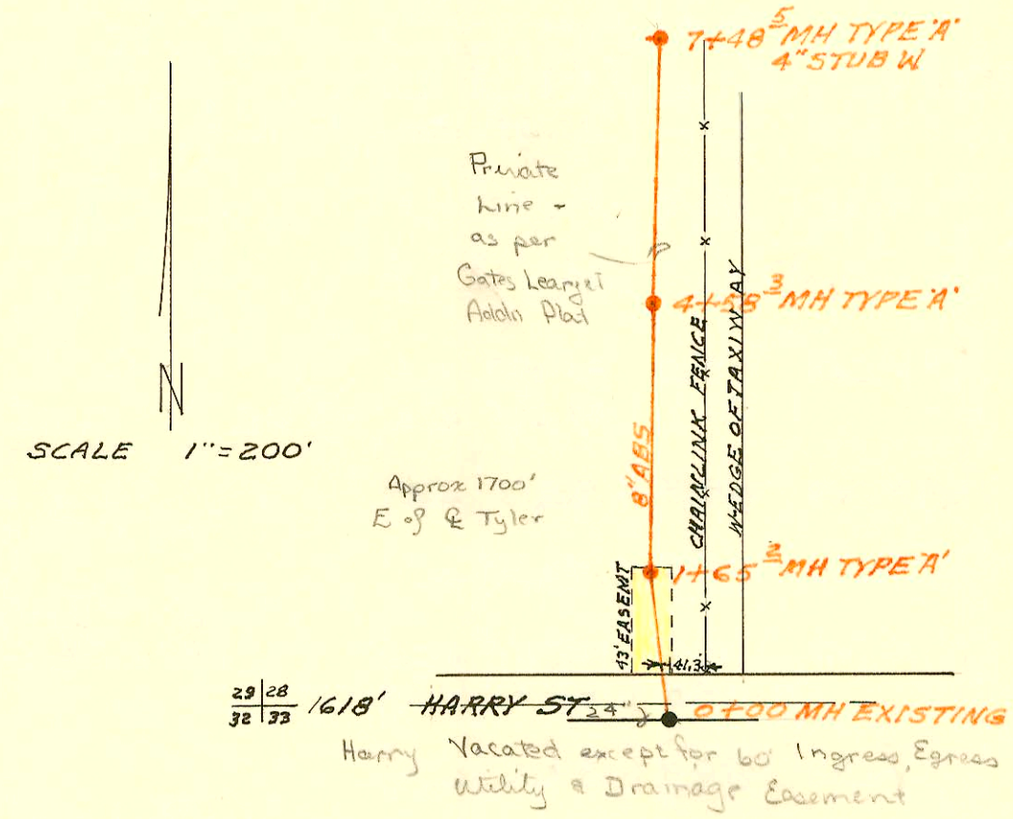

LATERAL 14 MAIN 16 WAR INDUSTRIES SEWER
BUILT BY: WB CARTER CONST. CO.
PROJ. Nº DBKL 577078
BOOKED 5-5-78 FROM SRL 5

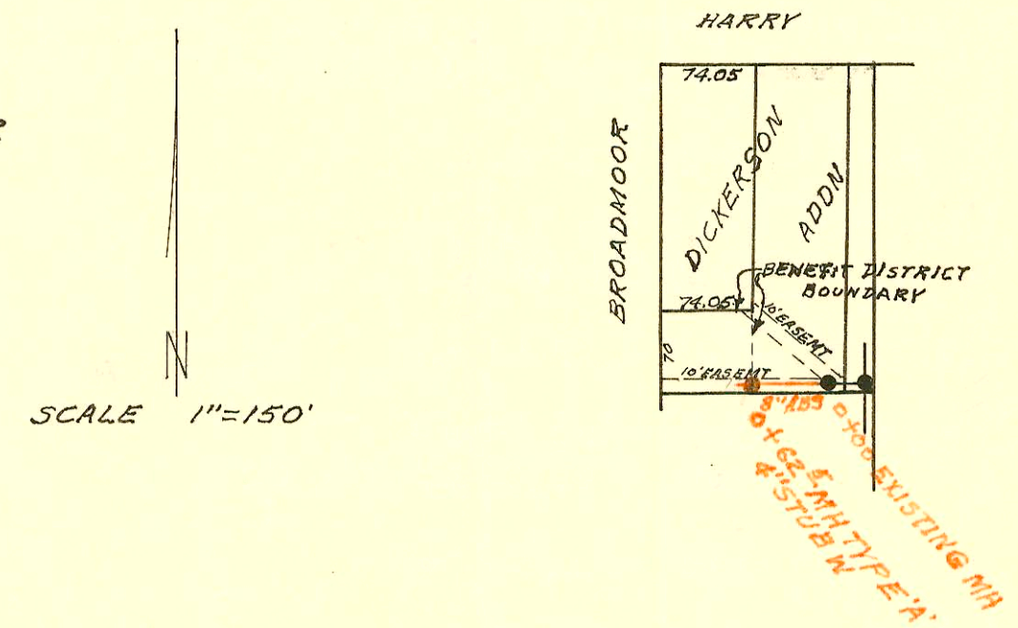

LATERAL 137 SANITARY SEWER Nº 22
BUILT BY: W.B. CARTER CONST. CO.
PROJ. Nº DBKL 577068
BOOKED 5-17-78 FROM CLG 13

SAN SEWER EXTENSION TO SW COR LOT 1
BLOCK 1 WEST WAREHOUSE ADDN.
BUILT BY: W.B. CARTER CONST. CO.
PROJ. Nº 468·76·245·80519·000·000·008
BOOKED 5-17-78 FROM CLG 13

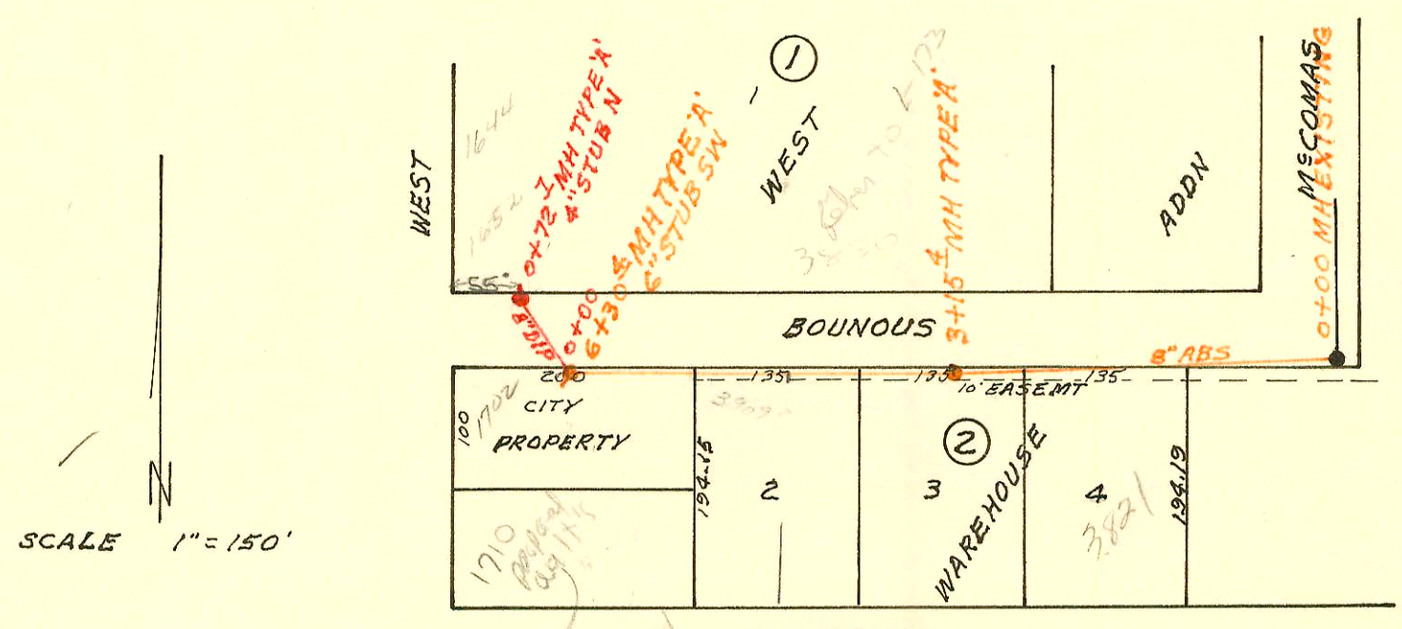

must extend city sewer adjacent in write up from plan check 6/4/93

C284

Form 42-020

CONSTRUCTION RECORD							SERVICE RECORD					
STATION	ELEVATION		Depth	MANHOLE	4-INCH "Y" BRANCHES		No. of Permit		House Number		DATE OF PERMITS	
	Ground	Grade			North West	South East	North West	South East	North West	South East	North West	South East
LEARJET SAN SEWER												
0+00	142.8	133.20	9.6	0+00 EXISTING								
1+00	143.2	133.58	9.6									
		OUT 133.83	9.4									
	143.2	IN 134.23	9.0	1+65.2								
2+00	143.3	134.75	8.6									
3+00	143.7	136.23	7.5									
4+00	143.9	137.71	6.2									
	143.9	138.58	5.3	4+58.3								
5+00	143.9	138.80	5.1		5+66.1		C76448		8220 W Harry		2-12-80	
6+00	144.1	139.31	4.8									
7+00	144.1	139.83	4.3									
	144.2	140.08	4.1	7+48.5	4"STUB W		C66127		8220 W Harry		4-27-79	
LATERAL 14 MAIN 16 WAR INDUSTRIES SEWER												
0+00	158.2	150.12	8.1	0+00 EXISTING								
	156.7	150.40	6.3	0+62.5	4"STUB W		C66400		1616 So Broadmoor		5-12-78	
LATERAL 137 SANITARY SEWER Nº22												
0+00	111.3	105.64	5.7	0+00 EXISTING								
1+00	110.9	105.81	5.1									
2+00	110.2	105.97	4.2		2+28.9		9510		3821 Bonnie		10-26-83	
3+00	110.0	106.14	3.9									
	111.2	106.17	5.0	3+15.4								
4+00	110.7	106.31	4.4			4+54.2		C74742	3909 Bonnie		10-9-79	
5+00	110.6	106.48	4.1									
6+00	110.7	106.64	4.1									
	110.9	106.69	4.2	6+30.4		6"STUB SW		C65872	1702 S West		4-12-78	
SAN SEWER EXTENSION TO SW COR LT1 BLK1 WEST WAREHOUSE ADDN												
0+00	110.9	106.82	4.1	0+00 EXISTING								
					m.h. stub N.		266246		1644 S. West		5-5-78	
	110.67	107.00	3.7	0+72.7	4"STUB N		266248		1652 S. West		5-5-78	