C299A

LATERAL 37 MAIN 5 SAN SEWER Nº 23
BUILT BY: UTILITY CONTR. INC.
PROJ. Nº 468-76-245-80445-000-000-001
BOOKED 10-30-78 AR 8 SWS

on map

LATERAL 9 SUBMAIN 5 SAN SEWER Nº 23
BUILT BY: UTILITY CONTR. INC.
PROJ. Nº DBKL566038
BOOKED 10-31-78 AR 8 SWS

on map
11-38

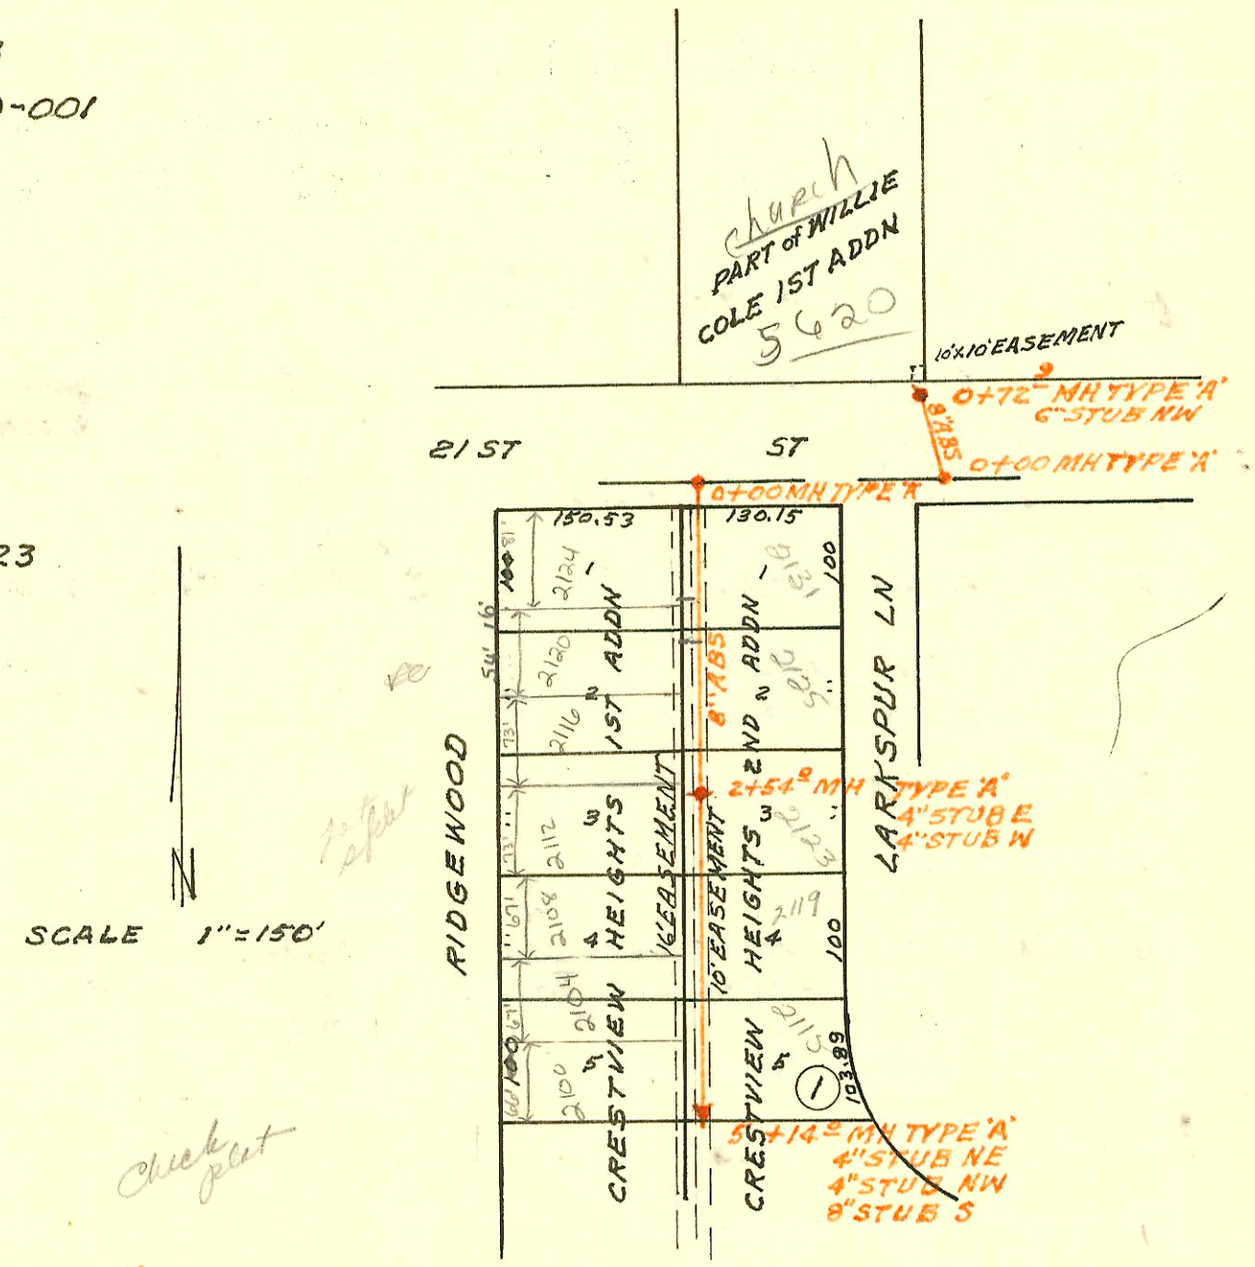

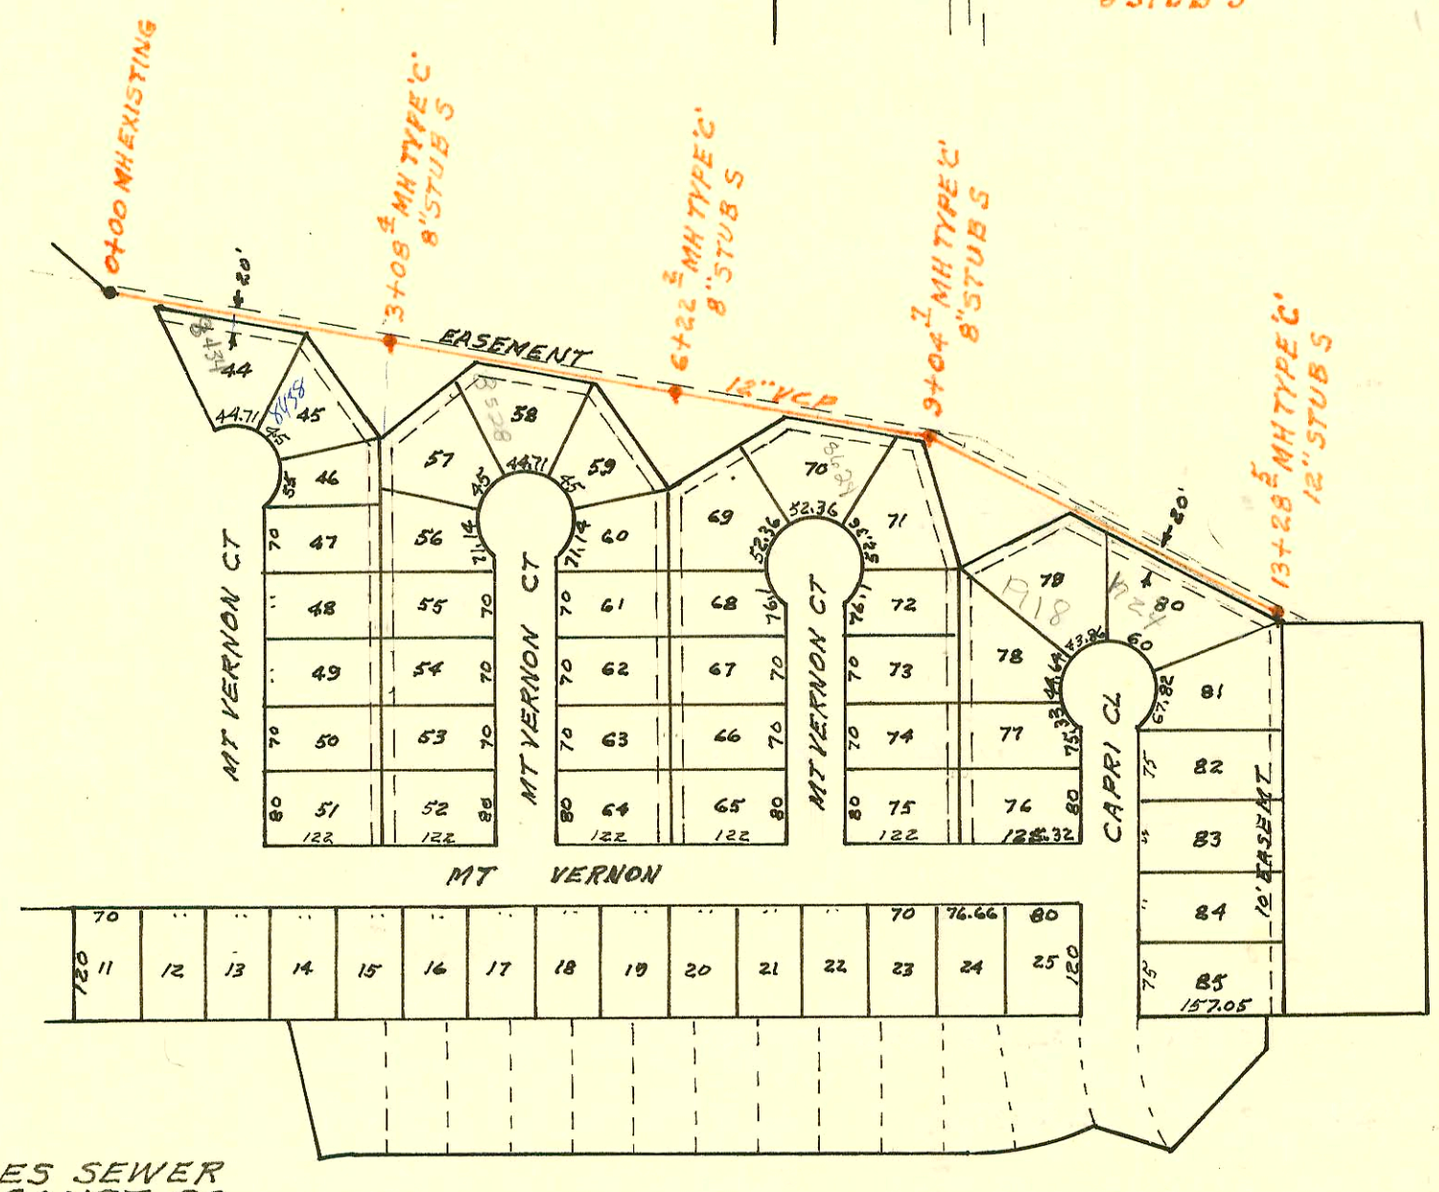

MAIN 21 WAR INDUSTRIES SEWER
BUILT BY: MID STATES CONST. CO.
PROJ. Nº DBKM575019
BOOKED 11-1-78 FROM AR 8 SWS

on map

7-6-78

4315 Bernita

Before permit may be issued Reesar will have to contact Steve Innes of the Health Dept. He can supply the necessary information on mahod of draining the pool and what is required

Approved for pool permit 7-17-78

C299

Form 42-020

CONSTRUCTION RECORD							SERVICE RECORD					
STATION	ELEVATION		Depth	MANHOLE	4-INCH "Y" BRANCHES		No. of Permit		House Number		DATE OF PERMITS	
	Ground	Grade			North West	South East	North West	South East	North West	South East	North West	South East
LATERAL 37 MAIN 5 SAN SEWER Nº 23												
0+00	204.7	196.99	7.7	0+00								
	205.0	197.43	7.6	0+72.9	6" STUB NW		817178 9/21/87		5620 E 21st N 5620 (add'y) E 21st N (conn)		C67717 19103	
LATERAL 9 SUBMAIN 5 SAN SEWER Nº 23												
0+00	208.8	201.90	6.9	0+00	RISERS 0+30 W	RISERS 0+50 E		15317		2131 Larkspur		12-24-85
1+00	211.6	202.30	9.3		4" SDR 35 ~~1+30 W~~ 0+96 1+26.0	~~1+35 E~~ 1+38.0	94-4904-7 94162907	12804	2124 N Ridgewood 2120 Ridgewood	2125 Larkspur	3-29-94 10-7-94	12-12-84
2+00	213.8 214.5	202.70 OUT 202.92 IN	11.1 11.6	2+54.0	4" STUB W 2+90 W	4" STUB E	2001-01164 2001-01163 15448	12805	2116 Ridgewood 2112 Ridgewood 2108 Ridgewood	2123 Larkspur	5-11-01 5-11-01 1-14-86	12-12-84
3+00	214.9	203.10	11.8			3+72.4 tap		C68190		2119 Larkspur		9-1-78
4+00	213.8	203.50	10.3		4+37.6 tap		3379		2104 Ridgewood		5-28-81	
5+00	215.2 215.3	203.90 203.96	11.3 11.3	5+14.0	5+08.4 tap 4" STUB NW 4" MH Tap	8" STUB S 4" STUB NE	282	C75726	2100 Ridgewood	2115 Larkspur	5-12-80	12-14-79
MAIN 21 WAR INDUSTRIES SEWER												
0+00	151.3	138.83	13.0	0+00 EXISTING								
1+00	152.3	138.83	13.5			1+53.4 tap		C75121		8434 Mt. Vernon Ct		10-31-79
2+00	152.8	139.33	13.5									
3+00	151.9 152.1	139.83 139.87	12.1 12.2	3+08.4		8" STUB S						
4+00	153.7	140.33	13.4			4+44.4 tap		3085		8528 Mt. Vernon Ct		4-8-81
5+00	152.4	140.83	11.6									
6+00	152.2 152.6	141.33 141.44	10.9 11.2	6+22.2		8" STUB S						
7+00	154.1	141.83	12.3			7+83.1 tap		7439		8628 E Mt. Vernon Ct		1-26-83
8+00	154.5	142.33	12.2									
9+00	156.1 156.3	142.83 142.85 142.96	13.3 13.5 13.3	9+04.7		8" STUB S						
10+00	156.5	143.43	13.1									
11+00	157.3	143.93	13.4			11+73.5 TAP		22580		1918 Capri Ct		2-17-81
12+00	158.0	144.43	13.6					9160		1924 Capri Ct		9-12-83
13+00	153.0 157.7	144.93 145.07	8.1 12.6	13+28.5		12" STUB S						

5620 E 21st - permit # C67717 - NW - Ran 88' of 4" PVC tile from 4" stub in MH 0+72.9. 1st 60' ¼" fall last 28' less than ¼" fall.

permit # 19103 - New Con - Tied into existing 4" clay tile line 60' from wye to serve new add.