


S.S. No. 20
MAIN

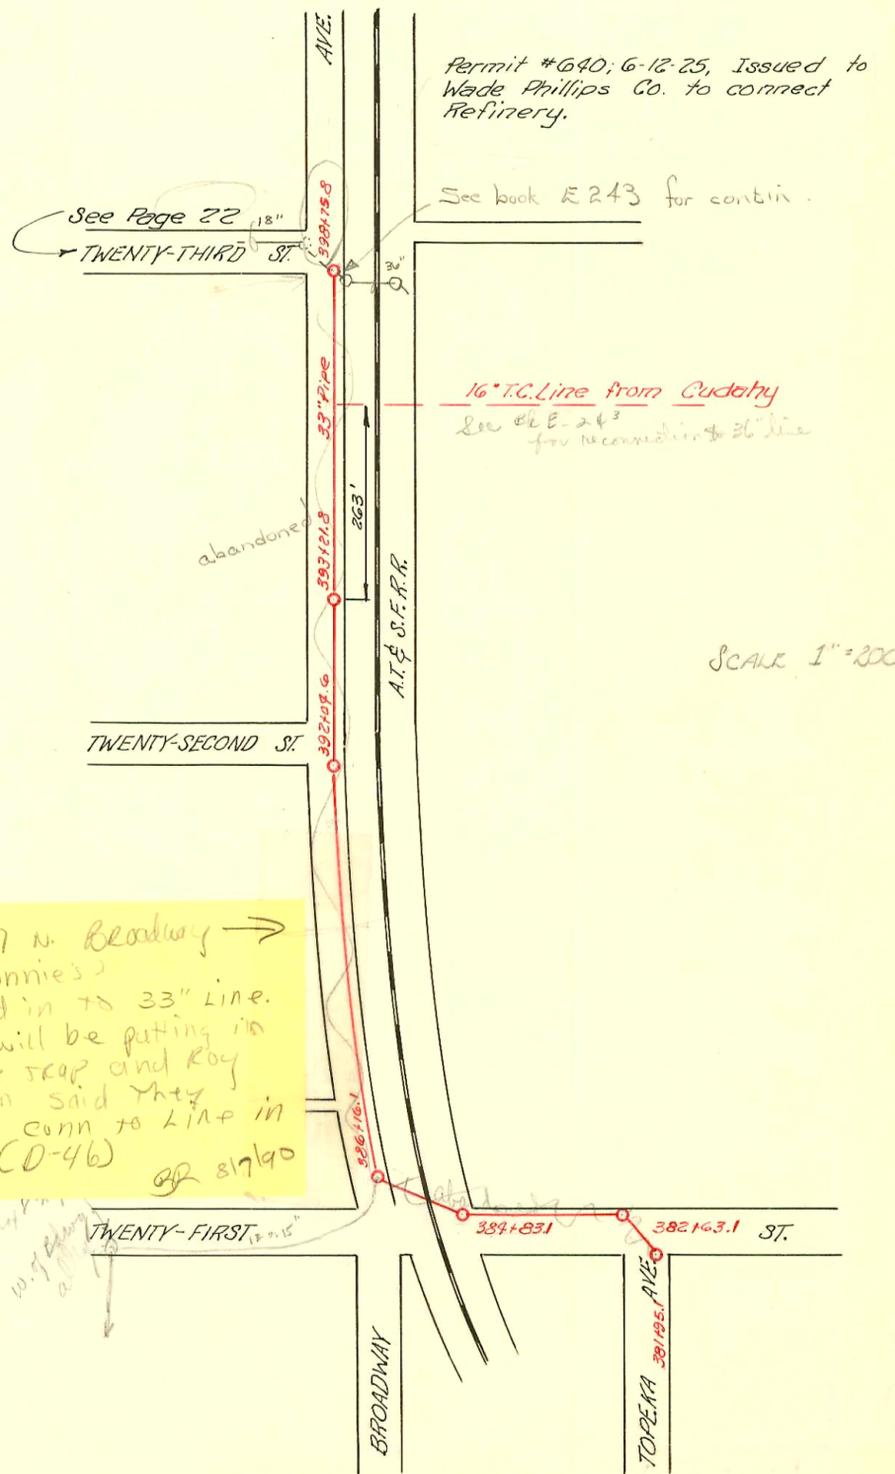

2227 N. Broadway →
(Connie's)
Tapped in to 33" line.
They will be putting in
grease trap and Roy
Griffin said they
must conn to line in
rear (D-46) 8/17/90

