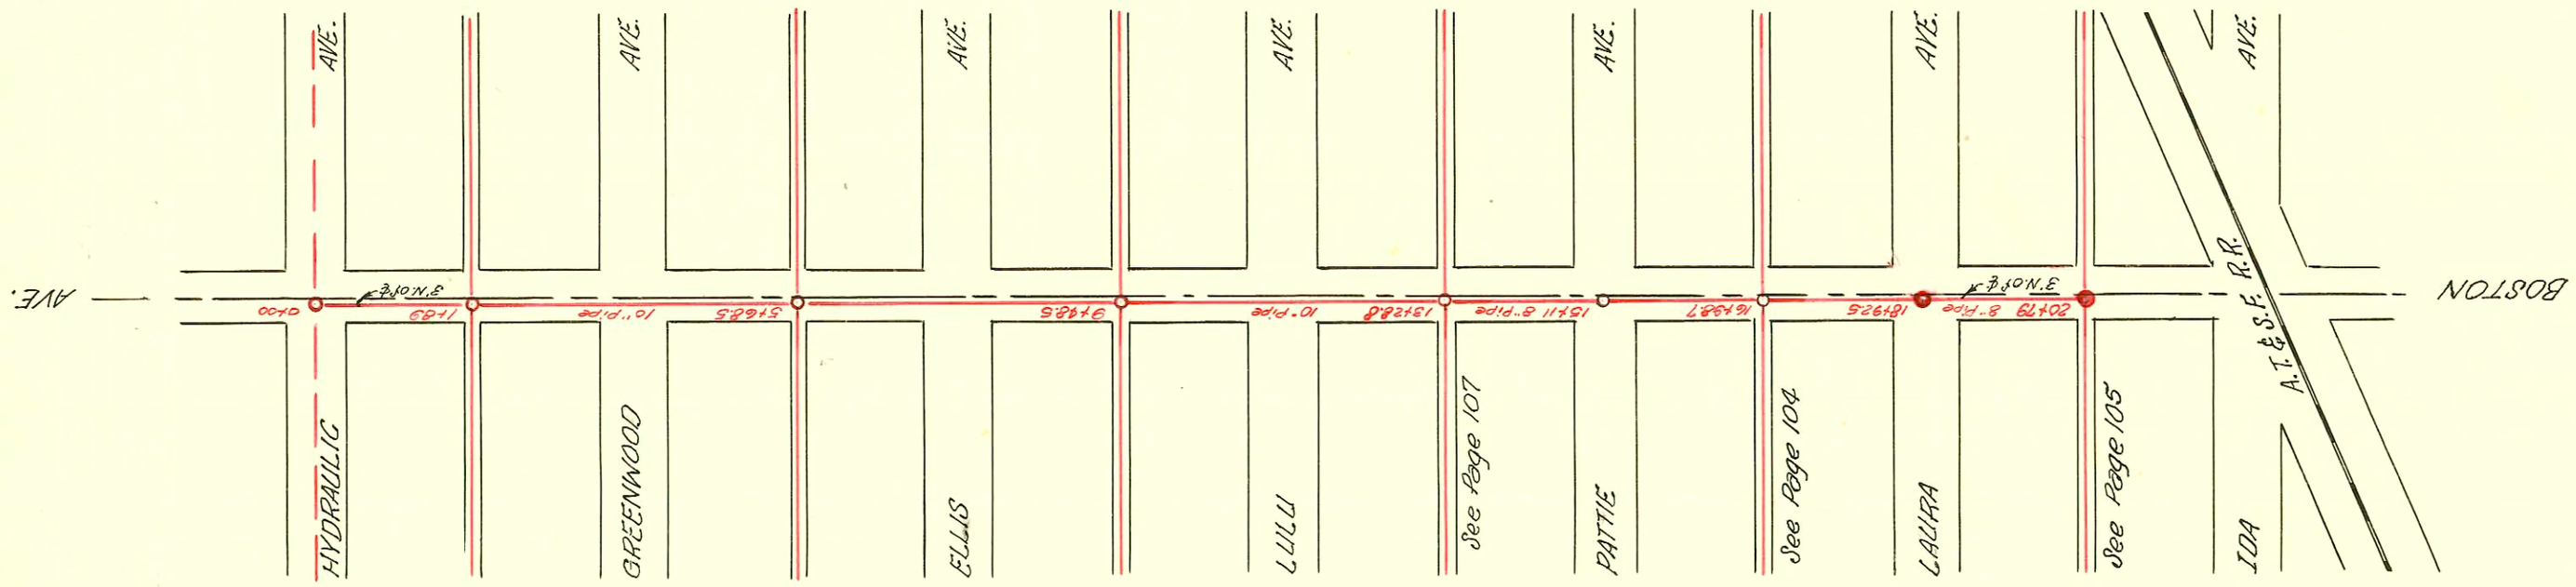
AVE.
BOSTON
3 N.of ℄
1+89
0+00
10" Pipe
5+68.5
9+98.5
10" Pipe
13+24.8
15+11 8" Pipe
16+98.7
18+92.5
20+79 8" Pipe
HYDRAULIC
GREENWOOD
ELLIS
LILLI
See Page 107
PATTIE
See Page 104
LAURA
See Page 105
IDA
A.T.&S.F. R.R.

D-18

Form 41-(54) 8-53

CONSTRUCTION RECORD							SERVICE RECORD					
STATION	ELEVATION		Depth	MANHOLE	4-INCH "Y" BRANCHES		No. of Permit		House Number		DATE OF PERMITS	
	Ground	Grade			North West	South East	North West	South East	North West	South East	North West	South East
0+00	102.35	94.17	8.18	0+00								
1	102.33	94.27	8.06									
	101.90	94.36	7.54	+89								
2	101.90	94.37	7.53									
3	101.83	94.47	7.36									
4	102.03	94.57	7.46									
5	102.31	94.67	7.64									
		94.74 94.90		+68.5	12" Pipe E.	10" Pipe W.						
6	102.23	94.95	7.28									
7	102.53	95.05	7.48									
8	102.53	95.15	7.38									
9	102.72	95.25	7.47									
	102.69	95.30	7.39	+48.5								
10	102.77	95.35	7.42									
11	101.99	95.45	6.54									
12	101.57	95.55	6.02									
13	102.22	95.64	6.58									
	101.91	95.66	6.25	+28.8	10" Pipe E.	8" Pipe W.						
14	101.61	95.90	5.71									
15	101.53	96.00	5.53									
	101.53±	96.00	5.53	+11								
16	102.00	96.10	5.90									
	100.72	96.20	4.52	+98.7								
18	100.65	96.30	4.35									
	101.01±	96.39	4.62	+92.5								
19	101.01	96.40	4.61									
20	101.12	96.50	4.62									
	102.08	96.58	5.50	+79								