S. S. No. 20
SUB. MAIN R, SEC. A

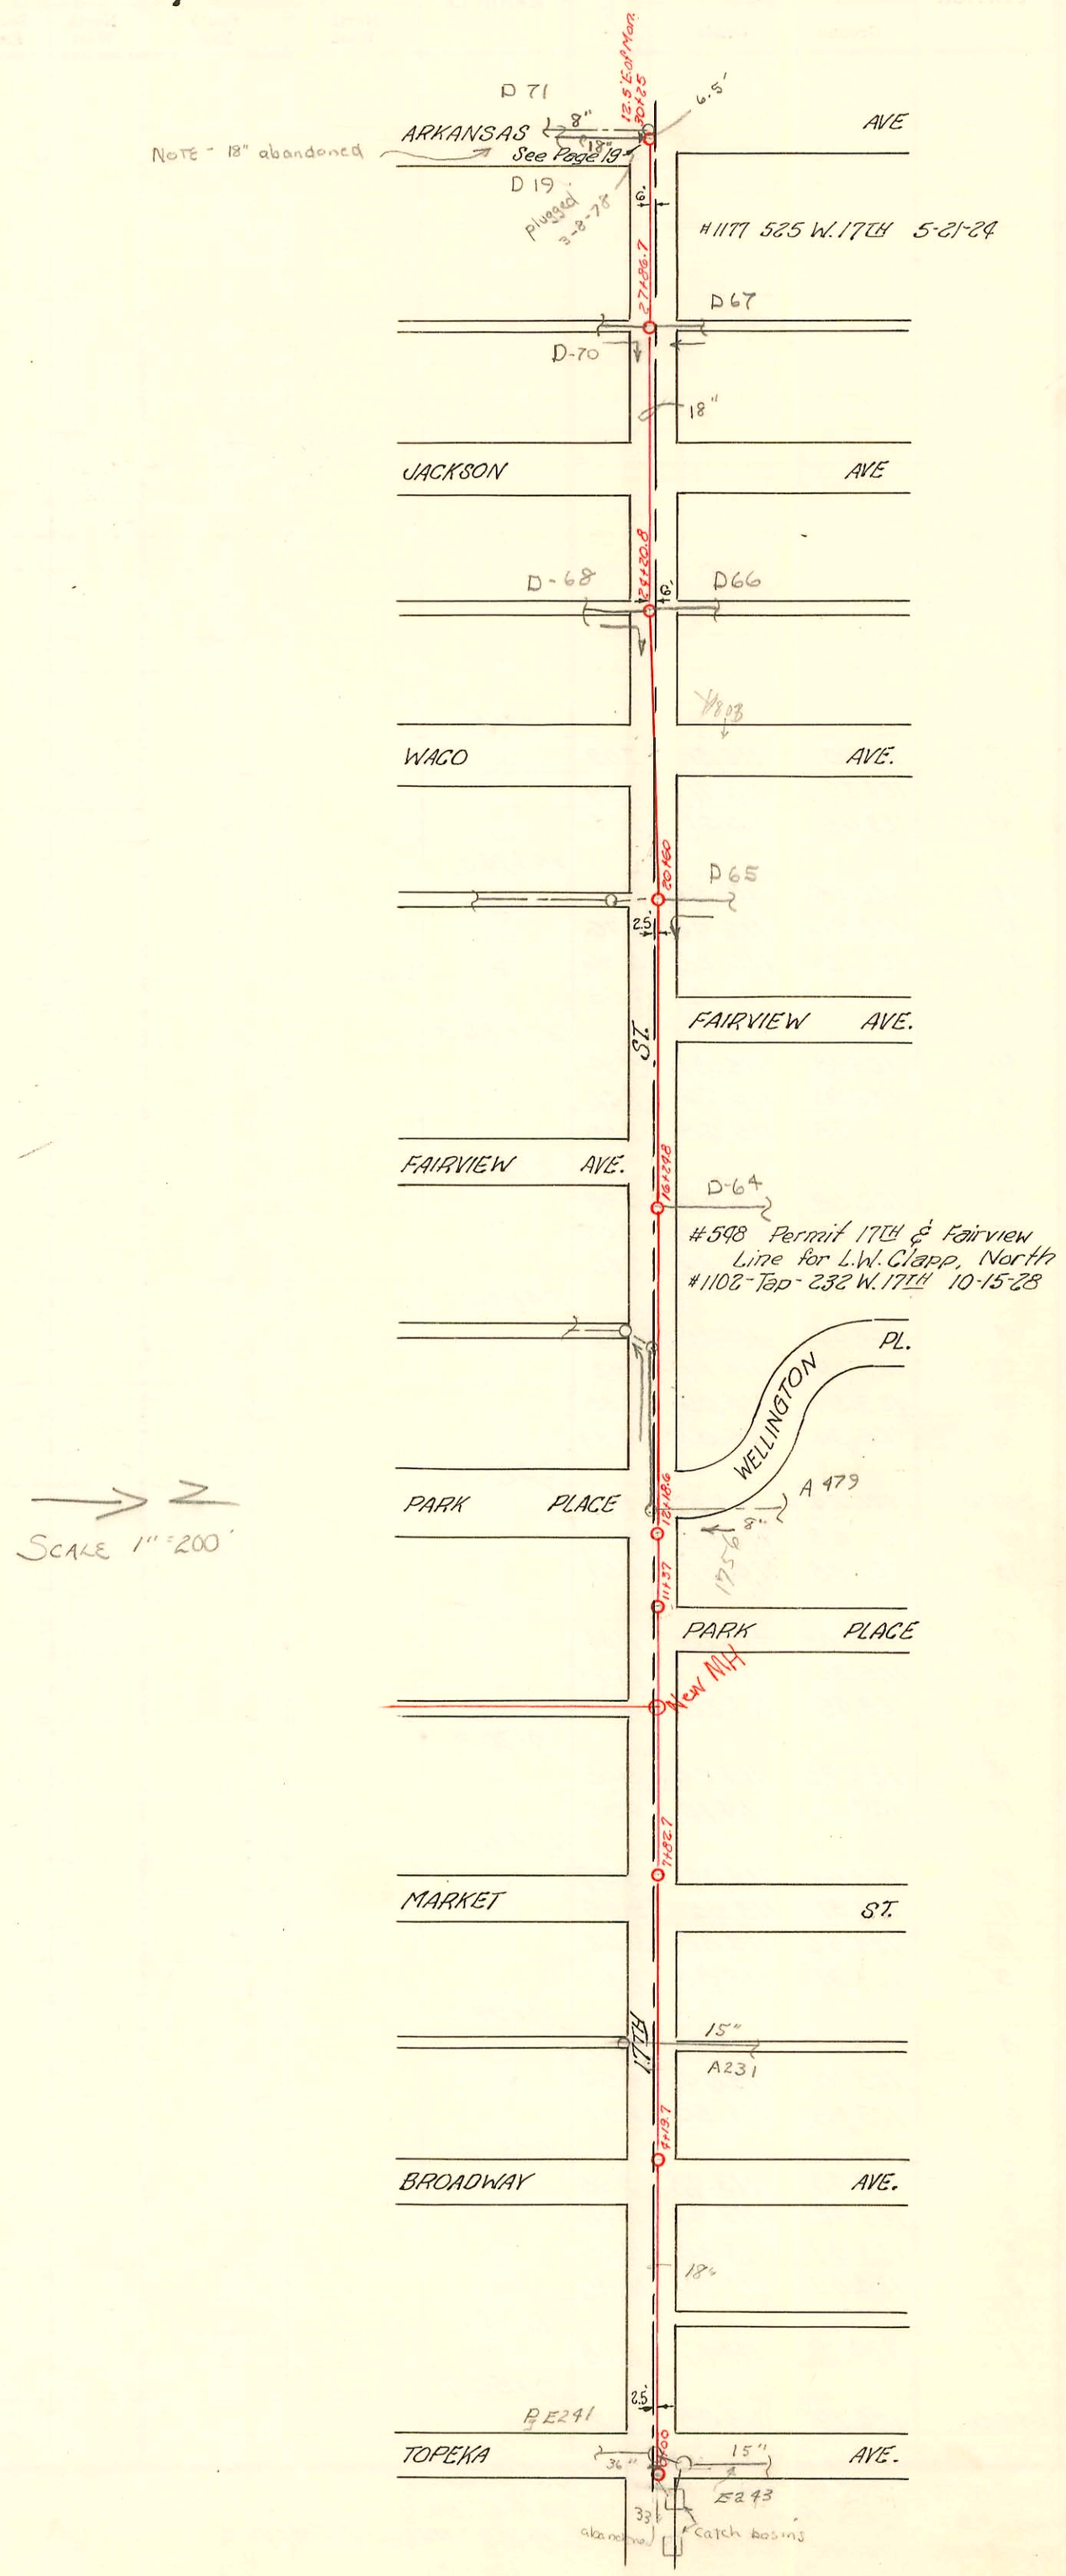

#18 Tap 230 W. 17TH 1-14-29
#3360 Tap 123 E. 17TH 4-22-41 H.U. Gerle (Tapped at 9+26.1)

D-21

Form 41-(54) 8-53

CONSTRUCTION RECORD							SERVICE RECORD					
STATION	ELEVATION		Depth	MANHOLE	4-INCH "Y" BRANCHES		No. of Permit		House Number		DATE OF PERMITS	
	Ground	Grade			North West	South East	North West	South East	North West	South East	North West	South East