D 22 A

S.S. No. 20
SUB. MAIN T

SYPHON ACROSS MASCOT
BUILT BY: URA
PROJ Nº A51 WACO-FINN
PHASE II PT I
BOOKED 9-28-77 AS BUILT PLAN

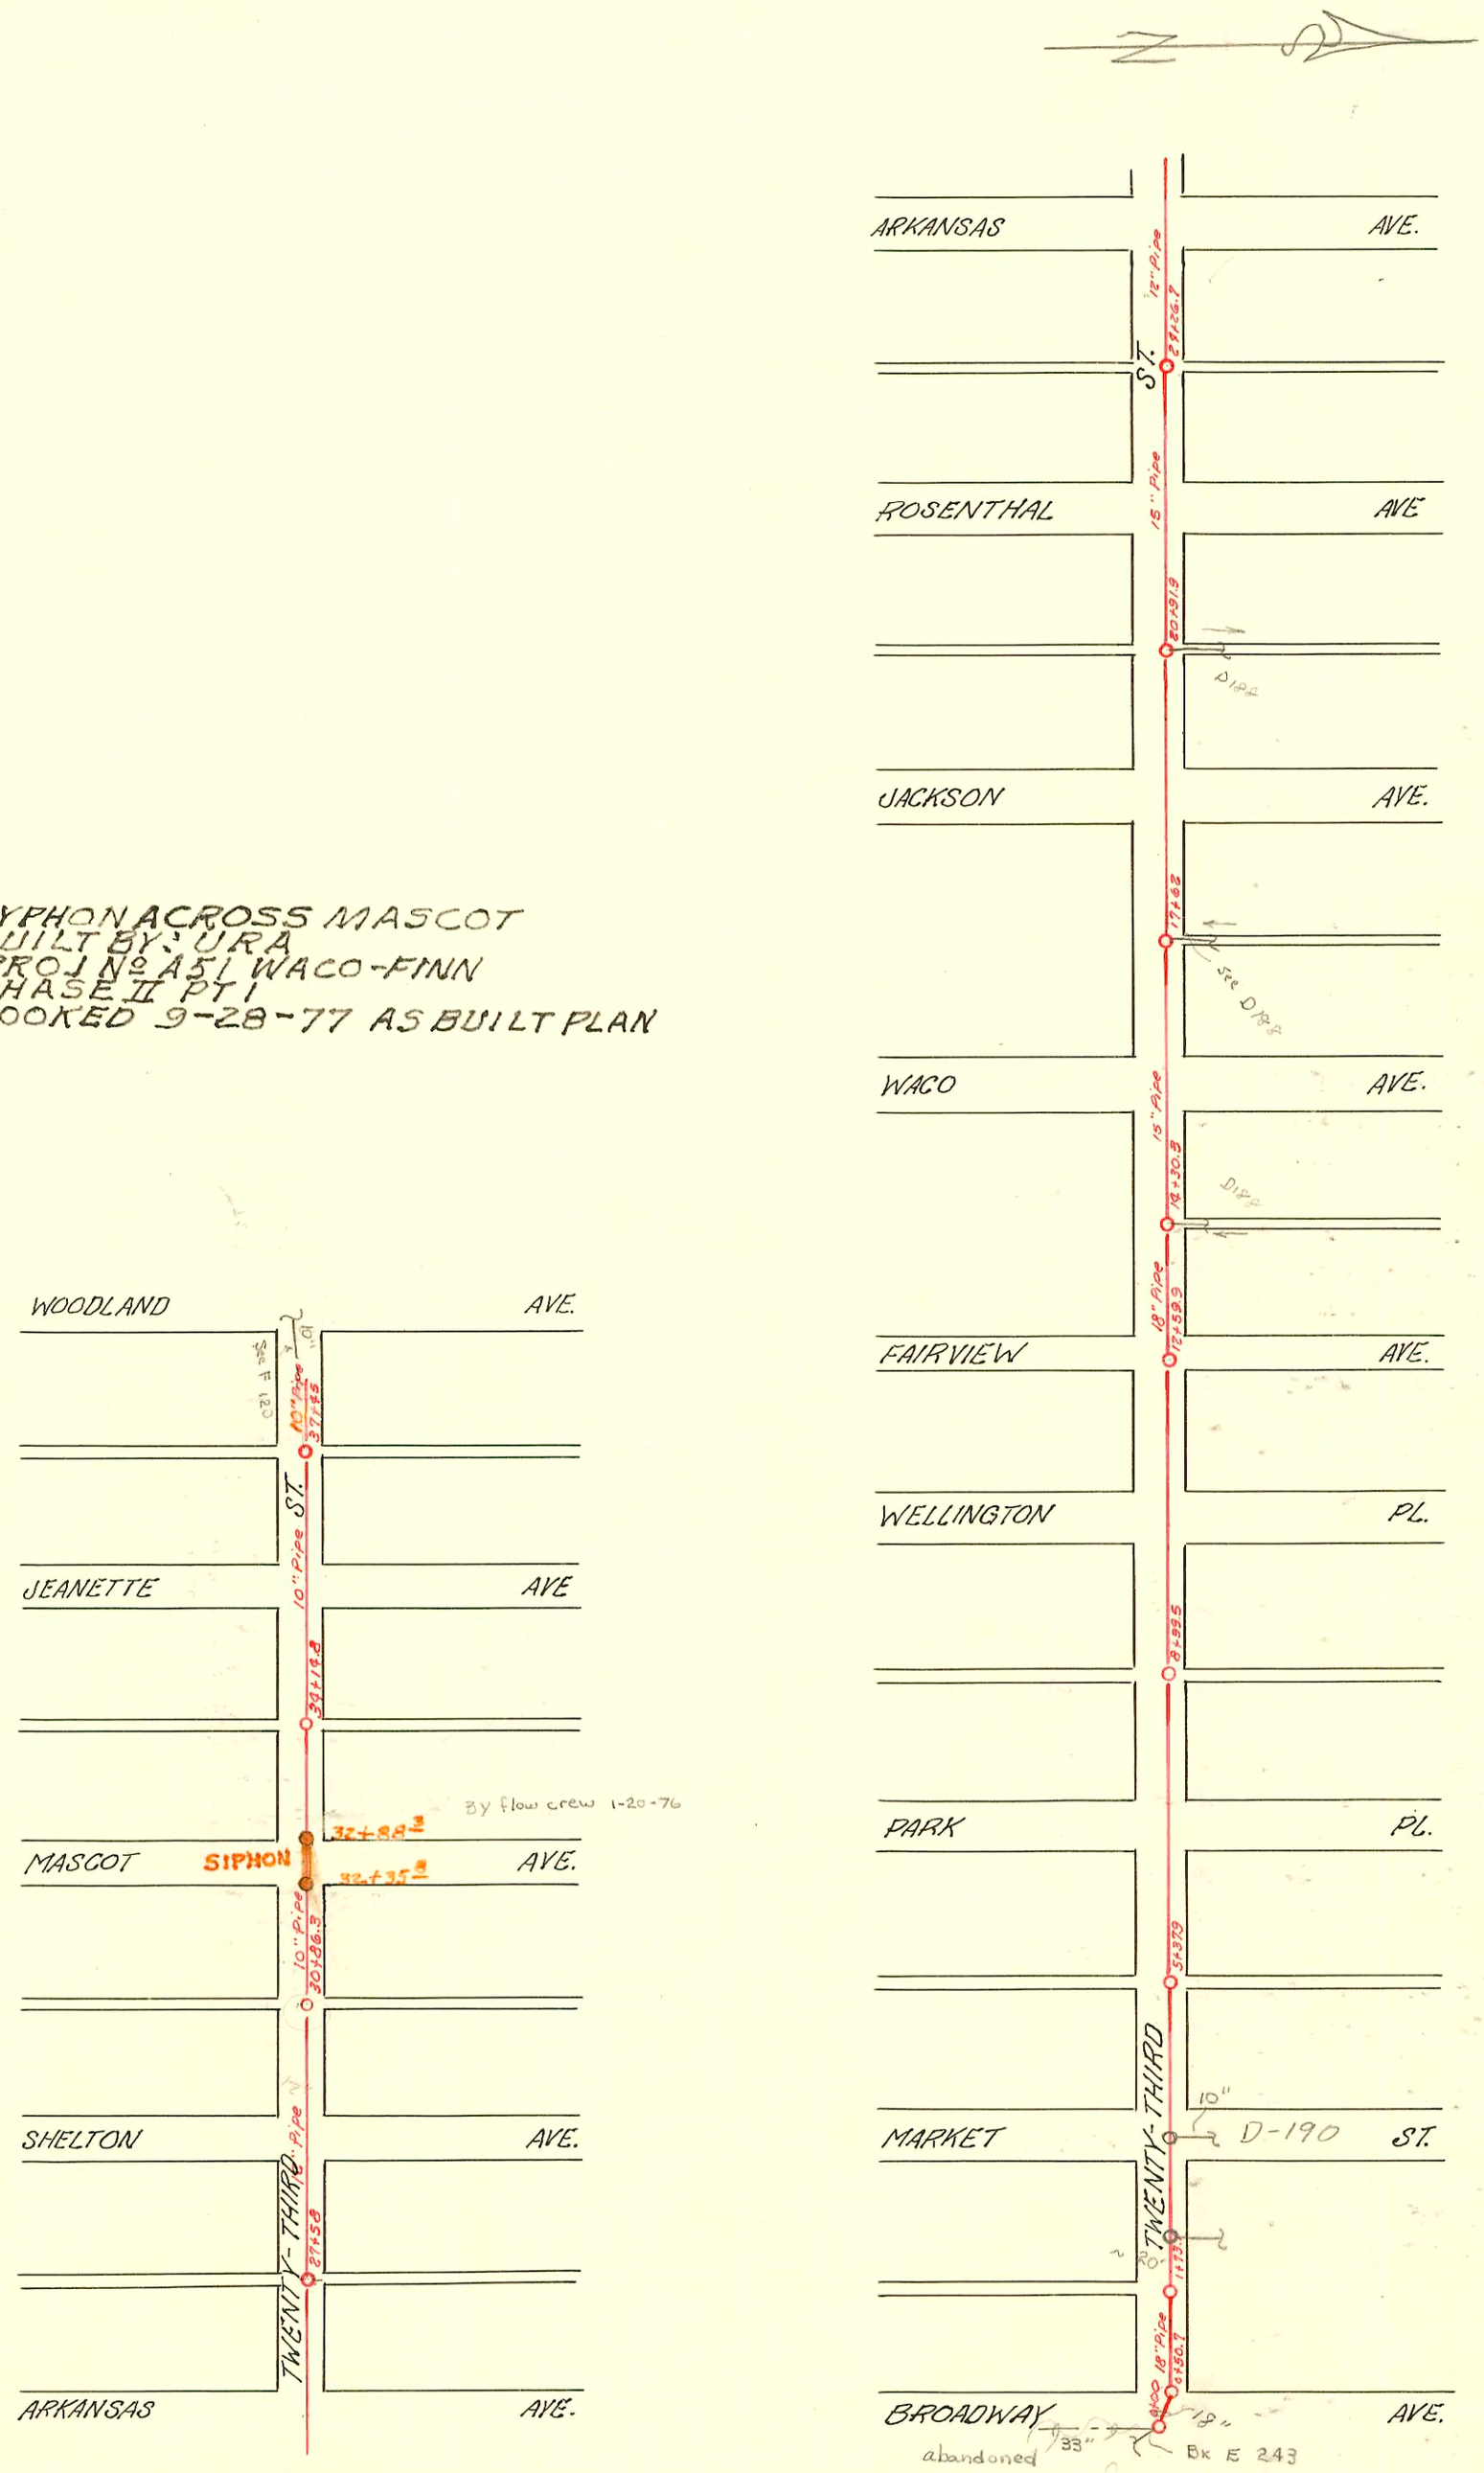

D-22

Form 41-(54) 8-53

CONSTRUCTION RECORD							SERVICE RECORD					
STATION	ELEVATION		Depth	MANHOLE	4-INCH "Y" BRANCHES		No. of Permit		House Number		DATE OF PERMITS	
	Ground	Grade			North West	South East	North West	South East	North West	South East	North West	South East
				37+45								
37	123.90	116.81	7.09									
36	124.30	116.71	7.59									
35	123.65	116.61	7.04									
				34+14.8								
34	122.50	116.51	5.99									
33	122.56	116.40	6.16									
32	123.24	116.28	6.96	?	Siphon							
31	123.69	116.16	7.53									
				30+86.3								
30	123.18	115.84	7.34									
29	122.98	115.76	7.22									
28	122.73	115.68	7.05									
				27+58								
27	122.58	115.60	6.98									
26	122.59	115.52	7.07									
25	122.89	115.43	7.46									
				24+26.7								
24	122.84	115.25	7.59									
23	123.09	115.17	7.92									
22	123.94	115.09	8.85									
21	125.34	115.01	10.33									
				20+91.9								
20+50	126.24	114.97	11.27									
19	126.63	114.85	11.78									
18	126.38	114.77	11.61									
				17+62.0								
17	126.03	114.69	11.34									
16	125.30	114.61	10.69									
15	123.45	114.28	9.17									
				14+30.3								
14	123.85	114.20	9.65									
13	124.10	114.12	9.98									
				12+59.9								
12	123.61	114.04	9.57									
11	123.31	113.96	9.35									
10	123.56	113.88	9.68									
9	123.31	113.80	9.51									
				8+99.5								
8	123.61	113.72	9.89									
7	123.18	113.64	9.54									
6	123.53	113.56	9.97									
				5+37.9								
5	123.43	113.48	9.95									
4	123.42	113.40	10.02									
3	123.97	113.32	10.65									
2	124.09	113.24	10.85									
				1+73.1								
1	124.24	113.16	11.08									
				0+50.7								
0+00	124.29	113.08	11.21									

Tap #1232 202 W. 23RD 9-6-29 H.P. Dunaway
Tap #3 2401 Mascot 1-12-34 W.A. Gittrich
Tap #5312 Trailer 202 W. 23RD 5-22-53 Richard LaFoy