


DIST. G - S.S. NO 20
1919

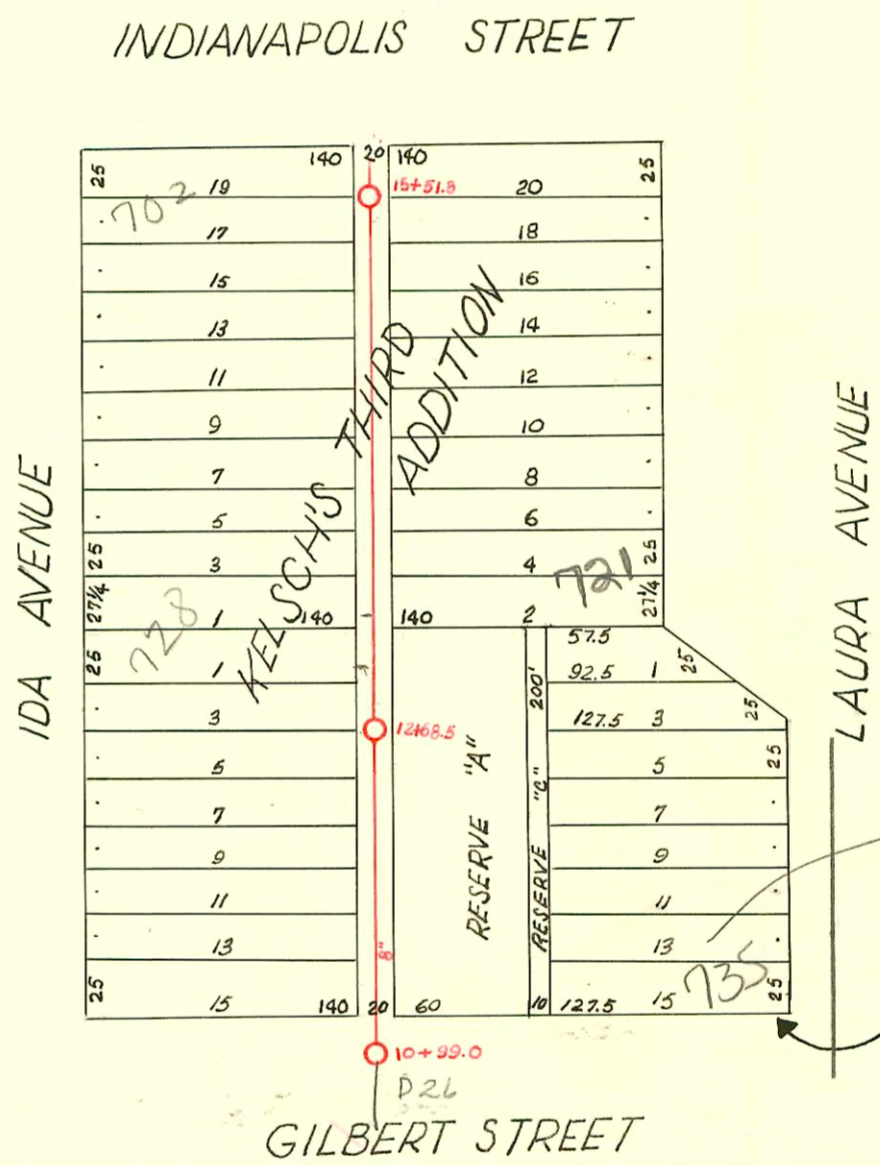

Continued from page 26

