


LAT. T - DIST. T - S.S. NO. 20
1919

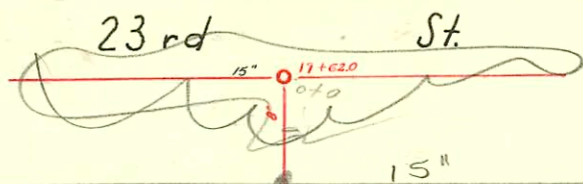

2358	277.4	2355
2356		
2354		
E.W. Banker		
2348		8
2346	2+09.9	
2331		165
Myers		Snyders
Outlots		
2336		
2334		Throckmorton
25	435	436
2331	433	434
2322	431	432
2321	429	430
2314	427	428
2312	425	426
2312	423	2319
2308	421	424
2308	419	422
2304	417	420
2304	415	418
2304	413	414

22nd St 6+151.0

25	131	131	25
411		2245	412
409		410	
407		408	
405		406	
403		404	
401		402	
399		400	
397		398	
395		396	
393		394	
391		392	
389		390	
1		2	
3		4	
5		6	
7		8	
9		10	
11		12	
13		14	
15		16	
17		18	
19		20	
21		22	
23	131	131	25

21st St

Jackson Waco

CONSTRUCTION RECORD							SERVICE RECORD					
STATION	ELEVATION		Depth	MANHOLE	4-INCH "Y" BRANCHES		No. of Permit		House Number		DATE OF PERMITS	
	Ground	Grade			North West	South East	North West	South East	North West	South East	North West	South East
0+0	126.05	116.24	9.81	0+0	+40.5	+43.0	#629		2358 2356 Jackson			6-10-25
					+66.0	+68.5	#2025	#1080	2356 Jackson	2345 N. Waco	10-1-25	9-8-24
					+91.7	+94.2	#1122	#1180	2354 Jackson	2351 N. Waco	10-12-25	8-8-25
1	126.85	116.39	10.46	1	+16.5	+19.0	#263		2342 Jackson			3-24-25
					+41.7	+44.2	#646		2319 W. 23rd			7-28-26
					+68.0	+70.5	#1911		2340 Jackson			8-21-24
					+93.0	+95.5	#39214	#1330	2338 Jackson	2345 N. Waco	5-25-73	6-7-24
2	127.15	116.54	10.61	2	+09.9	+17.8	#1089	#1329	2346 Jackson	2343 N. Waco	9-2-24	12-13-71 6-7-24
		116.55			+43.0	+45.5	#2158	#2026	2334 Jackson	2341 N. Waco	9-22-24	9-8-24
					+69.3	+71.8	#924		2347 N. Waco			4-23-24
					+93.3	+95.8	#2051	#929	2336 Jackson	2337 N. Waco	12-20-39	11-1-26
3	127.35	116.69	10.66	3	+18.6	+21.1	#1242	#352	2330 Jackson	2321 N. Waco	8-28-72	11-13-25 3-3-24
					+44.0	+46.5						
					+69.3	+71.8						
					+94.3	+96.8		#107		2325 N. Waco		2-15-22
4	126.60	116.84	9.76	4	+20.0	+22.5	#2786	#106	2320 Jackson	2321 N. Waco	10-20-50	11-14-94 2-15-22
		116.91			+42.0	+44.5	#1167	#959	2315 N. Waco	2314 N. Waco	10-23-25	6-28-23
					+46.1	+49.4	#1912	#34545	2312 Jackson	2319 N. Waco	8-21-24	8-28-72
5	124.98	116.99	7.99	5	+21.0	+23.5	#386		2311 N. Waco			8-28-72 3-4-24
					+46.2	+48.7	#1838	#34540	2308 Jackson	2307 N. Waco	8-12-24	8-28-72
					+71.8	+74.3	#1881	#839	2304 Jackson	2303 N. Waco	9-18-24	4-15-24
					+95.3	+97.8		#505				5-15-22
6	123.53	117.14	6.39	6	+21.4	+23.9						
		117.24			+67.0	+70.0						
7	122.89	117.29	5.60	7	+02.7	+05.2	#277	#558	215 W. 22nd N. Waco	2245 N. Waco	4-12-26	10-9-90 3-25-24
					+27.9	+30.4	#278	17357	2254 Jackson	2243 N. Waco	4-12-26	7-3-63
					+50.7	+53.2	#279		2250 Jackson		4-12-26	
8	122.41	117.44	4.97	8	+01.3	+03.8	#1986	#2353	2246 Jackson	2241 N. Waco	7-2-24	10-17-24
					+26.0	+28.5	#1987		2244 Jackson		9-2-24	
					+51.7	+54.2		#2494		2239 N. Waco		11-6-24
		117.57			+76.8	+79.3						
9	122.11	117.59	4.52	9	+01.8	+04.3	#2006		2240 Jackson		9-4-24	
					+26.8	+29.3	#2648		2234 Jackson		6-17-58	
					+52.4	+54.9					11-3-24	
					+78.0	+80.5						
10	121.96	117.71	4.22	10	+04.3	+06.8	#2005		2232 Jackson		9-4-24	
					+29.5	+32.0	#666		2209 N. Waco			10-10-59 4-3-24
					+55.4	+57.9	#227		2221 N. Waco			6-7-46
					+81.4	+83.7	#1780		2230 Jackson		8-5-24	
11	121.82	117.89	3.93	11	+07.0	+09.5	#1923	#1040	2206 Jackson	2215 N. Waco	8-22-23	5-7-24
					+33.6	+36.1						
					+58.6	+61.1						
					+83.5	+86.0						
12	122.37	118.04	4.33	12	+08.3	+10.8	#1922	#996	2202 Jackson	2207 N. Waco	8-22-25	5-2-24
					+33.0	+35.5						
						+45.7						
						+66.0						
					88.6							

1999-01176 - 111579-2308 Jackson McClurgs - 4"sch40 Donut 120.8' N of MH 6+67 (5+46.2) 170 W. CO, 1V22, 1V45, 1 Fernco

C56008 - 2305 N Waco - 6-21-76

#3308 - Tapped at 11 + 72.1 - 416 W. 21st. - 4-14-41 - Chester Davidson

#127 - Tap - 22 03 N. Waco - 5-22-46 - LaFoy P/bg. Co.

#1862 - Used old connection - 400 W. 21st. - 1-5-49 - A. E. Vaughn

#3111 - Tap - 2225 N. Waco - 11-13-50 - Dermody P/bg. Co.

#464 - Tap 80' East of 17+62.0 - 5-28